



PREPARED FOR
BOB REMIAN

PLAT OF SURVEY


- OF -

Lot J2 of Addition to "J" to Country Club Estates, located in the
Village of Fontana-on-Geneva-Lake, Walworth County, Wisconsin.

PATHFINDER SURVEYING
(a NMB Company)
P.O BOX 322
LAKE GENEVA, WI. 53147
WWW.PATHFINDERSURVEYING.NET
262-248-8303

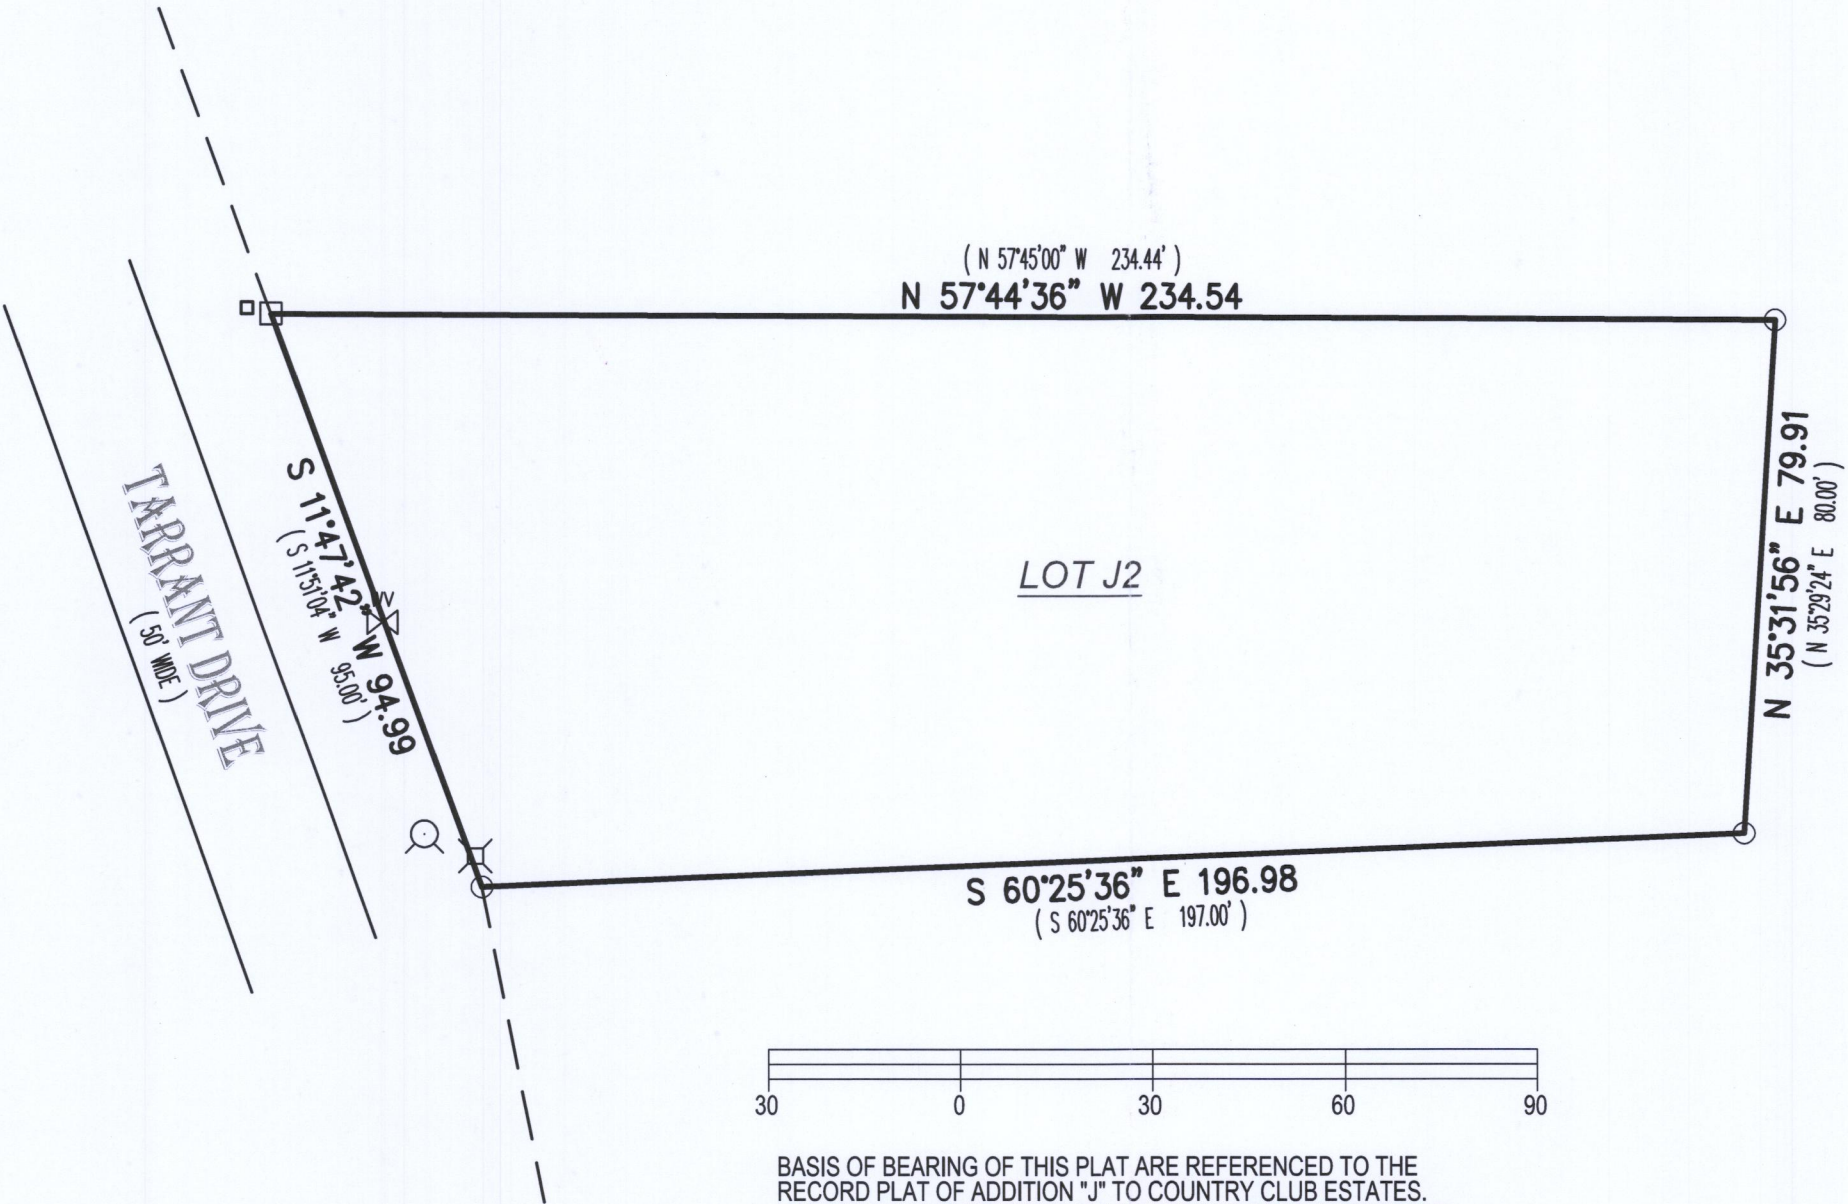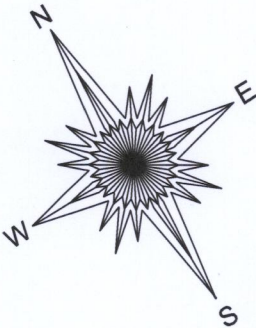

- () = recorded as
□ = found iron bar
○ = found iron pipe
⊕ = electric pedestal
□ = communication box
○ = hydrant
WV = water valve

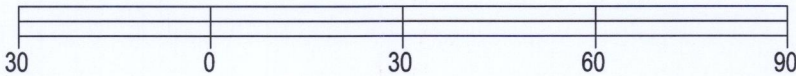


BASIS OF BEARING OF THIS PLAT ARE REFERENCED TO THE
RECORD PLAT OF ADDITION "J" TO COUNTRY CLUB ESTATES.
THE SOUTH LINE OF LOT J2 IS ASSUMED TO BEAR S 60°25'36" E.

I hereby certify that I have surveyed the above- described property and the
above map is a true representation thereof and shows the size and
location of the property, its exterior boundaries, the location and dimensions
of all structures thereon, fences, apparent easements and roadways and
visible encroachments if any to the best of my knowledge and belief.

This survey is made for the present owners of the property, and those who
purchase, mortgage, or guarantee the title thereto, within one year from the
date hereof.

DATED THIS 26TH DAY OF FEBRUARY, 2018.

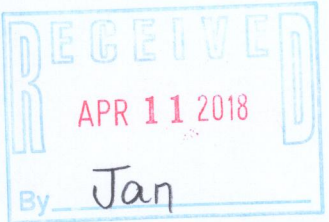

Mark R. Madsen
MARK R. MADSEN S - 2271
Wisconsin Professional Land Surveyor

SCALE 1" = 30'

JOB # 2018.0059.01

TAX ID # SCTJ 00002

SCTJ-2 005-3403