

Plat of Survey

Lots 22 and 23 of the subdivision of Block 6 of Indian Hills,


located in Government Lot 4 in the Southeast 1/4 of Section 14, Town 1 North, Range 16 East, Village of Fontana-on-Geneva Lake, Walworth County, Wisconsin.

Mark Niemaszek
532 Sioux Drive
Fontana, Wisconsin. 53125



Bearings referenced to the East line of the Southeast 1/4 of Section 14-1-16, recorded as N1°32'09"W in the Wisconsin State Plane Coordinate System, South Zone, (NAD-27).

Coordinates are referenced to the Wisconsin State Plane Coordinate System, South Zone, (NAD-27).

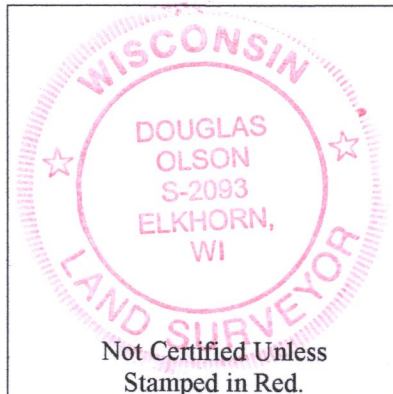


Notes:

- 1) This Plat of Survey is not certified unless signed and sealed in red ink.
- 2) This survey is subject to Wisconsin lien laws. This Plat of Survey is the notice of intent to file lien. Lien waiver required.
- 3) The Survey Date shown on this Plat of Survey is the completion date of the field work.

East 1/4 Corner
Section 14-1-16
N. 202,232.07
E. 2,388,019.00

recorded as N1°32'09"W 2658.38' State Plane
N1°32'09"W 2658.41'
East line of the Southeast 1/4 of Section 14-1-16

Southeast Corner
Section 14-1-16
N. 199,574.66
E. 2,388,090.25

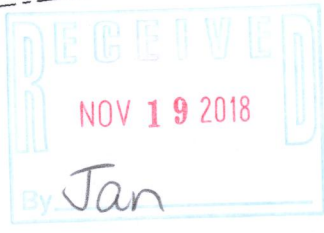

Copyright © 2018 by Olson Land Surveying, LLC.

All rights reserved. No part of this survey plat may be reproduced or transmitted in any form by any means - graphic, electronic, or mechanical, including photocopying, tracing, or information storage and retrieval systems - without permission in writing from Douglas G. Olson, Olson Land Surveying, LLC.

I hereby certify that I have surveyed the above described property in compliance with Chapter A-E 7 of the Wisconsin Administrative Code and that the map hereon is correct to the best of my professional knowledge and belief and shows the size and location of the property, its exterior boundaries, the location and dimensions of all visible structures thereon, boundary fences, apparent easements and roadways and visible encroachments, if any.

This survey is made for the exclusive use of the present owners of the property, and also those who purchase, mortgage or guarantee title thereto, within one year from the date hereof.

Douglas G. Olson
Wisconsin Professional Land Surveyor - 2093

Sheet 1 of 1 Sheets

Drawing Name:

Job Reference Number
2018.024

Legend of Symbols & Abbreviations

Found County Section Corner	N North
Found Iron Pipe	S South
Set Iron Pipe, 1" dia.	E East
Set Mag Nail	W West
Recorded Information	In Bearings
Utility Pole	Degrees
Manhole	Minutes
Catch Basin	Seconds
Water or Gas Valve	In Distances
Asphalt Surface	Feet
Concrete Surface	Inches
Stone Surface	

OLSON LAND SURVEYING, LLC

Rural | Residential | Commercial

45 South Wisconsin Street | P.O. Box 322
Elkhorn, Wisconsin. 53121
Telephone: (262) 723-3434
Facsimile: (262) 723-8044
Email: doug@olsonsurveying.com
Website: www.olsonsurveying.com

Scale in Feet
1" = 10'

0' 5' 10' 20' 30'

Survey Date: June 5, 2018.

Revisions:

2018.024

SIHB-15 005-3433