



PREPARED FOR  
BRIAN JAROSCH

PLAT OF SURVEY

- OF -

Lot 14 and 15, Block 14 Glenwood Springs, a Subdivision located in the Southeast 1/4 of Section 14, Township 1 North, Range 16 East, in the Village of Fontana-on-Geneva-Lake, Walworth County, Wisconsin.


PATHFINDER SURVEYING  
(a NMB Company)  
P.O BOX 322  
LAKE GENEVA, WI. 53147  
WWW.PATHFINDERSURVEYING.NET  
262-248-8303

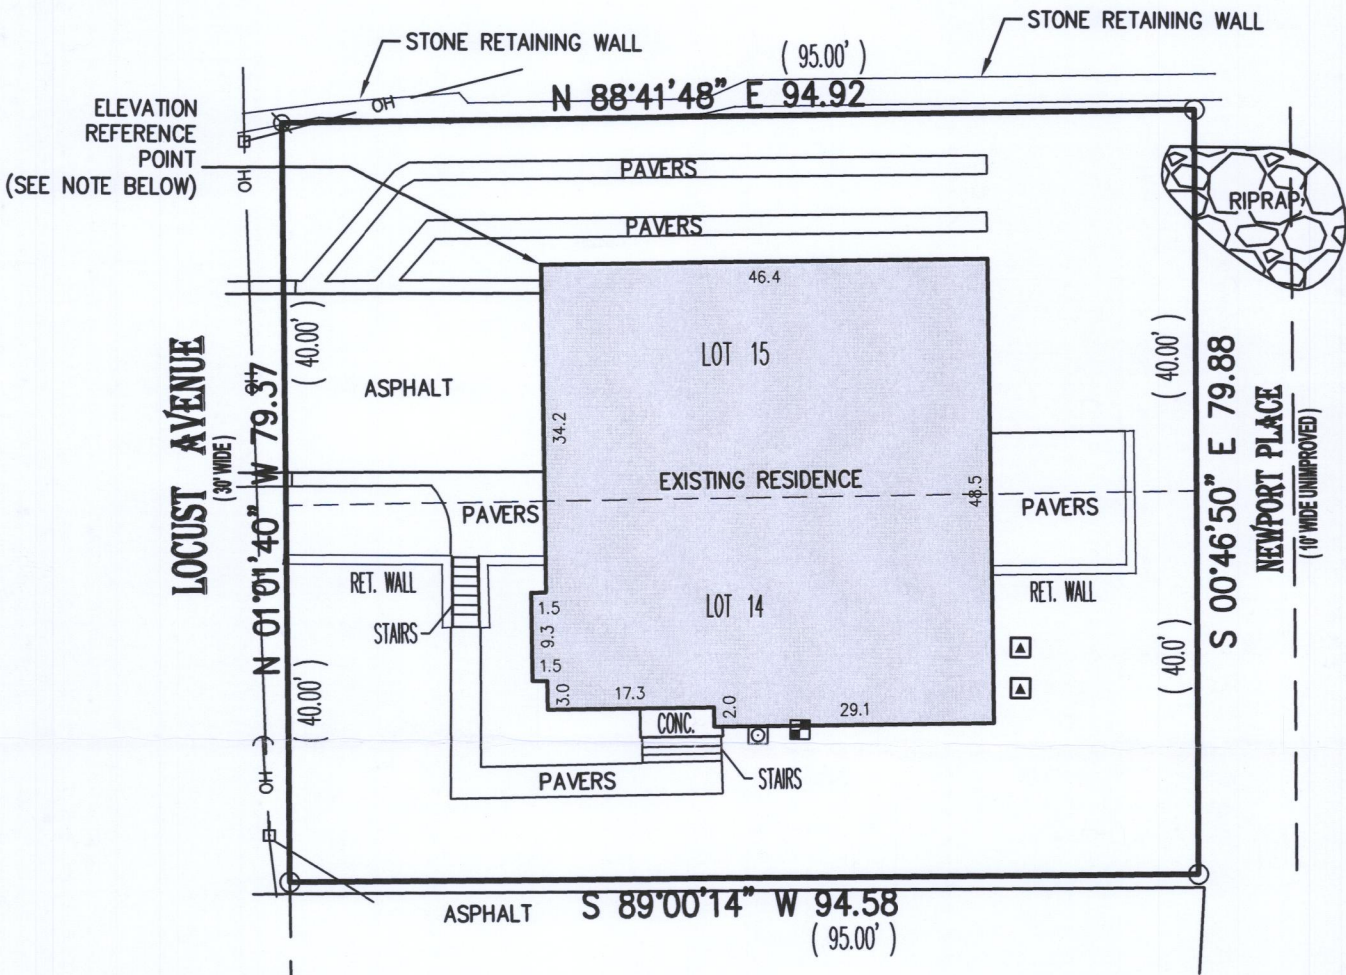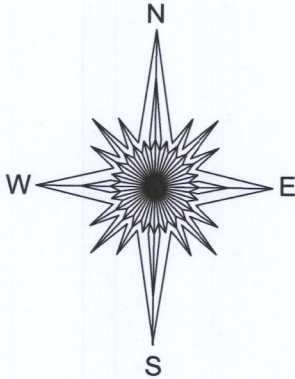

| Point of Reference | Elevation | Height |
|--------------------|-----------|--------|
| Ground             | 921.66    |        |
| Bottom of Facia    | 951.46    | 29.8'  |
| Peak of Roof       | 958.66    | 37.0'  |
| Mid Point          |           | 33.4'  |

| Description      | Area      | Percentage |
|------------------|-----------|------------|
| Lot Area         | 7546 s.f. | 100%       |
| Roof Surface     | 2227 s.f. | 29.5%      |
| Other Impervious | 1385 s.f. | 18.4%      |
| Green Space      | 3934 s.f. | 52.1%      |

- ( ) = recorded as
- = power pole
- = found iron pipe
- OH — = overhead wires
- = gas meter
- = guy wire
- = electric meter
- ▲ = hvac

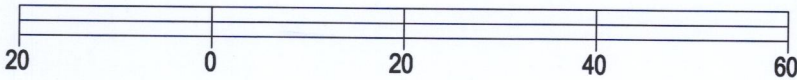

BASIS OF BEARING OF THIS PLAT: THE US STATE PLANE COORDINATE SYSTEM SOUTH ZONE, NAD 83. WISCORS.

I hereby certify that I have surveyed the above- described property and the above map is a true representation thereof and shows the size and location of the property, its exterior boundaries, the location and dimensions of all structures thereon, fences, apparent easements and roadways and visible encroachments if any to the best of my knowledge and belief.


This survey is made for the present owners of the property, and those who purchase, mortgage, or guarantee the title thereto, within one year from the date hereof.

SCALE 1" = 20'

JOB # 2018.0195.01

TAX ID # SGS00091

DATED THIS 29TH DAY OF JUNE, 2018.

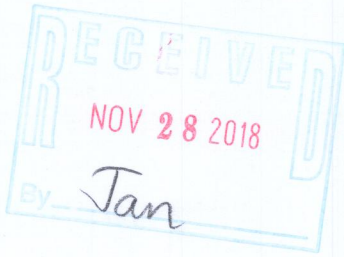

*Mark R. Madsen*  
MARK R. MADSEN S - 2271  
Wisconsin Professional Land Surveyor

SGS-91

005-3436