

August 21st, 2020

PLAT OF SURVEY


Survey No. 20-5087

LOCATION: 1104 Shabonna Drive, Fontana, Wisconsin
PREPARED FOR: Tricia Forbeck - Keefe Real Estate
LEGAL DESCRIPTION:


Lot 86 of Unit 2 of Country Club Estates, as per plat thereof recorded in the office of the Register of Deeds, Walworth County, Wisconsin, on May 8, 1926 in Vol. 8 of Plats on pages 67 and 68. Also that part of Lot 87 of Unit 2 of Country Club Estates as per plat thereof recorded in the Register of Deeds office, Walworth County, Wisconsin, on May 8, 1926 in Vol. 8 of Plats on pages 67 and 68, described as follows: Starting at the most Nly corner of Lot 87 at the point of intersects Lots 86, 87 and 88, thence SWly on a line that is a continuation of the boundary line between Lots 86 and 88, a distance of 47.43 feet to an iron stake; thence Southeastery to an iron stake that is on the SEly line of Lot 87 and 18 feet from the most Easterly corner of said lot; thence Northeastery along lot line 18 feet to said most easterly lot corner; thence Northerly on line that bounds Lots 86 and 87 a distance of 81.70 feet to the point of beginning. Also that part of Lot 87 which is described as starting at the most Northerly corner of Lot 87 at the point that intersects Lots 86, 87 and 88, thence Southwestery on a line that is a continuation of the boundary line between Lots 86 and 88 to a point that intersects with a line that is parallel with the boundary line between Lots 87 and 88 and 12 feet distance therefrom; thence Westerly along this line 65 feet more or less to the West line of Lot 87; thence Northerly along this West line a distance of 12 feet more or less, to the NW corner of Lot 87; thence Easterly along boundary line between Lots 87 and 88 a distance of 84.85 feet to the point of beginning, in Unit 2 of Country Club Estates as shown by plat thereof recorded in the Register of Deeds office, Walworth County, Wisconsin on May 8, 1926 in Vol. 8 of Plats on pages 67 and 68, all in Walworth County, Wisconsin.

Tax Key No. SCO2 00082

CURRENT OWNER: Jennifer F. Keefe
TAX ID: SCO2 00082

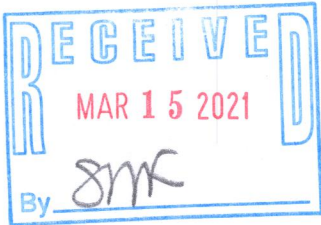

- LEGEND
- 1" Iron Pipe - Found
 - 3/4" Iron Bar - Found
 - ⦿ Power Pole
 - (xx R) "Recorded As" data

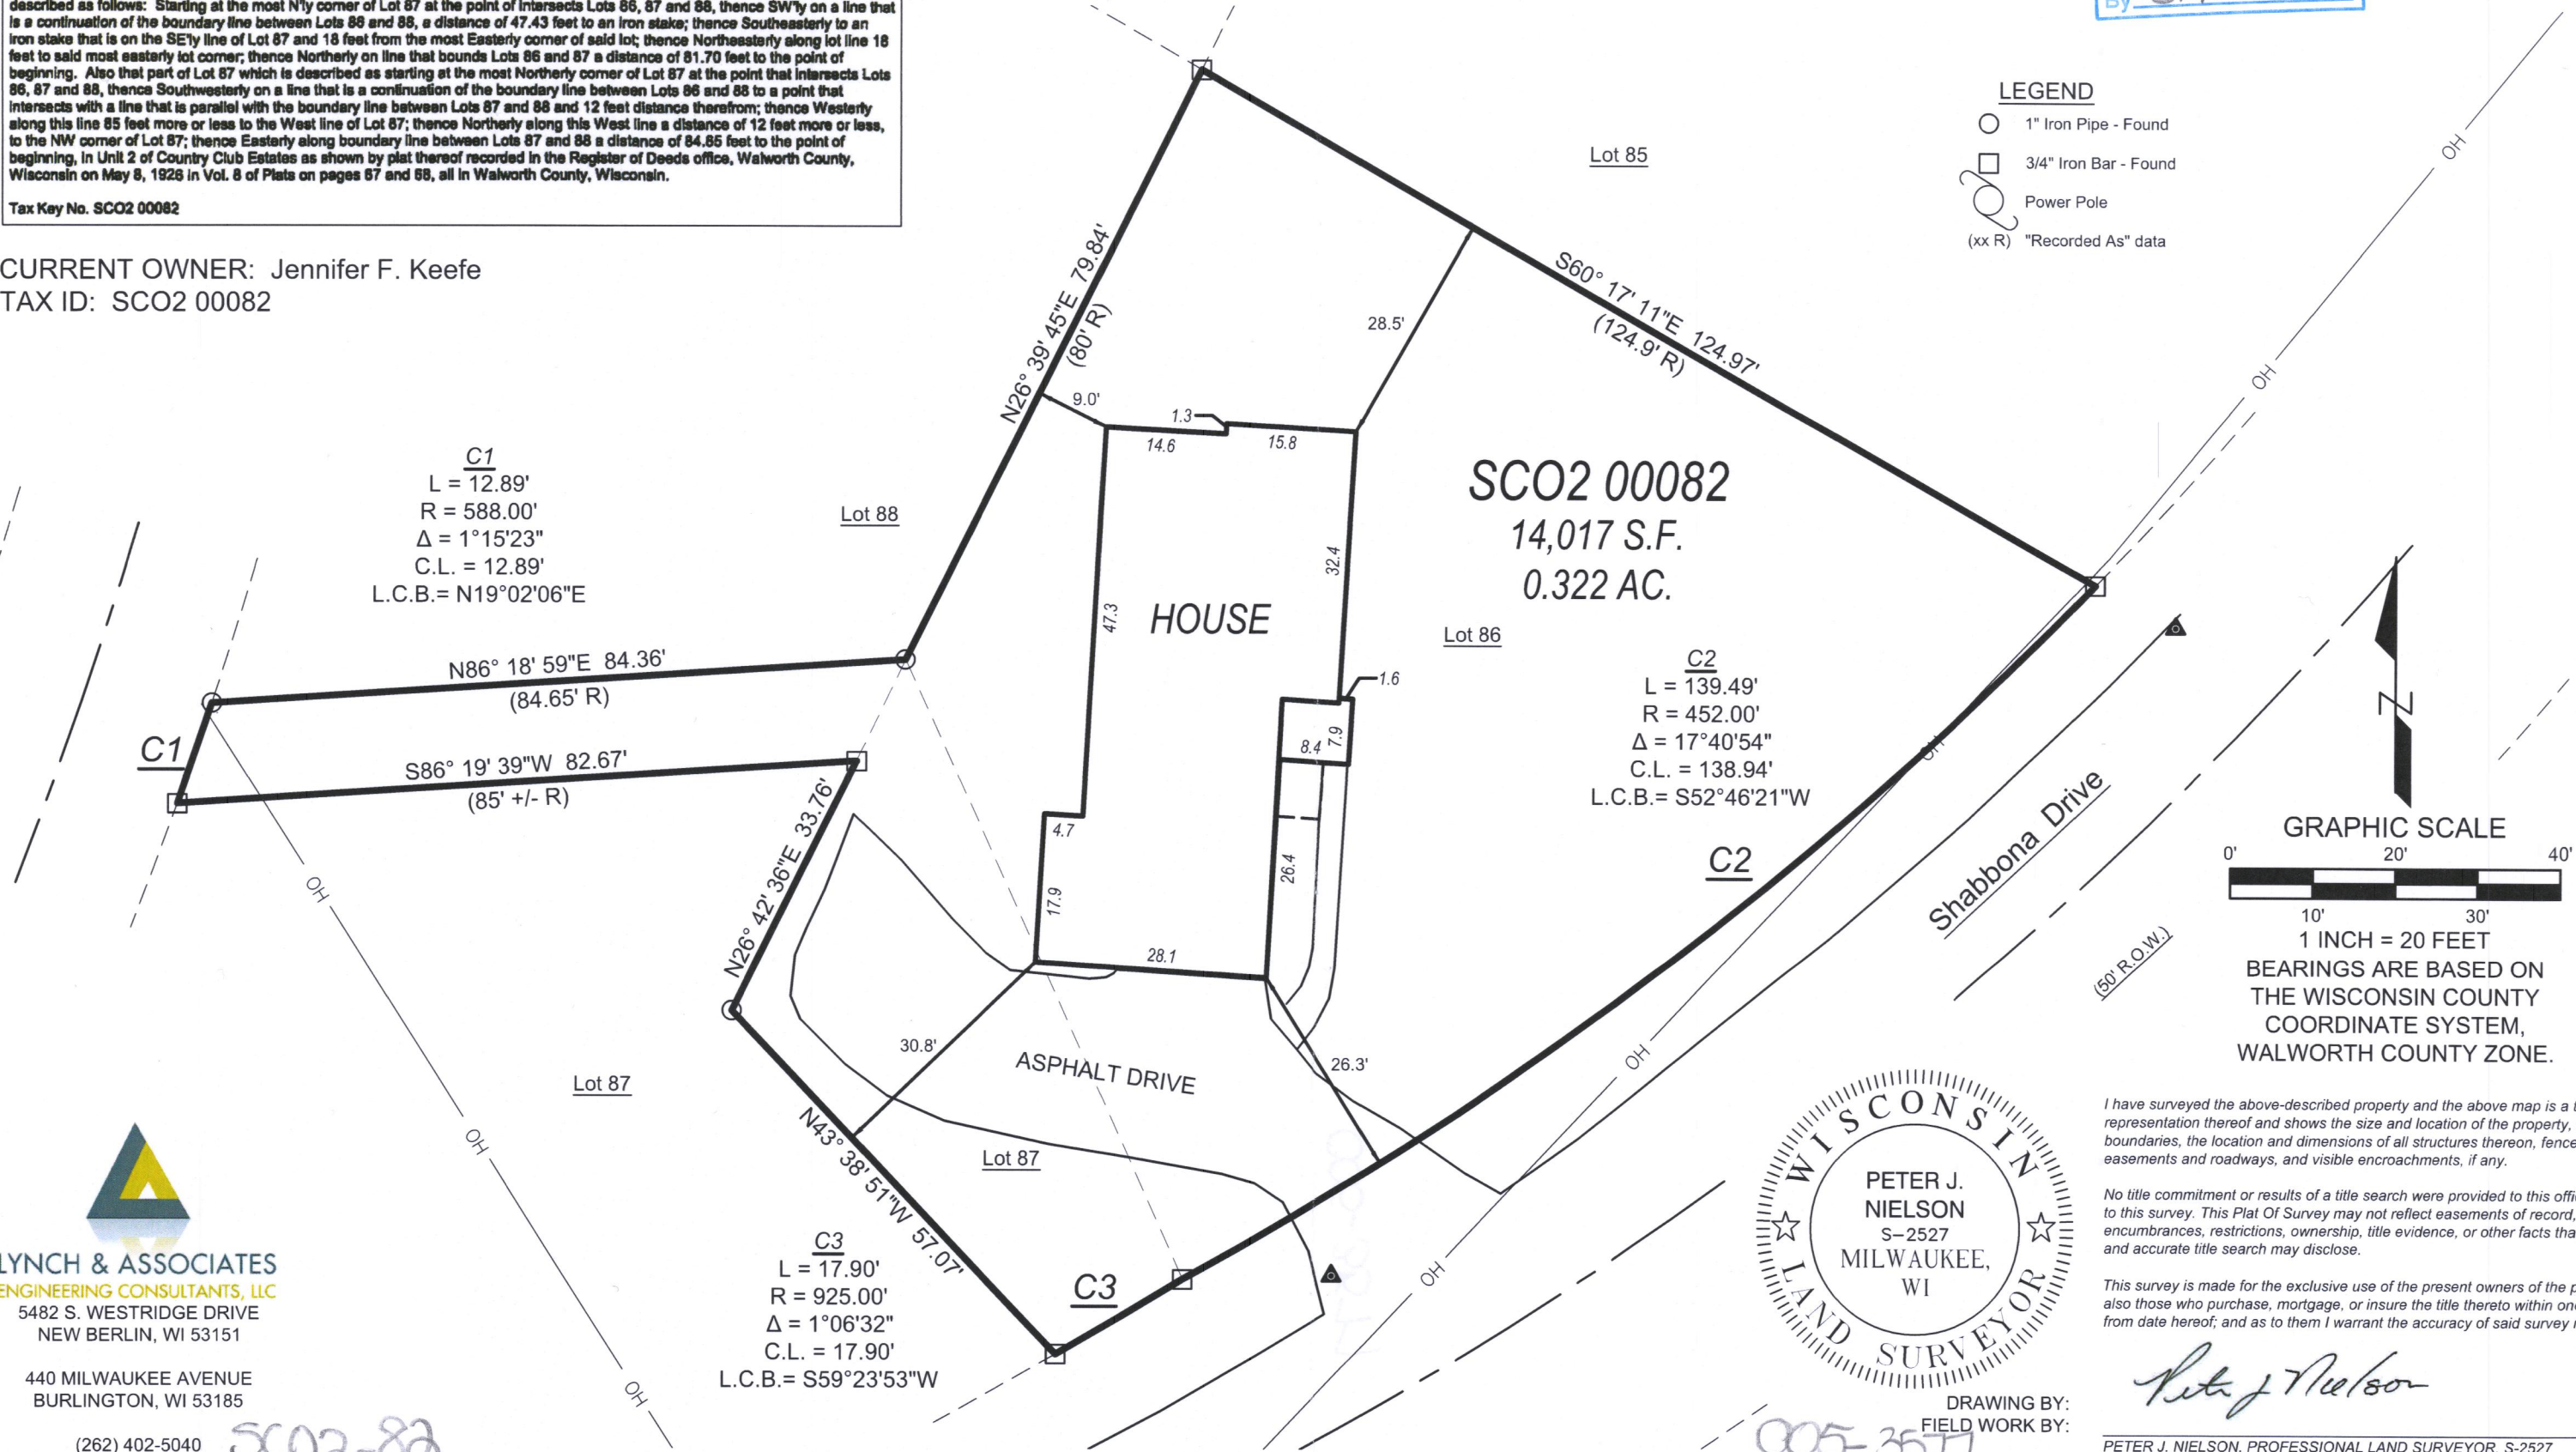

LYNCH & ASSOCIATES
ENGINEERING CONSULTANTS, LLC
5482 S. WESTRIDGE DRIVE
NEW BERLIN, WI 53151
440 MILWAUKEE AVENUE
BURLINGTON, WI 53185
(262) 402-5040



I have surveyed the above-described property and the above map is a true representation thereof and shows the size and location of the property, its exterior boundaries, the location and dimensions of all structures thereon, fences, apparent easements and roadways, and visible encroachments, if any.

No title commitment or results of a title search were provided to this office pertaining to this survey. This Plat Of Survey may not reflect easements of record, encumbrances, restrictions, ownership, title evidence, or other facts that a current and accurate title search may disclose.

This survey is made for the exclusive use of the present owners of the property, and also those who purchase, mortgage, or insure the title thereto within one (1) year from date hereof; and as to them I warrant the accuracy of said survey map.

DRAWING BY: *Peter J. Nielson*
FIELD WORK BY: *Peter J. Nielson*
PETER J. NIELSON, PROFESSIONAL LAND SURVEYOR, S-2527