

HAROLD H. KOLB

REGISTERED PROFESSIONAL LAND SURVEYOR

LAKE GENEVA, WISCONSIN

SOUTH SHORE DRIVE 66' WIDE

82.7 (S 88°33' E) 118.00'

(S 88°33' E)
(1324.69')
(33.00')
(N 0°55' E)

EAST 1/4 COR. SEC. 13-1-16

Elev. top of sun light
on roof (highest elev.) =
115.30

61.80'
(N 0°55' E)


90.1

Platted as N 0°53' E
Described on same
plat as N 0°55' E

UNIT 49

UNIT 50

203.63'
188.63'
(N 29°07' E)

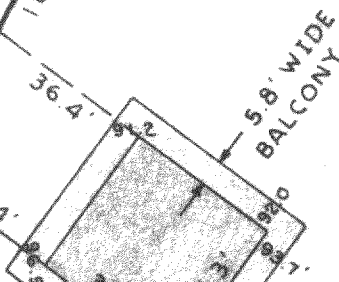

SOUTHEAST CORNER
OF BALCONY - ASSUMED
ELEV. OF 100.00'

226.82'
(N 46°25' E)

PLAT OF SURVEY OF

A parcel of land located in the South
1/2 of Section 13, T 1 N, R 16 E, Village
of Fontana-on-Geneva Lake, Walworth
County, Wisconsin.

ROLLING
GREEN DRIVE


(S 65°24' E)
(N 1°18' E)
(15.00')
(19.44')

N

SCALE: 1"=40'

LEGEND

- φ - IRON PIPE FOUND
- - IRON PIPE PLACED
- - CONCRETE MONUMENT
- x - SPIKE
- () - PLATTED AS

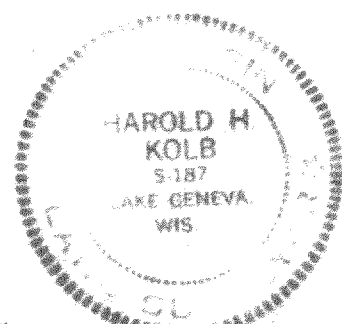

I, HAROLD H. KOLB, DO HEREBY CERTIFY THAT I HAVE
SURVEYED THE PROPERTY HEREON DESCRIBED ACCORDING
TO THE OFFICIAL RECORDS, AND THAT THE PLAT HEREON
IS A CORRECT REPRESENTATION OF THE LOT LINES.

Harold H. Kolb

HAROLD H. KOLB

WISCONSIN REGISTERED LAND SURVEYOR, S-187

DATE Jan 11, 1974

5-360

SCDB-50