



HAROLD H. KOLB
REGISTERED PROFESSIONAL LAND SURVEYOR
TWIST BUILDING
LAKE GENEVA, WIS. 53147

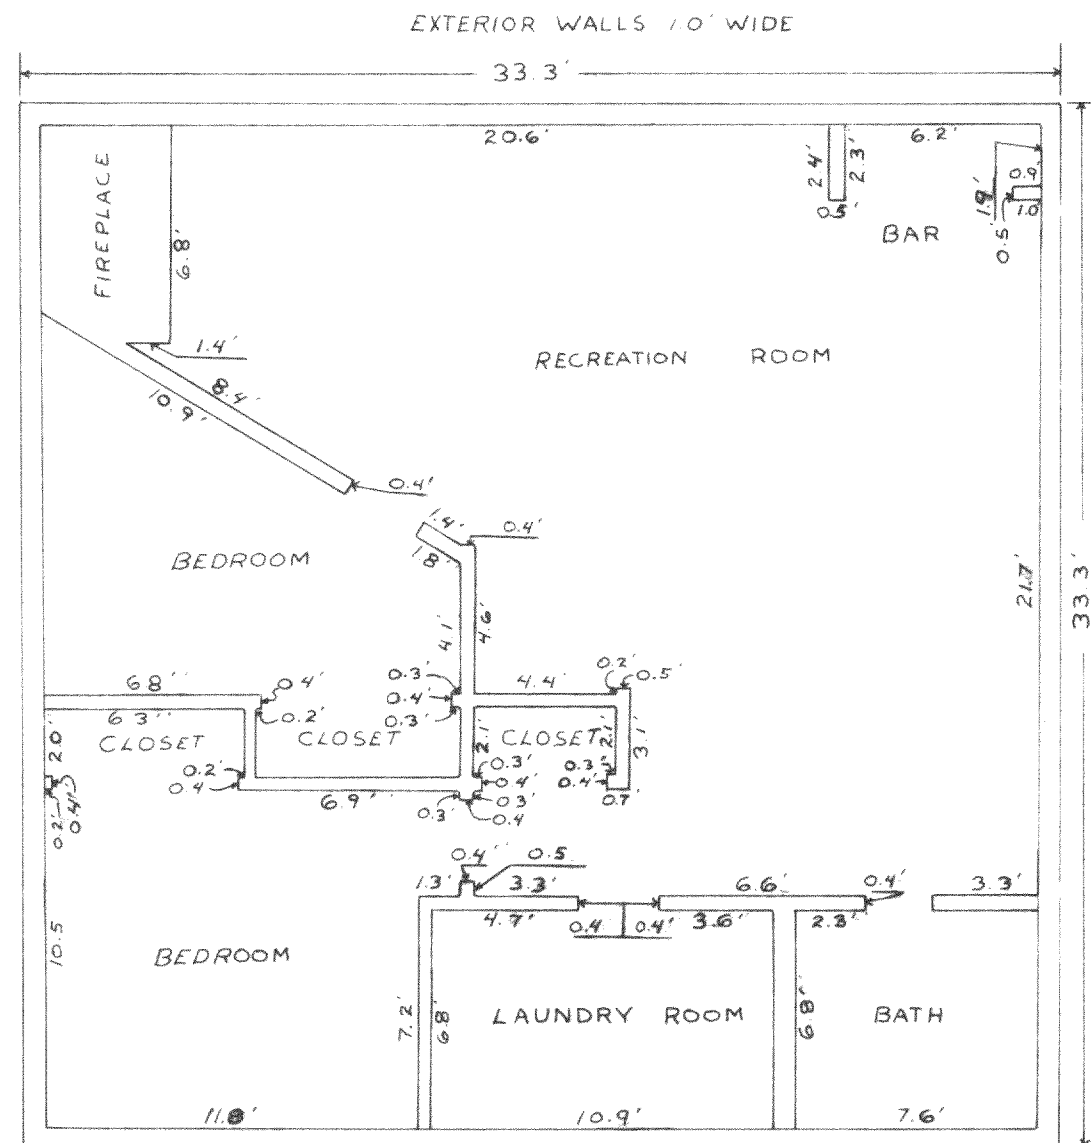

First Floor Facing Rolling Green Drive

NOTE: Second floor ceiling pyramids in height from 8.7' at the outer walls to 13.3' directly over spiral steps. Sky-light located directly over spiral steps is 15.2' from the floor.

SCALE: 1" = 6'

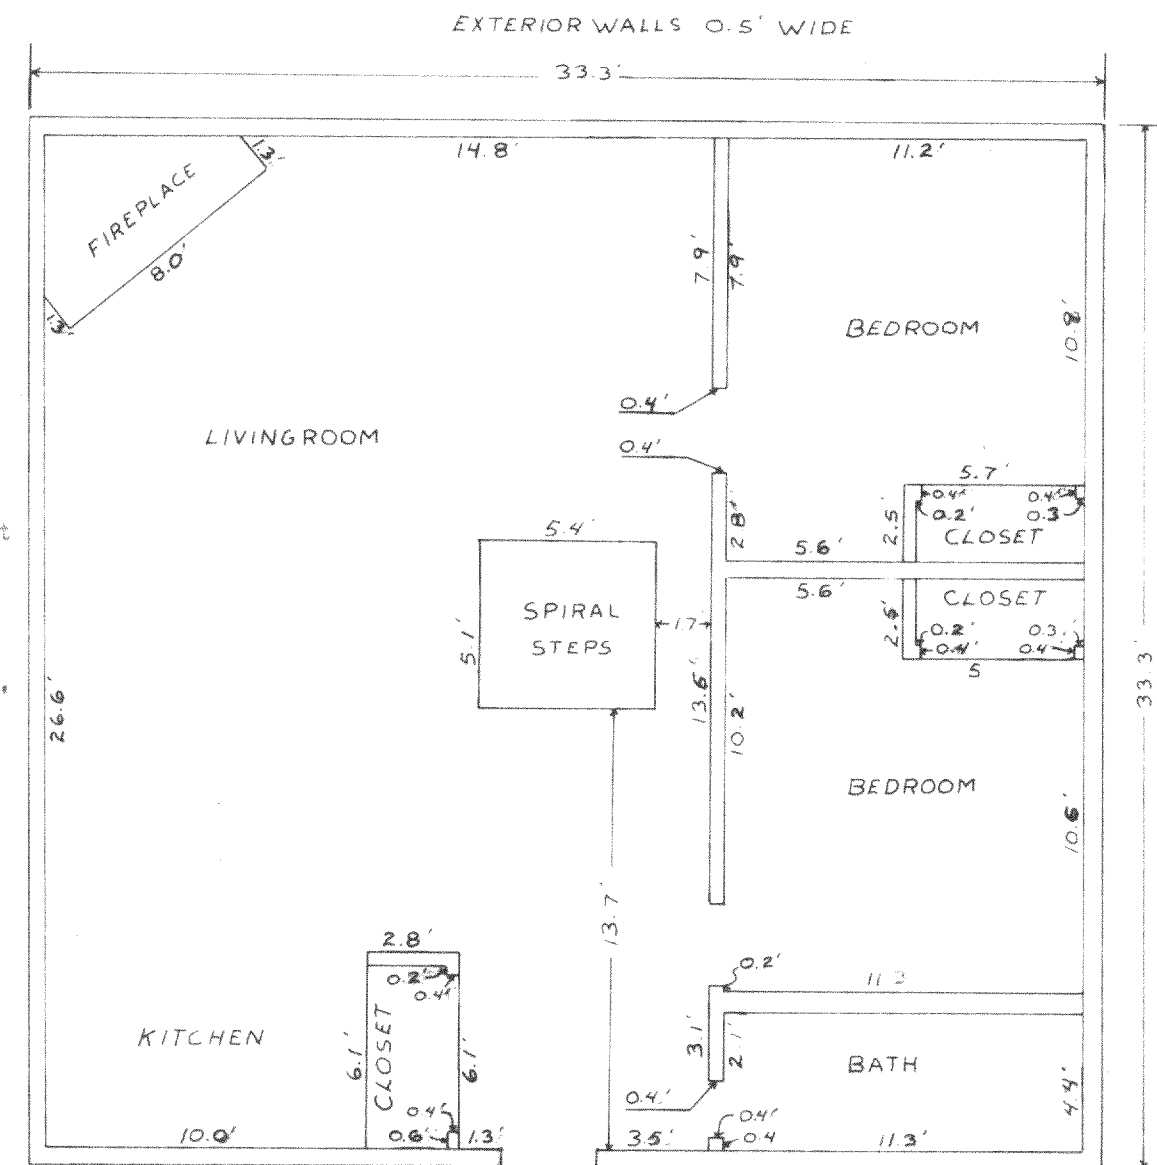

Second Floor Facing Rolling Green Drive

PLAT OF

House plans as exist on Unit 30 of Abbey Springs, -
Village of Fontana-on-Geneva Lake, Walworth County,
Wisconsin.

Harold H. Kolb
Harold H. Kolb
Wis. Registered Land Surveyor, 2-187

DATE: Jan. 22, 1974