


LAND-MARK SURVEYING
Mark L. Miritz
Wisconsin Registered Land Surveyor S-2582

N9330 Knuteson Drive
Whitewater, WI 53190
Phone: (262) 495-3284
FAX : (262) 495-8421
LAND-MARKSURVEYING.COM


PLAT OF SURVEY

LOT 5, BLOCK E, COUNTRY CLUB ESTATES, UNIT NO. 3
ACCORDING TO THE PLAT THEREOF, RECORDED IN THE
OFFICE OF THE REGISTER OF DEEDS FOR WALWORTH
COUNTY, WISCONSIN ON MARCH 12, 1927 IN VOLUME
8 OF PLATS, ON PAGES 107 AND 108, VILLAGE OF
FONTANA, WALWORTH COUNTY, WISCONSIN.

ORDERED BY:
DAVID C. CURRY
GENEVA LAKEFRONT REALTY
49 WEST GENEVA STREET
WILLIAMS BAY, WI 53191

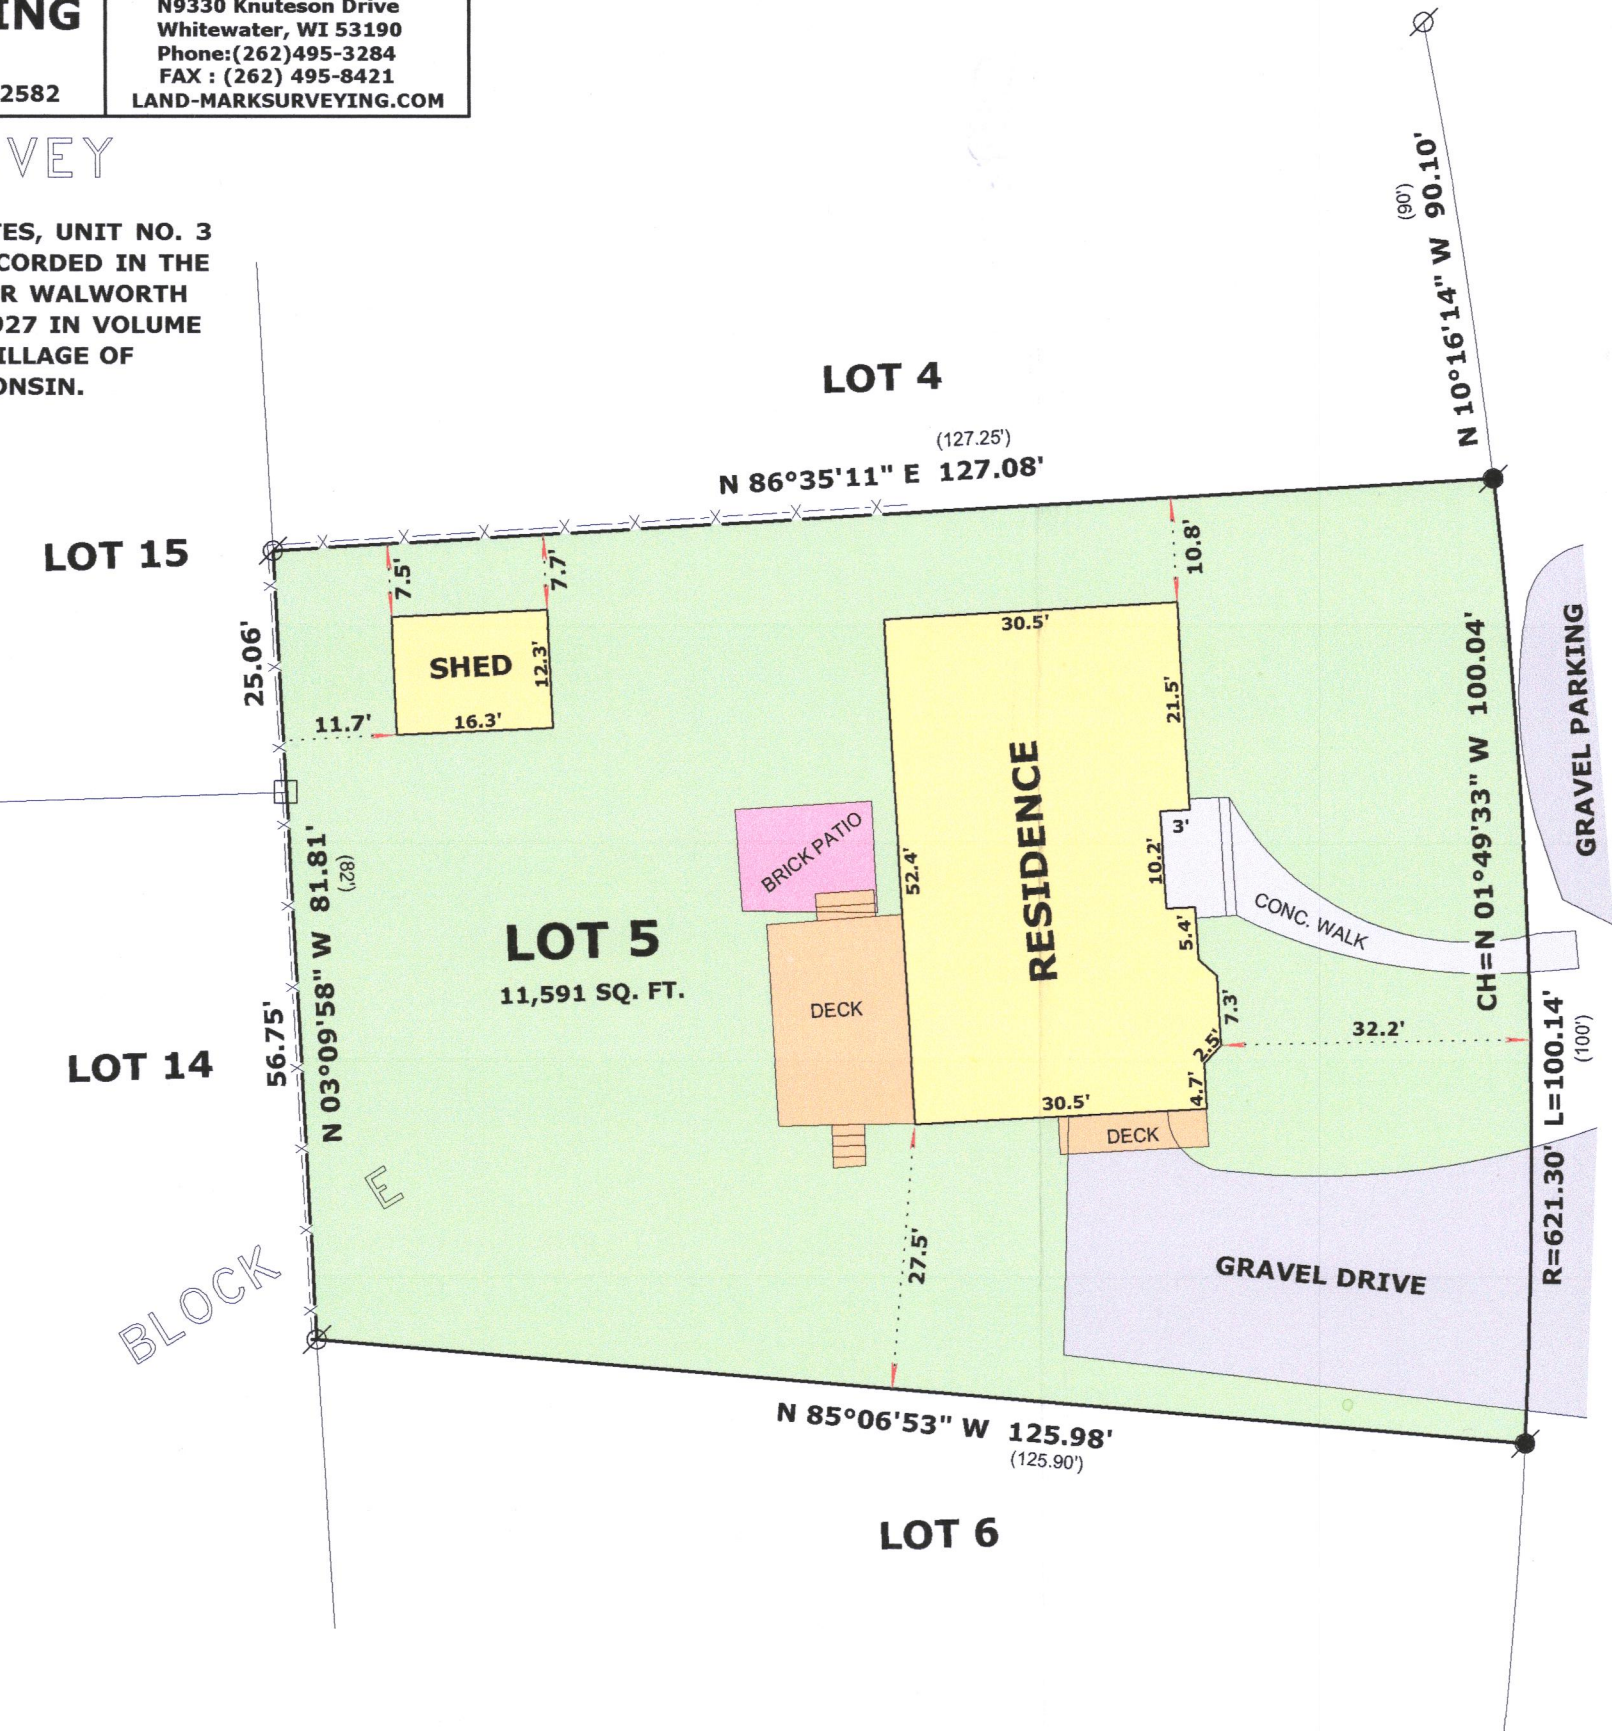

FEATHERSTON DRIVE A.K.A FEATHERSTONE DRIVE
(30' WIDE)

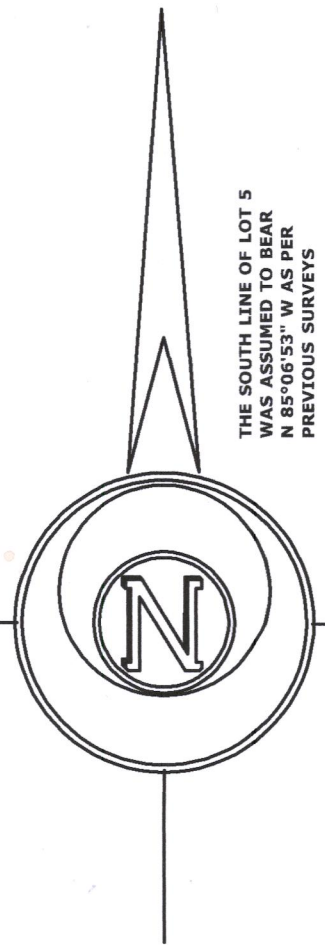

THE SOUTH LINE OF LOT 5
WAS ASSUMED TO BEAR
N 85°06'53" W AS PER
PREVIOUS SURVEYS

- LEGEND**
- FOUND IRON PIPE
 - FOUND IRON ROD
 - FOUND CONCRETE MONUMENT
 - (x x) RECORDED AS DIMENSION
 - X-X- EXISTING FENCE

SCALE: 1 INCH = 20 FEET

"I hereby certify that the above described property has
been surveyed by me or under my direction and that the
above map is a true representation thereof and shows the
size and location of the property, its exterior boundaries,
the location of all visible structures and dimensions of all
principal buildings thereon, boundary fences, apparent
easements, roadways and visible encroachments, if any."
"This survey is made for the use of the present owners of
the property, and also those who purchase, mortgage, or
guarantee the title thereto within one year from date
hereof."



Mark L. Miritz
MARK L. MIRITZ
WISCONSIN REGISTERED
LAND SURVEYOR S-2582

DATE: MAY 29, 2011 JOB NO. 11.508



SC03-82

005-3625