


PLAT OF SURVEY UNIT 591 OF ABBEY SPRINGS CONDOMINIUM NO. 13

LOCATED IN THE SOUTHEAST 1/4 OF SECTION 13, TOWN 1 NORTH, RANGE 16 EAST,
WALWORTH COUNTY, WISCONSIN

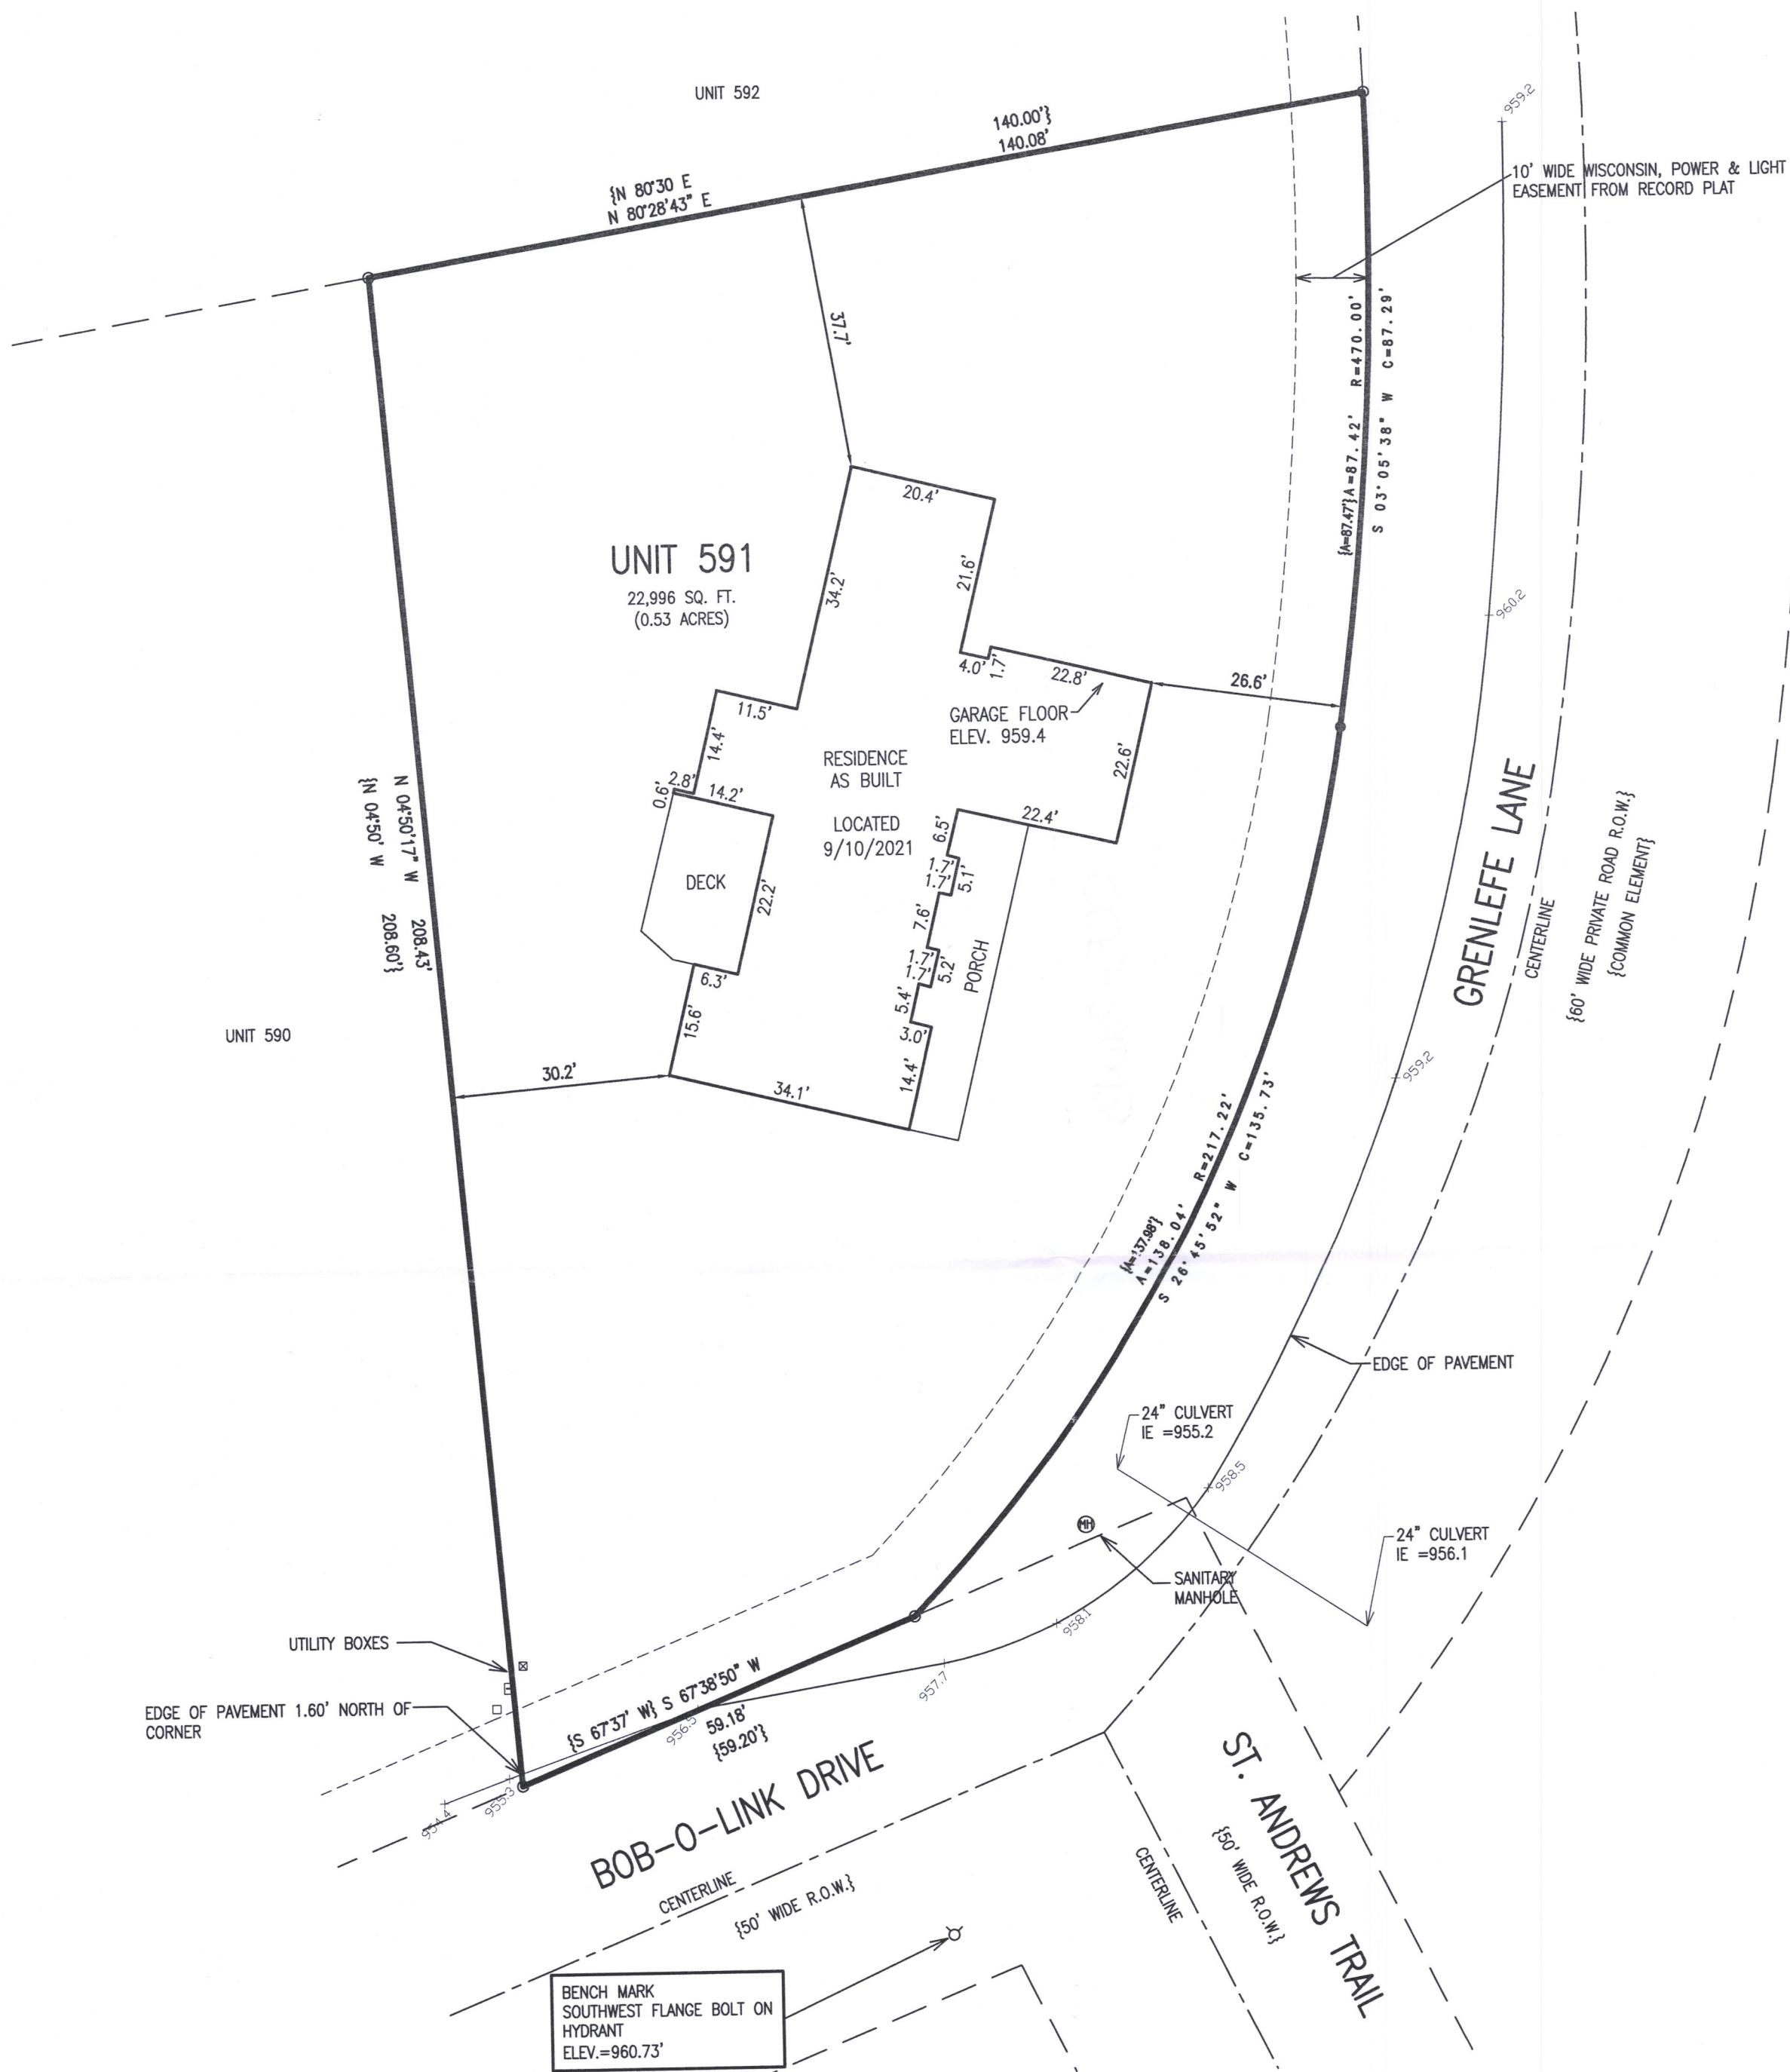


NOTE: COPIES OF THIS MAP TO WHICH THE FOLLOWING CERTIFICATE WILL APPLY SHOW THE SURVEYOR'S ORIGINAL SEAL AND SIGNATURE IN RED INK. COPIES BY ANY OTHER MEANS MAY HAVE ALTERATIONS WHICH DO NOT REPRESENT THE SURVEYOR'S WORK PRODUCT.

I HEREBY CERTIFY THAT THE ABOVE DESCRIBED PROPERTY HAS BEEN SURVEYED UNDER MY DIRECTION AND THAT THE ABOVE MAP IS A TRUE REPRESENTATION THEREOF AND SHOWS THE SIZE AND LOCATION OF THE PROPERTY AND ITS EXTERIOR BOUNDARIES. THIS SURVEY IS MADE FOR THE USE OF THE PRESENT OWNERS OF THE PROPERTY, AND ALSO THOSE WHO PURCHASE, MORTGAGE, OR GUARANTEE THE TITLE THERETO WITHIN ONE YEAR FROM THE DATE HEREOF.

DATED: 4/29/2021


REVISED 10/14/2021 TO SHOW
RESIDENCE AS BUILT.

CHRISTOPHER A. HODGES P.L.S. S-2760

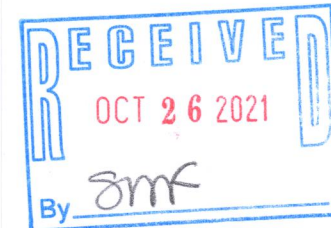

LEGEND
○ = FOUND IRON PIPE STAKE
{XXX} = RECORDED AS

WEST LINE OF UNIT 591 BEARS
N 04°50'17" W
PER SURVEY OF RECORD

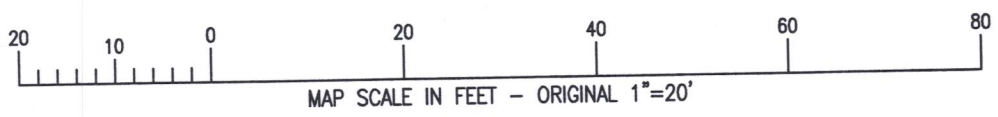

	PLAT OF SURVEY SITE, GRADING, DRAINAGE, & EROSION CONTROL PLAN	FARRIS, HANSEN & ASSOCIATES, INC. ENGINEERING — ARCHITECTURE — SURVEYING 7 RIDGWAY COURT P.O. BOX 437 ELKHORN, WISCONSIN 53121 OFFICE: (262) 723-2098 FAX: (262) 723-5886	— WORK ORDERED BY — ED SALOGA 448 COURTNEY CIR SUGAR GROVE, IL 60554	REVISIONS		9467.21
						DATE: 02/26/2021
						SHEET NO. 1 OF 1

005-3643