

ROBERS & BOYD, INC.
CONSULTING ENGINEERS & LAND SURVEYORS

PHONE (414) 763-2652


116 E. CHESTNUT ST.

BURLINGTON, WIS. 53105

PLAT OF SURVEY
AND
BUILDING LOCATION

Outlot 65 of Assessors Plat # 1
(amended) to the Village of
Pontana on Geneva Lake and Lot
5 of Robert Gardners Subdivision,
Village of Pontana on Geneva
Lake, said parcel located in
the Village of Pontana, Walworth
County, Wisconsin.

N

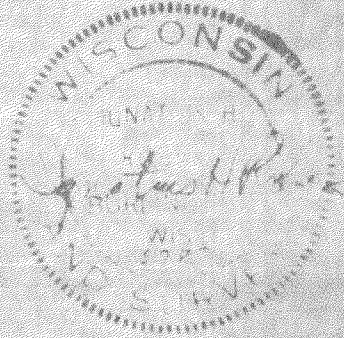

— LEGEND —

- FOUND IRON PIPE
 - SET IRON PIPE
 - ⊕ FOUND CONC. MONMNT
- SCALE 1"=60'

AUGUST 5, 1974

NOTE


THERE ARE NO VISIBLE
ENCROACHMENTS

"I have surveyed the above-described property, and
the above map is a true representation thereof and shows
the size and location of the property, its exterior bound-
aries, the location and dimensions of all visible struc-
tures thereon, fences, apparent easements and roadway
and visible encroachments, if any.

This survey is made for the exclusive use of the
present owner of the property, and also those who pur-
chase, mortgage, or guarantee the title thereto, within
one year from date hereof and to them I warrant the
accuracy of said survey and map."

Dated at Burlington, this 5th day
of August, 1974.

R. H. Rober
Surveyor 5787

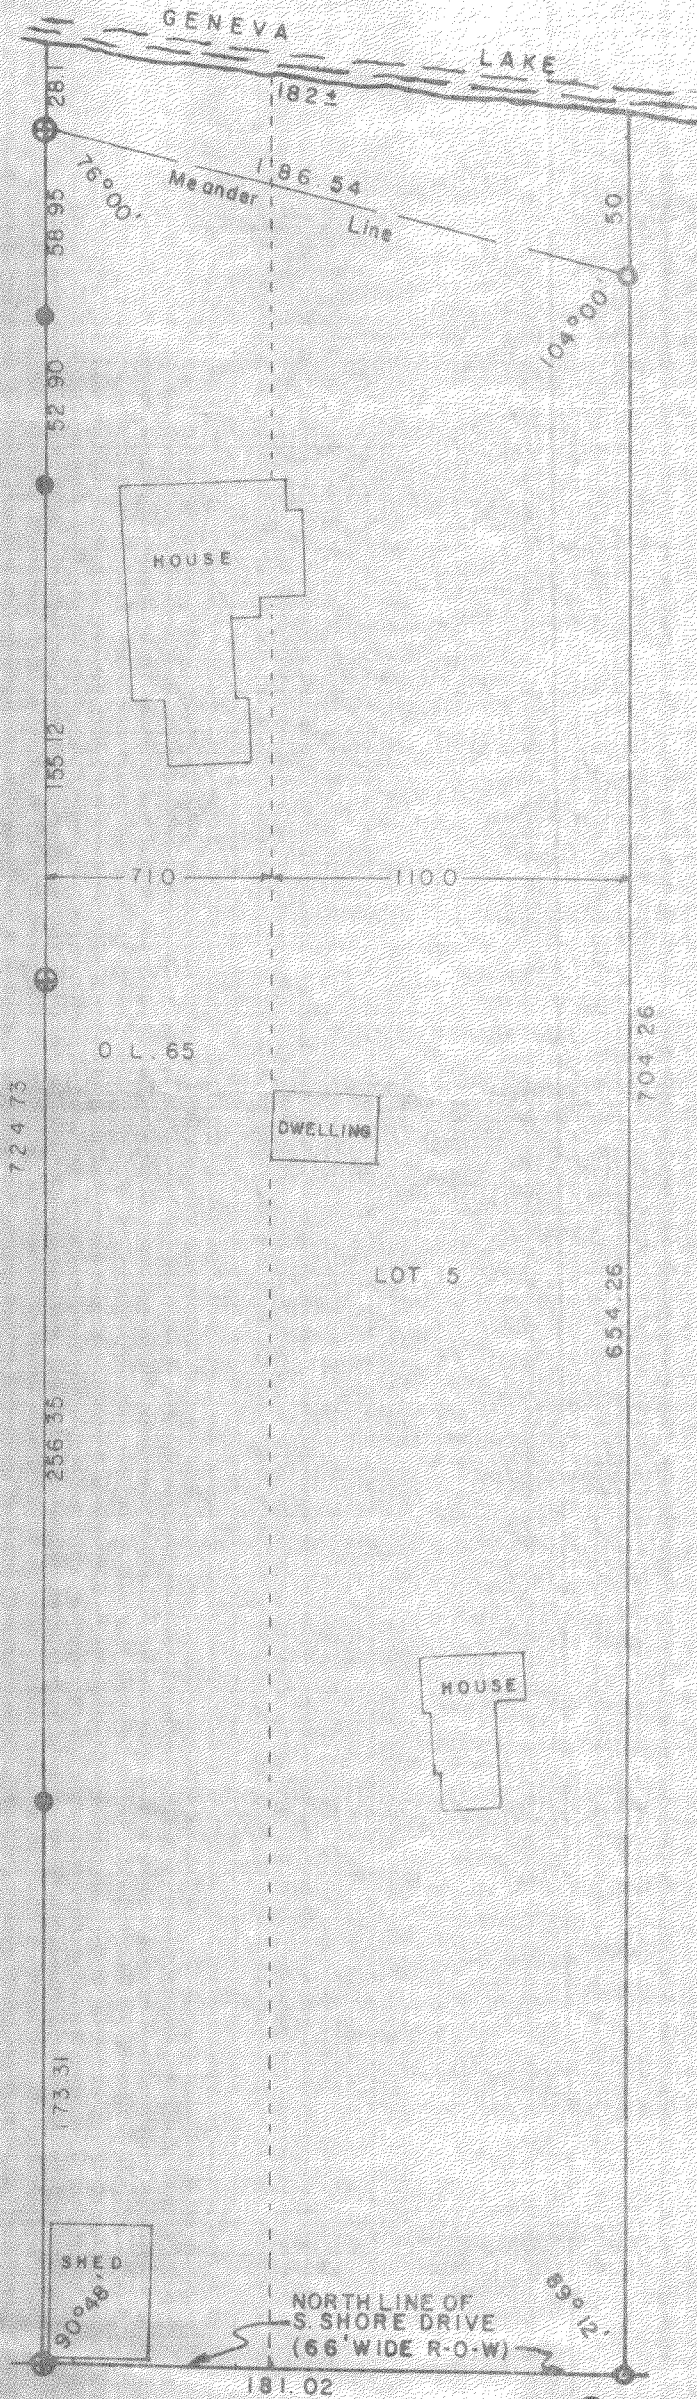

Now Cert. Survey #655

5-366