


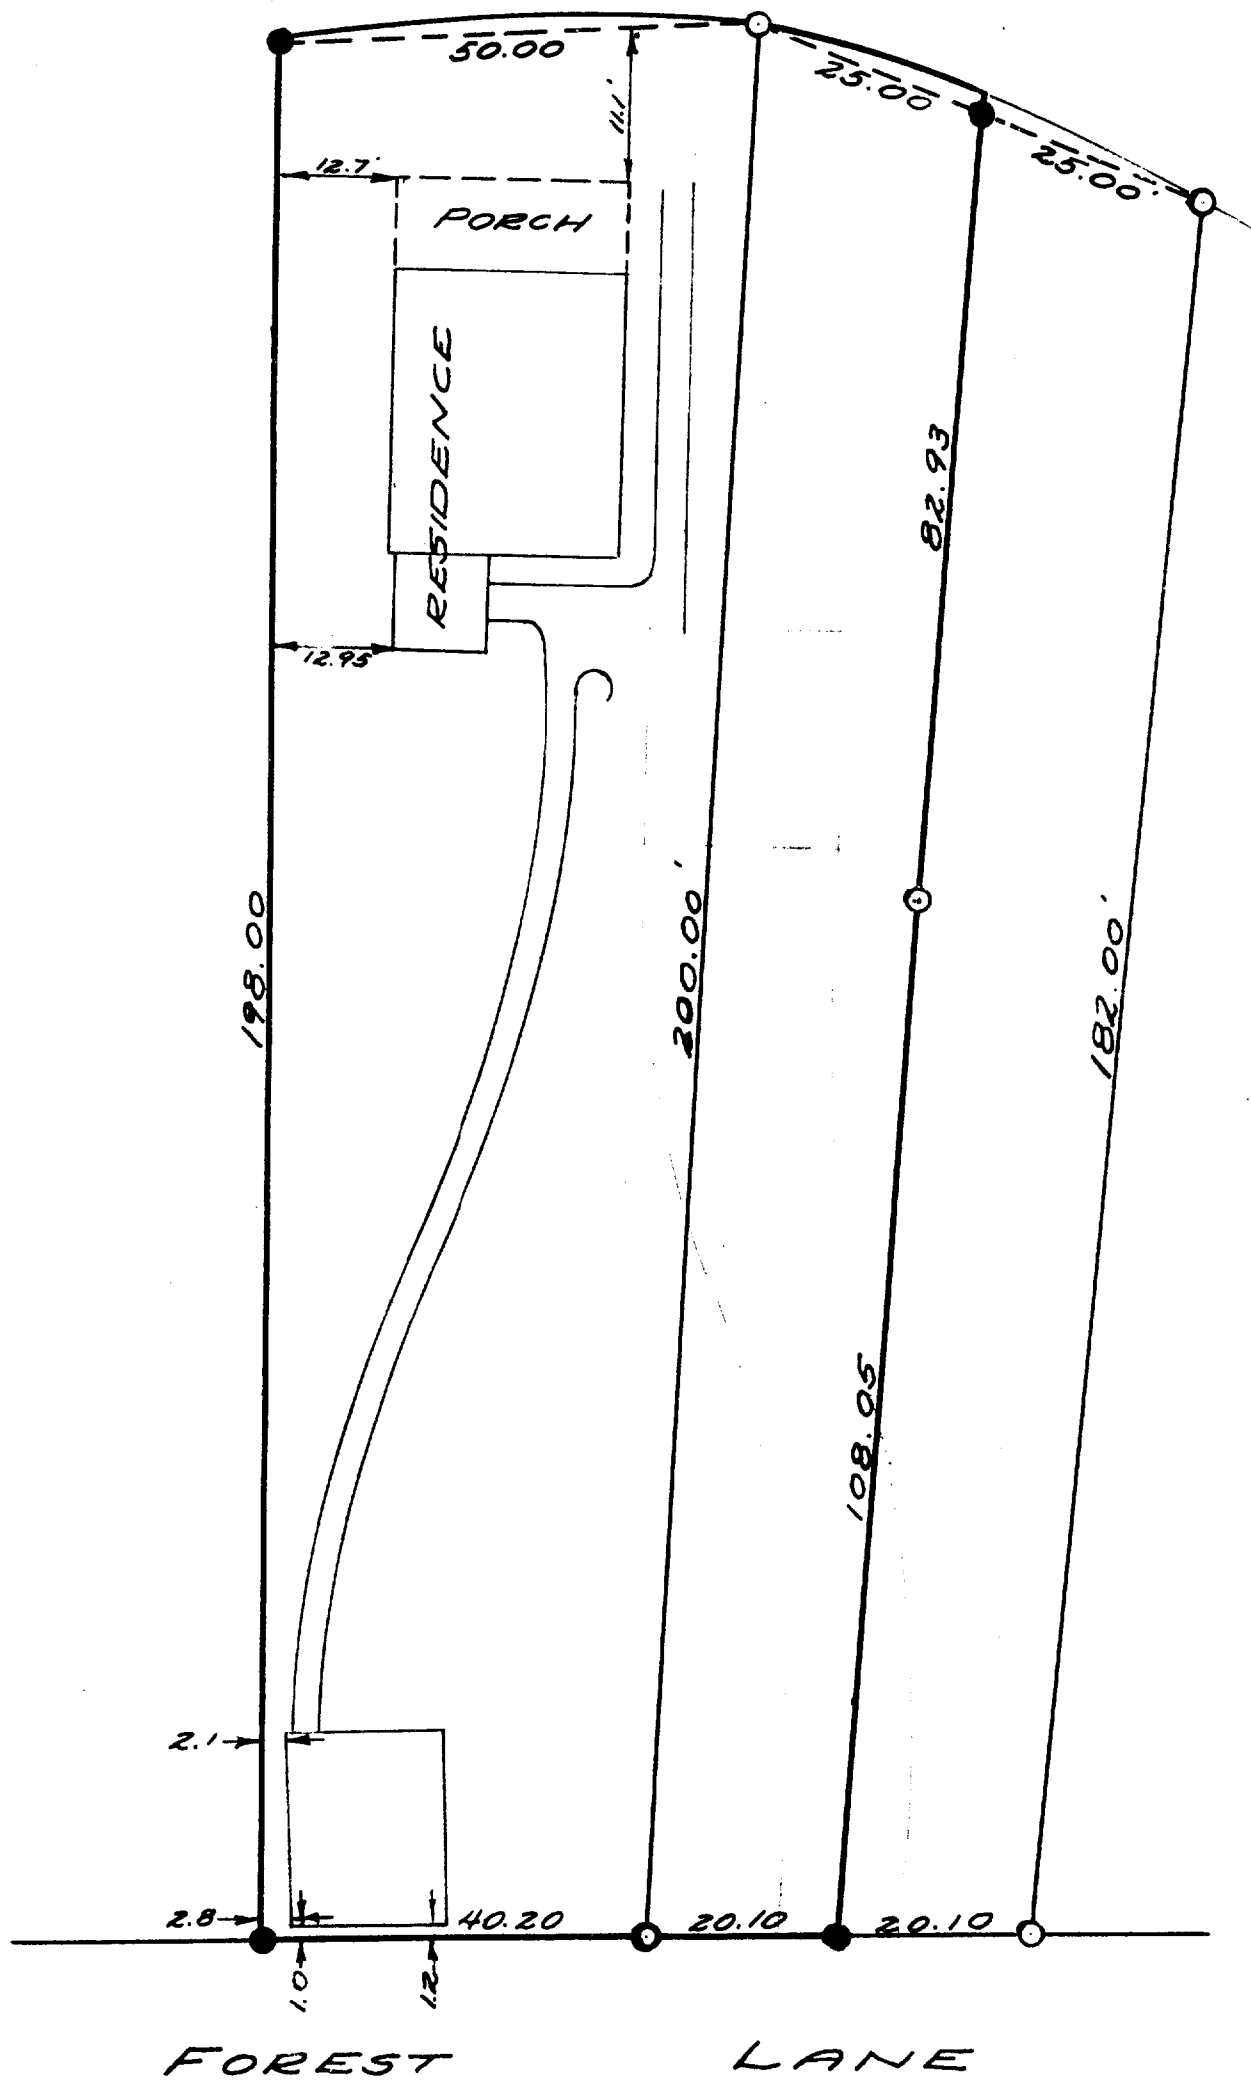

SCALE 1"=20'
 O=IRON PIPE
 ●=CONG. MONU.

PLAT OF SURVEY OF LOT 83 AND THE WESTERLY
 HALF OF LOT 84 OF BUENA VISTA SUBDIVISION
 IN THE VILLAGE OF FONTANA-ON-GENEVA LAKE,
 WALWORTH COUNTY, WISCONSIN.

DECEMBER, 1946

H. E. Johnson
 SURVEYOR