


PLAT OF SURVEY

OF LOT 14, BLOCK C, COUNTRY CLUB ESTATES UNIT NO. 3,
BEING PART OF THE NW 1/4 OF THE SW 1/4 OF SECTION 14,
T. 1 N., R. 16 E., OF THE 4TH P.M., VILLAGE OF
FONTANA-ON-GENEVA LAKE,
WALWORTH COUNTY, WISCONSIN

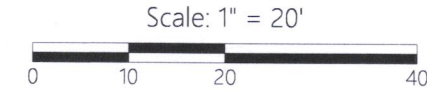


DISTANCE UNITS BASED ON THE UNITED STATES SURVEY FOOT

THE NORTH LINE OF LOT 14 BEARING S 74°33'51" E

LEGEND

- Iron Rebar Set
3/4" x 24" (1.5 Lbs./Ft.)
- ⊙ Iron Pipe Found
- ✕ Cut Cross Set
- (XXX.XX) Record Information
- ⊞ Existing Stop Sign
- x — Existing Fence

NOTE: MONUMENTS SET FOR LOT 14 ARE BASED ON A PLAT OF
SURVEY BY ROBERT M. BAERENWALD DATED APRIL 6, 1993.

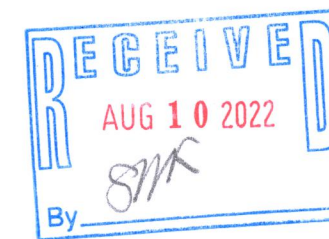

Kristin J Belongia

Kristin J. Belongia, P.L.S.
Wisconsin Professional Land Surveyor S-2943

State of Wisconsin } ss
County of Walworth }

I hereby certify that I have supervised the survey of the property described above and to the best
my knowledge and belief, the plat drawn hereon complies with Chapter A-E 7 of the State of
Wisconsin Administrative Code, Minimum Standards for Property Surveys and correctly
represents said survey and its location.

Given under my hand and seal this 16th day of June, 2022 at Beloit, Wisconsin.

Last day of field work June 13, 2022

If the surveyor's signature is not red in color,
the plan is a copy that should be assumed to
contain unauthorized alterations.
The certification contained on this document
shall not apply to any copies.



Batterman
engineers surveyors planners

2857 Bartells Drive
Beloit, Wisconsin 53511
608.365.4464

PLAT OF SURVEY


FOR THE EXCLUSIVE USE OF:

TORY TARSITANO
860 SAUGANASH
FONTANA, WI 53125

ORDER NO: 34345

FIELD CREW: DGM
DRAWN BY: DGM
SHEET 1 OF 1

File Name: J:\34300-34399\34345 - Tory Tarsitano\SURVEY\PHB DRAWING FILES

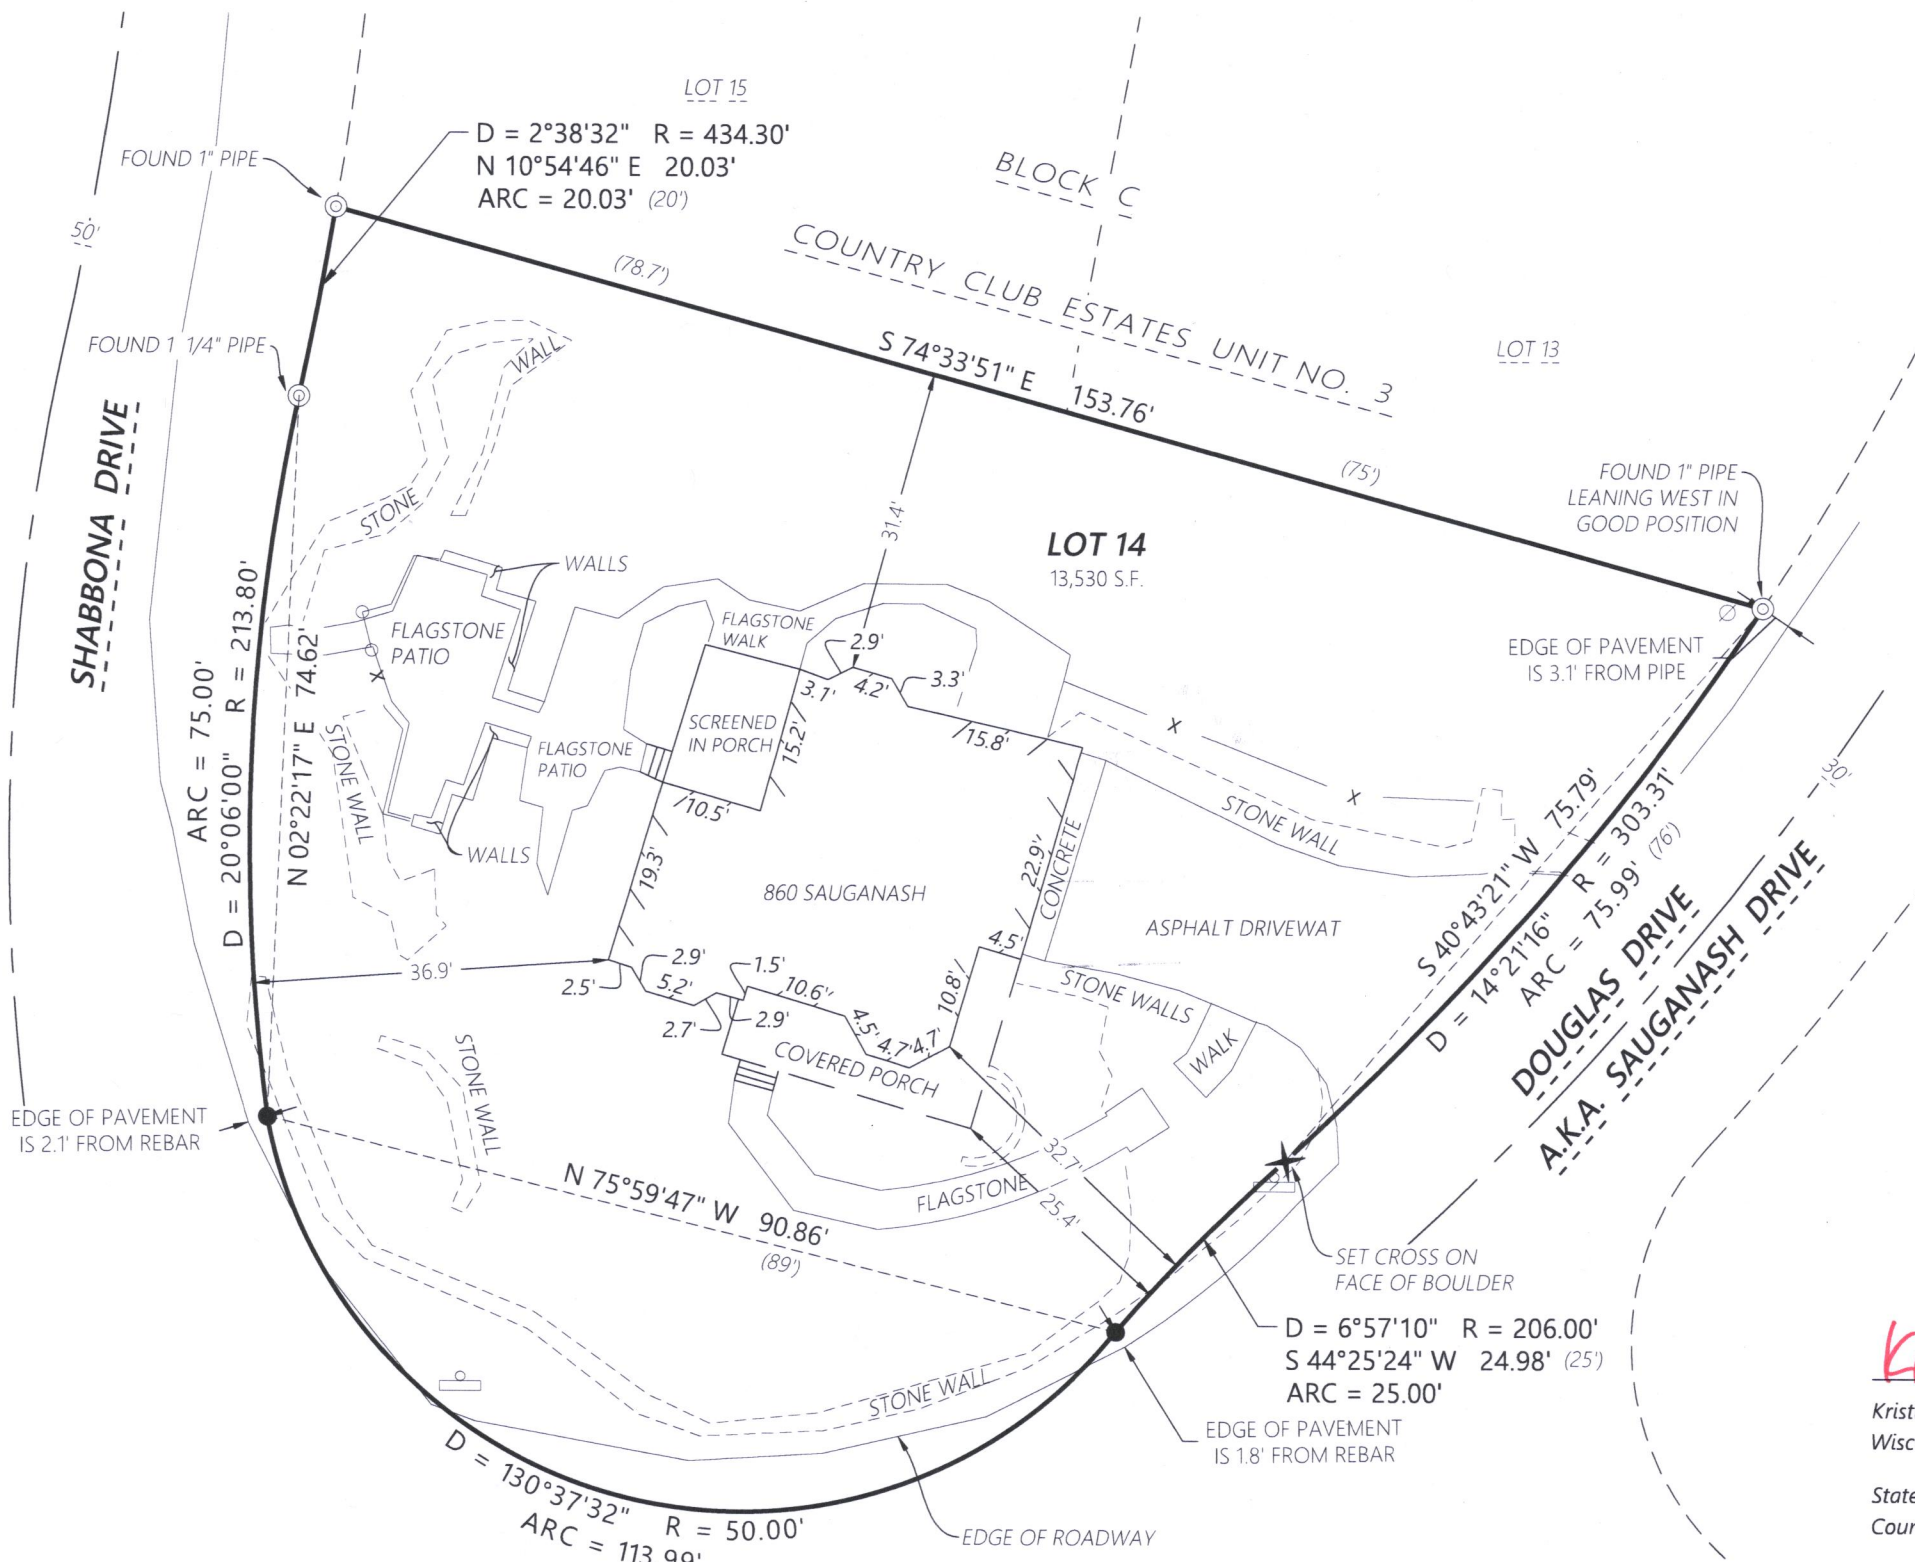

5003-43

005-3703