


Plat of Survey

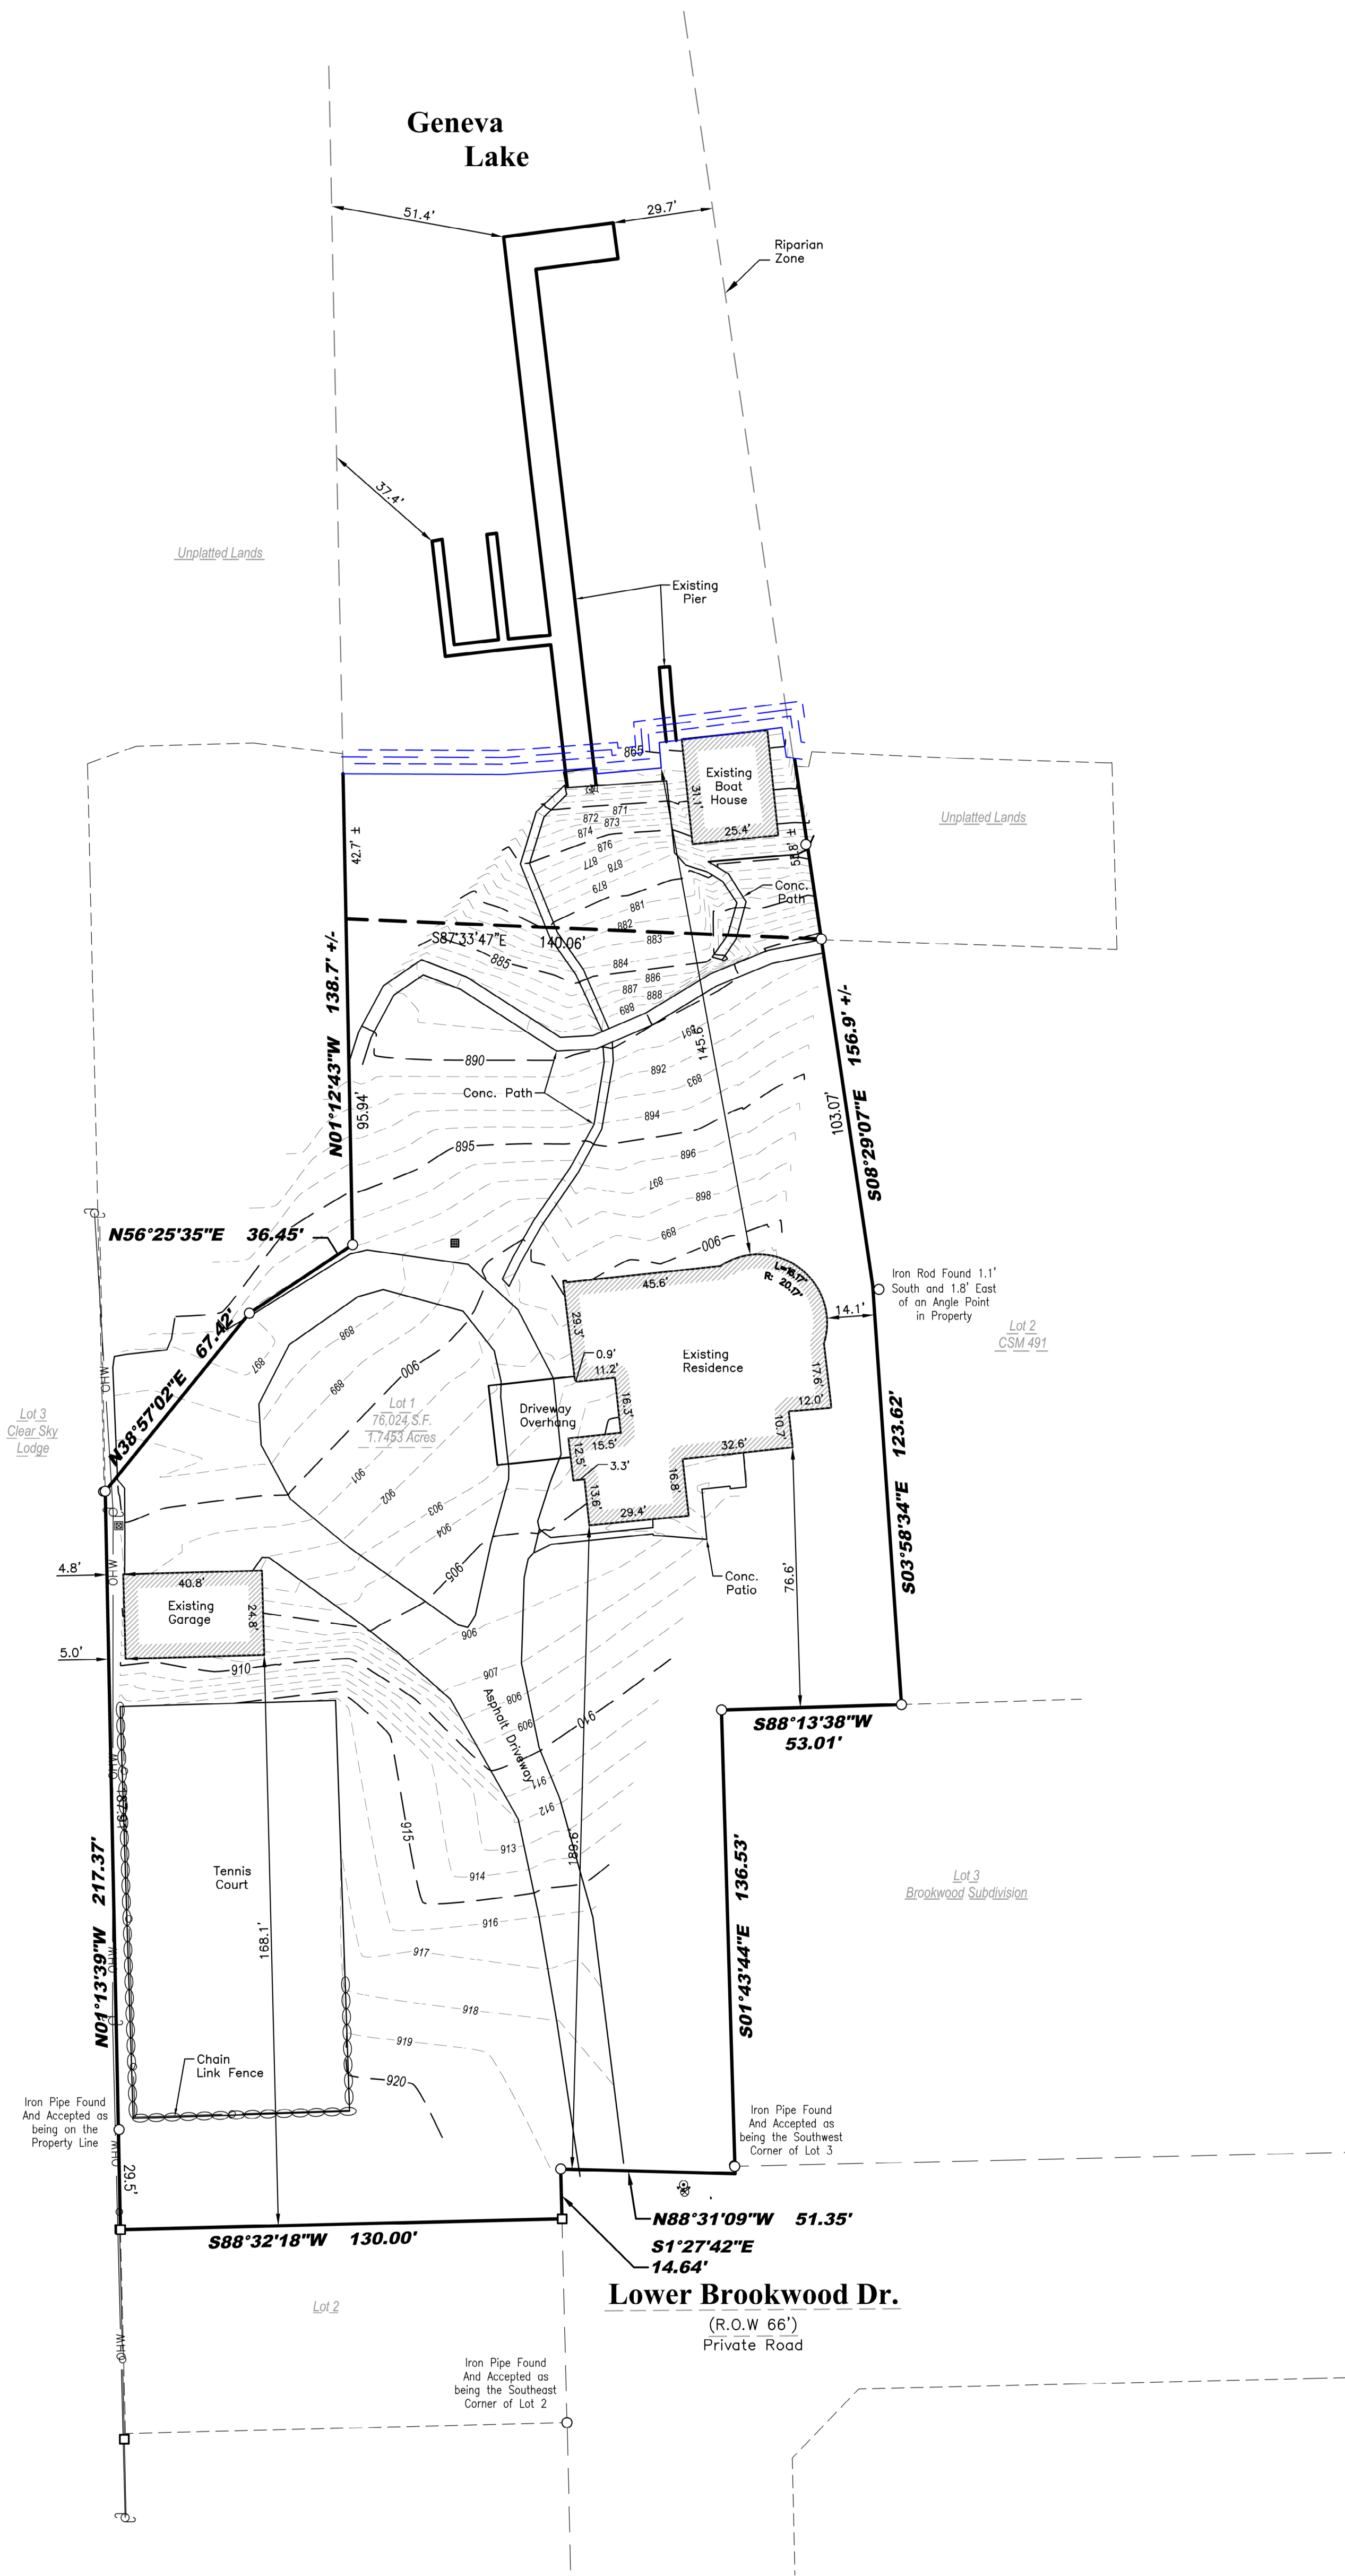

- Legend:
- Found Iron Rod
 - Found 1" Iron Pipe
 - Utility Pole
 - Light Pole
 - Electric Transformer
 - Telephone Pedestal
 - Fire Hydrant
 - Water Main Valve
 - Storm Inlet - Square

LOCATION: 1164 Lower Brookwood Dr, Fontana-On--Geneva Lake , Wisconsin

PREPARED FOR: Hans Melges

PROPERTY DESCRIPTION: Surveyed As

Lot 1, Certified Survey Map No.: 5014, being a part of the Southwest ¼ of the Northwest ¼ of Section 18, Township 1 North, Range 17 East, located in the Village of Fontana, Walworth County, Wisconsin.

CURRENT OWNER: THEODORE R TETZLAFF TRUST

TAX ID: SA501400001

I certify that I have surveyed the above-described property and in my professional opinion this map is a true representation thereof and is made in accordance with the records of the register of deeds as nearly as practical and that this survey complies with Wisconsin Administrative code AE-7 except for those items waived, if any, and is bound by Wisconsin State Statute 883.37 that defines statute of limitations in regard to surveys. This survey was prepared for the exclusive use of the client and present owners of the property.

No title policy has been provided to the surveyor regarding the property identified on this map. Therefore this plat of survey does not guarantee the existence, size and location of any easements, encumbrances, restrictions or other facts that could otherwise be disclosed in an ALTA/NSPS survey.

Rick R. Hillmann, Professional Land Surveyor, S-3005



LYNCH & ASSOCIATES
ENGINEERING CONSULTANTS, LLC
500 W. WISCONSIN AVENUE
NEW BERLIN, WI 53151
440 MILLWAUKEE AVENUE
BURLINGTON, WI 53105
(262) 402-2940



0 30'
SCALE
Project No.
23-5041
Drawn By: JIM
FRANK WOLF