



PLAT OF SURVEY – AS BUILT
LOTS 86, 87 & 88 OF BUENA VISTA PARK SUBDIVISION
PART OF THE NE 1/4 OF THE NW 1/4 OF SECTION 14, TOWN 1 NORTH, RANGE 16 EAST
VILLAGE OF FONTANA-ON-GENEVA, WALWORTH COUNTY, WISCONSIN

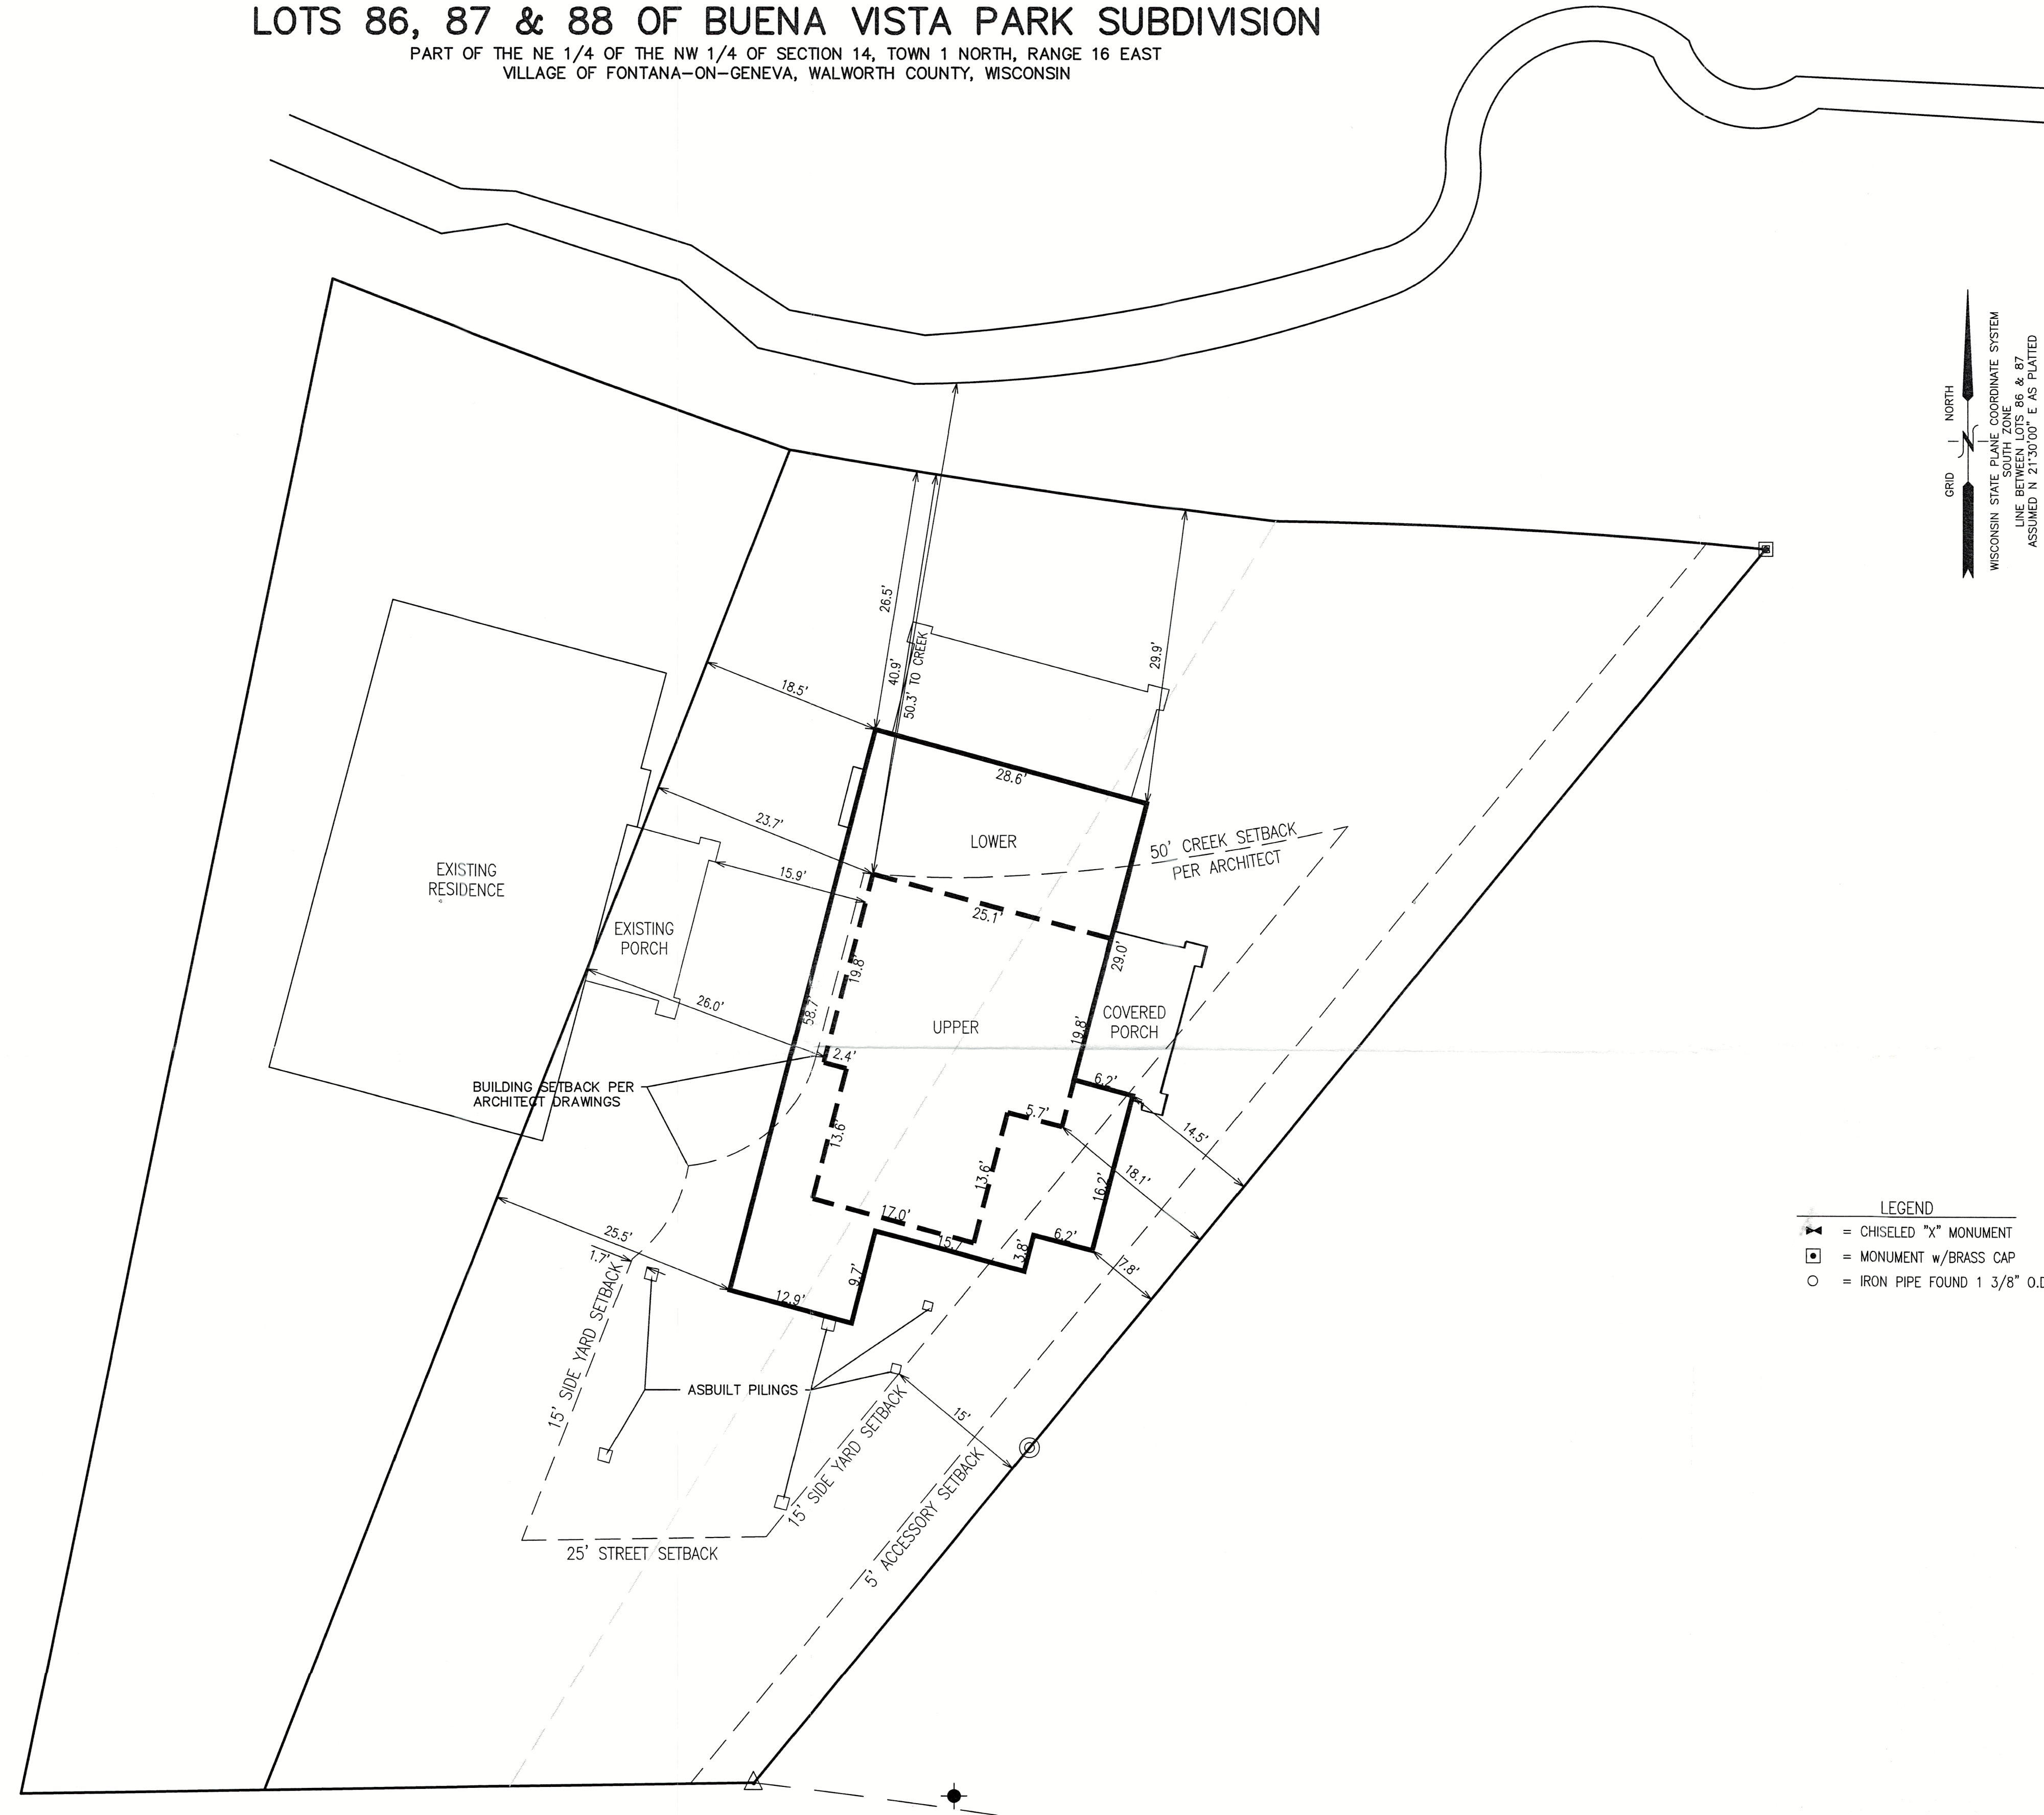


- LEGEND
- CHISELED "X" MONUMENT
 - MONUMENT w/BRASS CAP
 - IRON PIPE FOUND 1 3/8" O.D.

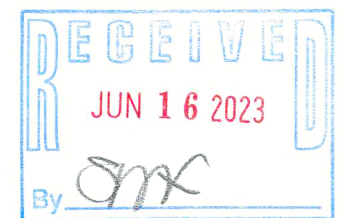

NOTE: COPIES OF THIS MAP TO WHICH THE FOLLOWING CERTIFICATE WILL APPLY SHOW THE SURVEYOR'S ORIGINAL SEAL AND SIGNATURE IN RED INK. COPIES BY ANY OTHER MEANS MAY HAVE ALTERATIONS WHICH DO NOT REPRESENT THE SURVEYOR'S WORK PRODUCT.

I HEREBY CERTIFY THAT THE ABOVE DESCRIBED PROPERTY HAS BEEN SURVEYED UNDER MY DIRECTION AND THAT THE ABOVE MAP IS A TRUE REPRESENTATION THEREOF AND SHOWS THE SIZE AND LOCATION OF THE PROPERTY AND ITS EXTERIOR BOUNDARIES. THIS SURVEY IS MADE FOR THE USE OF THE PRESENT OWNERS OF THE PROPERTY, AND ALSO THOSE WHO PURCHASE, MORTGAGE, OR GUARANTEE THE TITLE THERETO WITHIN ONE YEAR FROM THE DATE HEREOF.

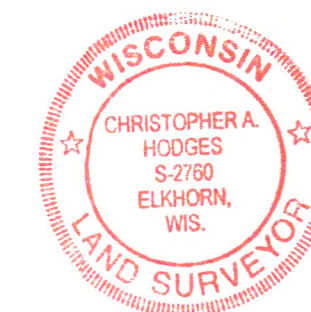


DATED: 8/04/2022
[signature]
CHRISTOPHER A. HODGES P.L.S. 2760

MAP SCALE IN FEET - ORIGINAL 1"=10'

X:\Projects\10736\CAD\10736D.dwg

CBV-63 CBV-64

005-3743

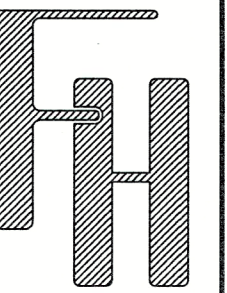

AS BUILT

338 FONTANA LANE
FONTANA, WI 53125

– WORK ORDERED BY –

FARRIS, HANSEN & ASSOCIATES, INC.
ENGINEERING – ARCHITECTURE – SURVEYING

7 RIDGWAY COURT P.O. BOX 437
ELKHORN, WISCONSIN 53121
OFFICE: (262) 723-2098 FAX: (262) 723-5886

REVISIONS

11-2-22
REV FOR CONTRACTOR &
ARCHITECT COMMENTS
1-23-23
REV PER CONTRACTOR
COMMENTS
2/09/2023 - DHC
AS BUILT
2/15/2023
ADDED PILINGS & NOTE
RE: REBUILT FOUNDATION

PROJECT NO.
10736

DATE
8/04/2022

SHEET NO.
1 OF 1