


HAROLD H. KOLB

REGISTERED PROFESSIONAL LAND SURVEYOR
LAKE GENEVA, WISCONSIN

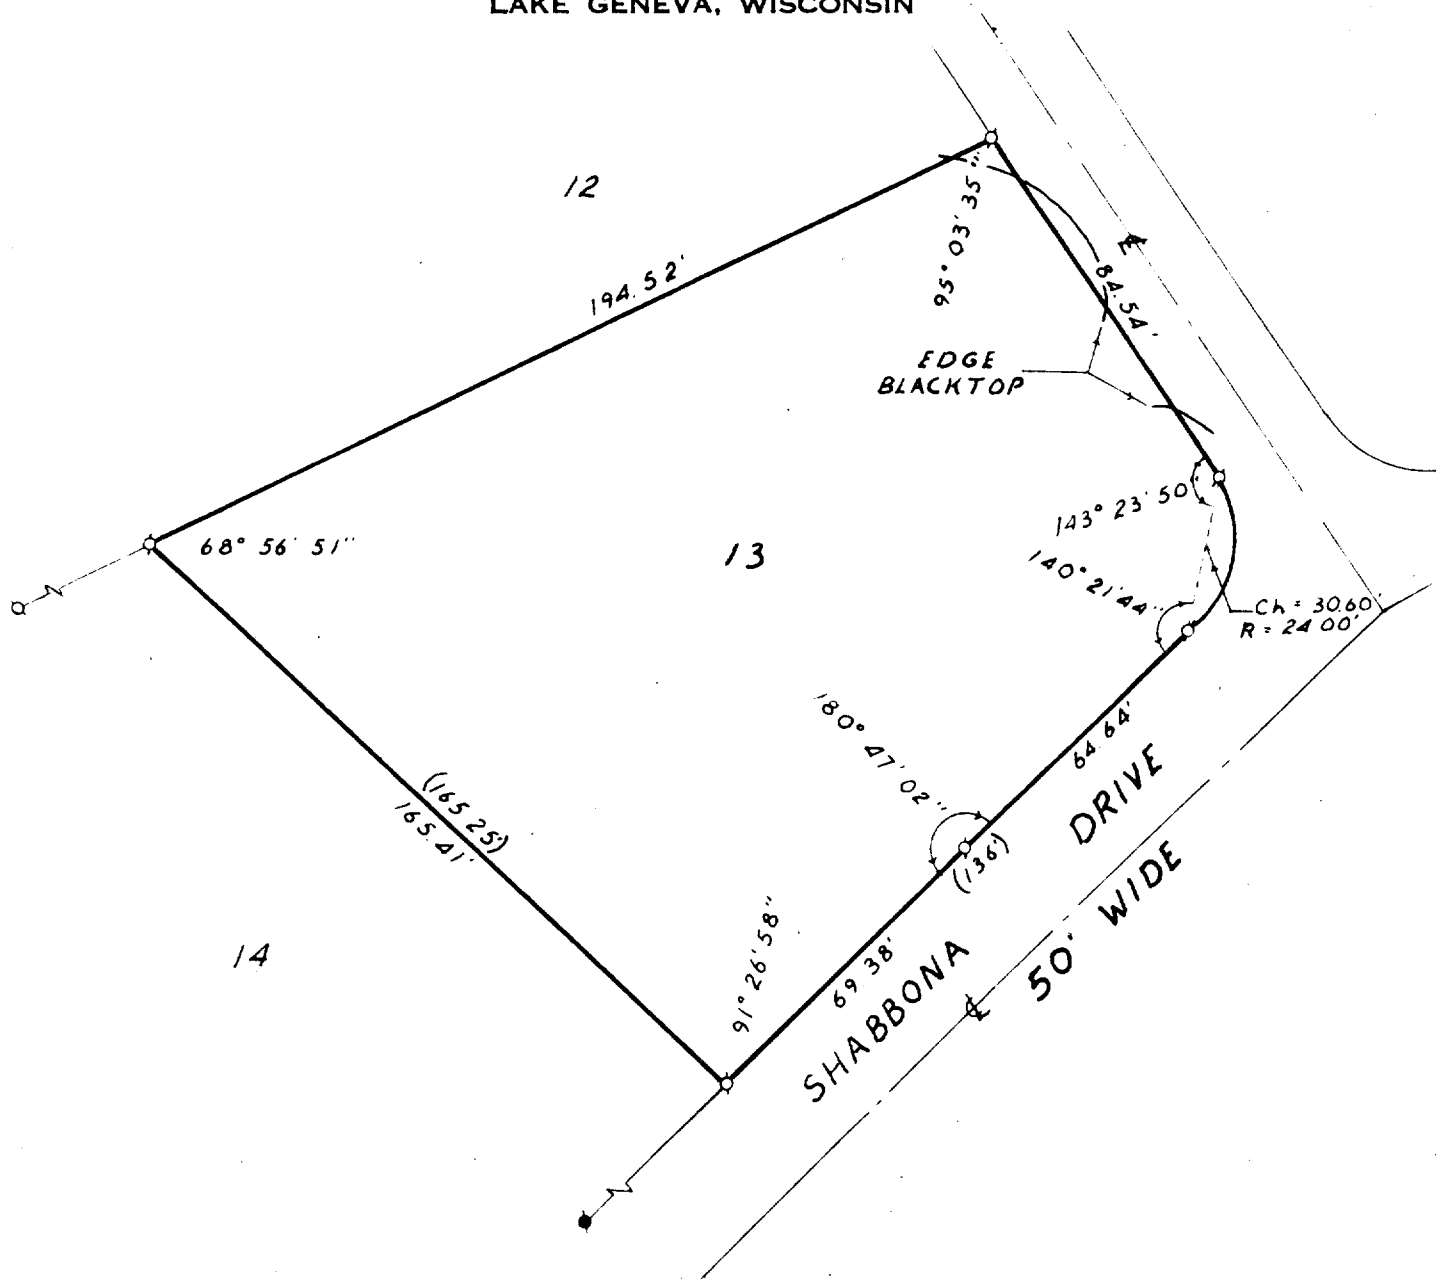


PLAN OF SURVEY OF

Lot 13, Unit 1, Country Club
Estate, Village of Fontana,
Walworth County, Wisconsin.

Owner; J. J. Hardy

Accuracy: Distances $\pm .01'$
Angles $\pm 5''$

Error of Closure less than 1/1000

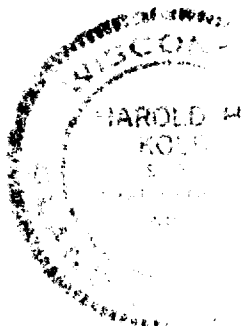

N



SCALE: 1" = 40'

LEGEND

- O — IRON PIPE PLACED.
- — CONCRETE MONUMENT, 5" DIA. x 30" FOUND
- — IRON PIPE FOUND
- () — AS PLATTED

HAROLD H. KOLB
WISCONSIN REGISTERED LAND SURVEYOR, S-187
DATE 2-1-77

5-375