


**HAROLD H. KOLB**  
REGISTERED PROFESSIONAL LAND SURVEYOR  
LAKE GENEVA, WISCONSIN

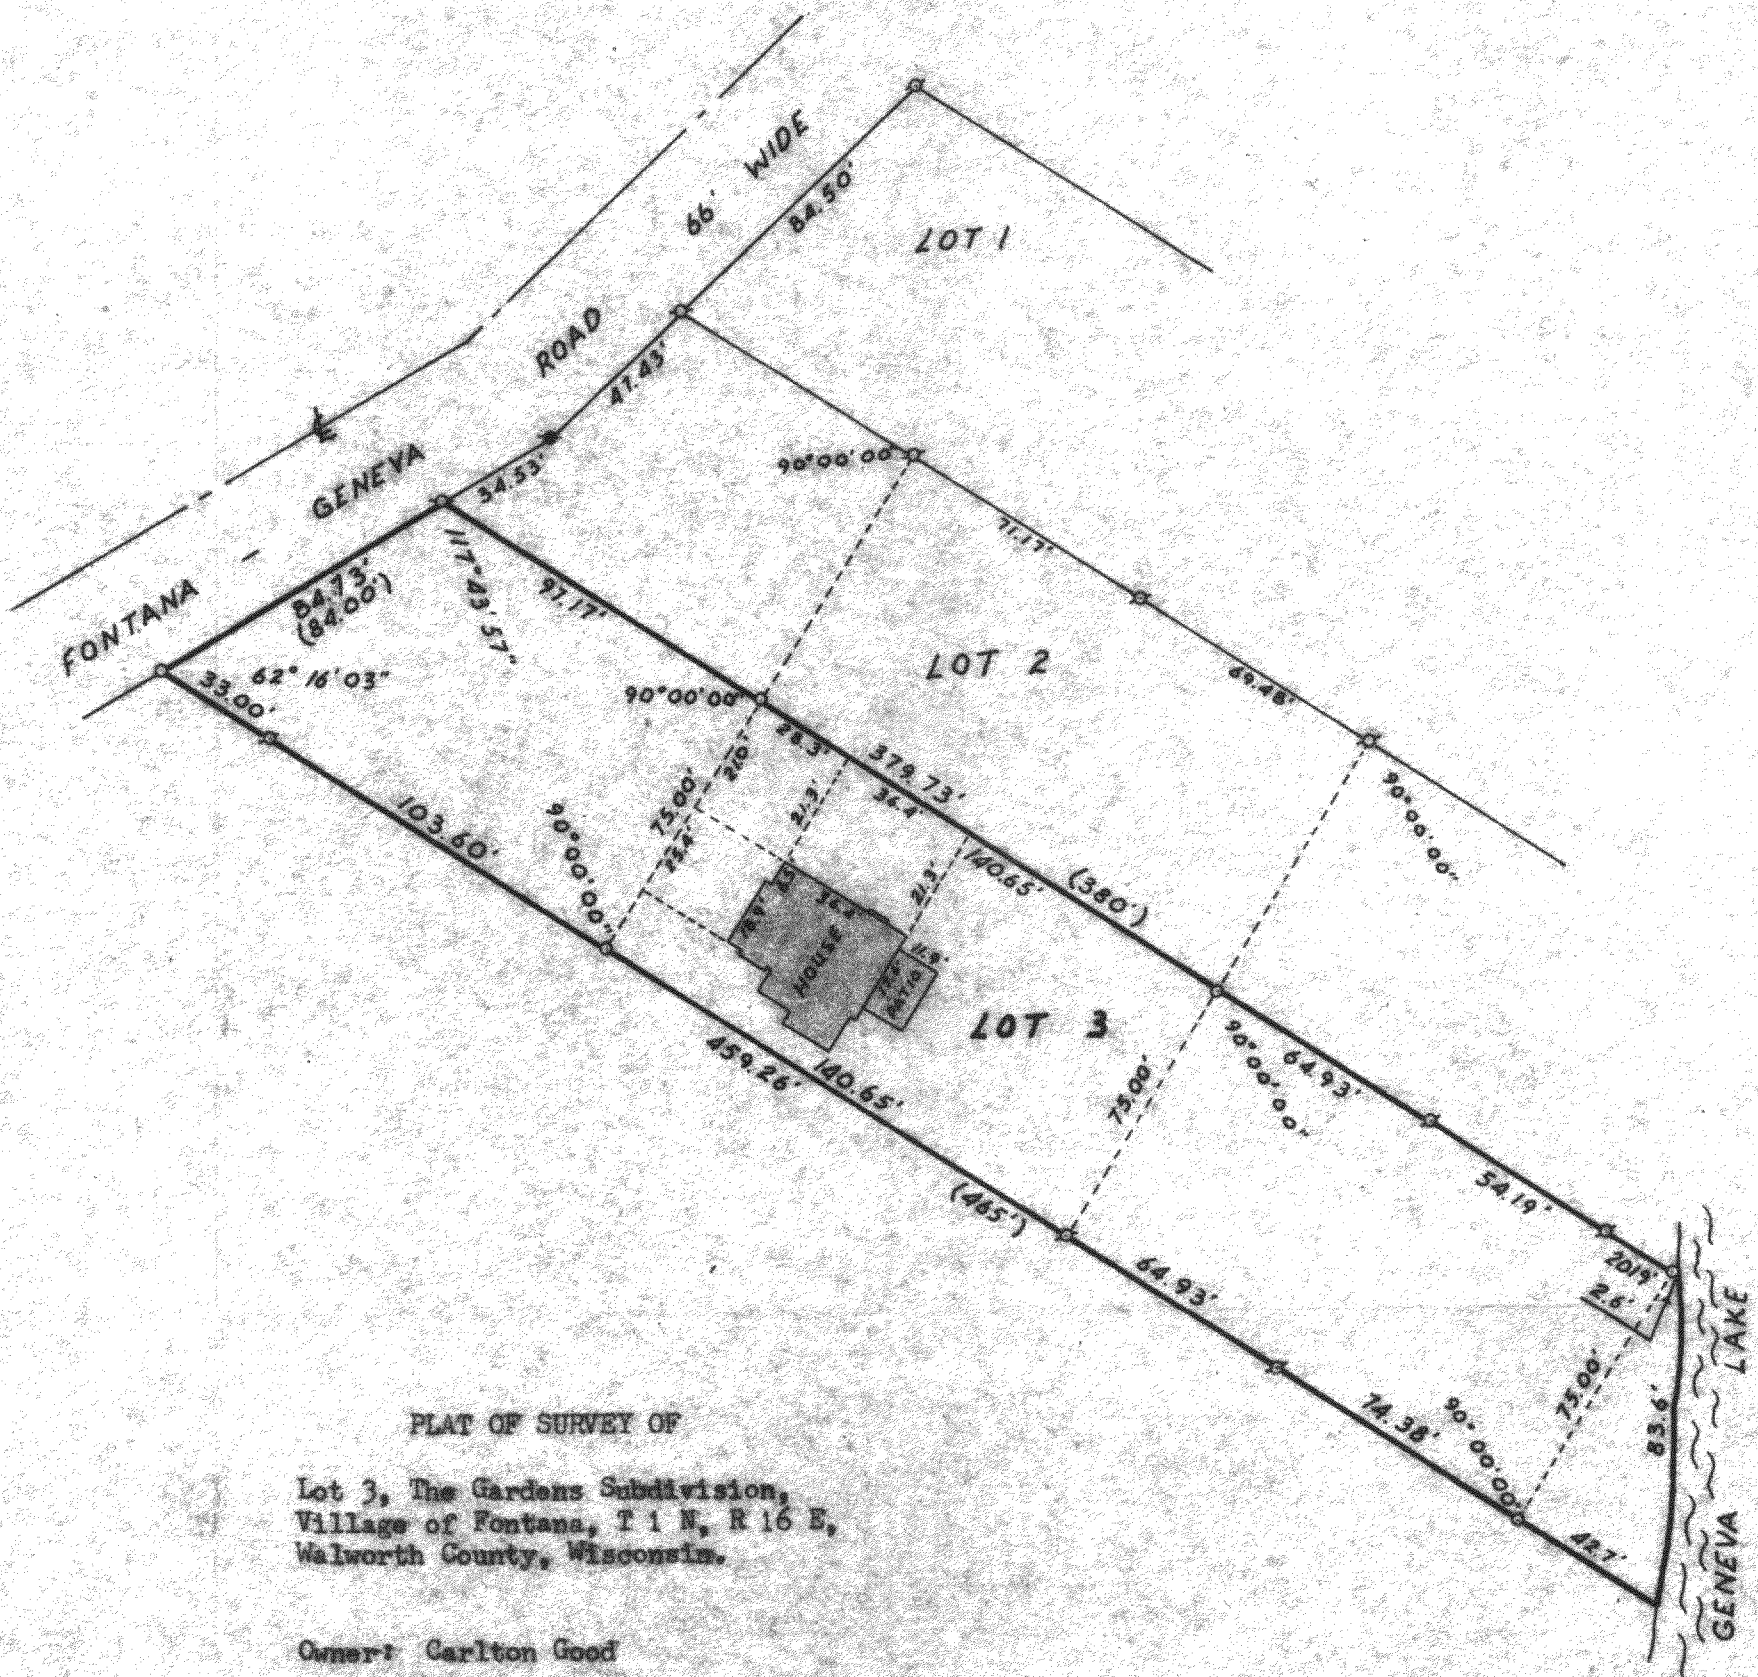

PLAT OF SURVEY OF

Lot 3, The Gardens Subdivision,  
Village of Fontana, T 1 N, R 16 E,  
Walworth County, Wisconsin.

Owner: Carlton Good

Accuracy: Distances: 0.01'  
Angles: 05"

Error of Closure Less than 1/3000


N



SCALE: 1" = 50'

**LEGEND**

- φ - IRON PIPE FOUND
- - IRON PIPE PLACED
- ⊙ - IRON ROD FOUND
- x - SPIKE
- ( ) - AS PLATTED

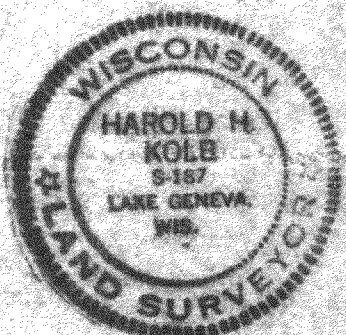

I, HAROLD H. KOLB, DO HEREBY CERTIFY THAT I HAVE SURVEYED THE PROPERTY HEREON DESCRIBED ACCORDING TO THE OFFICIAL RECORDS, AND THAT THE PLAT HEREON IS A CORRECT REPRESENTATION OF THE LOT LINES.

*Harold H. Kolb*

HAROLD H. KOLB  
WISCONSIN REGISTERED LAND SURVEYOR, S-187  
DATE Sept. 20, 1974

56-2

5-377