

HAROLD H. KOLB

REGISTERED PROFESSIONAL LAND SURVEYOR
LAKE GENEVA, WISCONSIN

PLAT OF SURVEY OF
Lots 47 and 60, Buena Vista Park Sub-
division, Village of Fontana-on-Geneva
Lake, Walworth County, Wisconsin.

OWNER: Eugene Bradtke
111 W. Washington St.
Chicago, Ill. 60602



ACCURACY: Distance $\pm 0.01'$
Angles $\pm 05''$
Error of closure less
than 1/3000



SCALE 1" = 40'

LEGEND

- φ — IRON PIPE FOUND
- — IRON PIPE PLACED
- — CONCRETE MONUMENT
- x — SPIKE
- () — As Platted

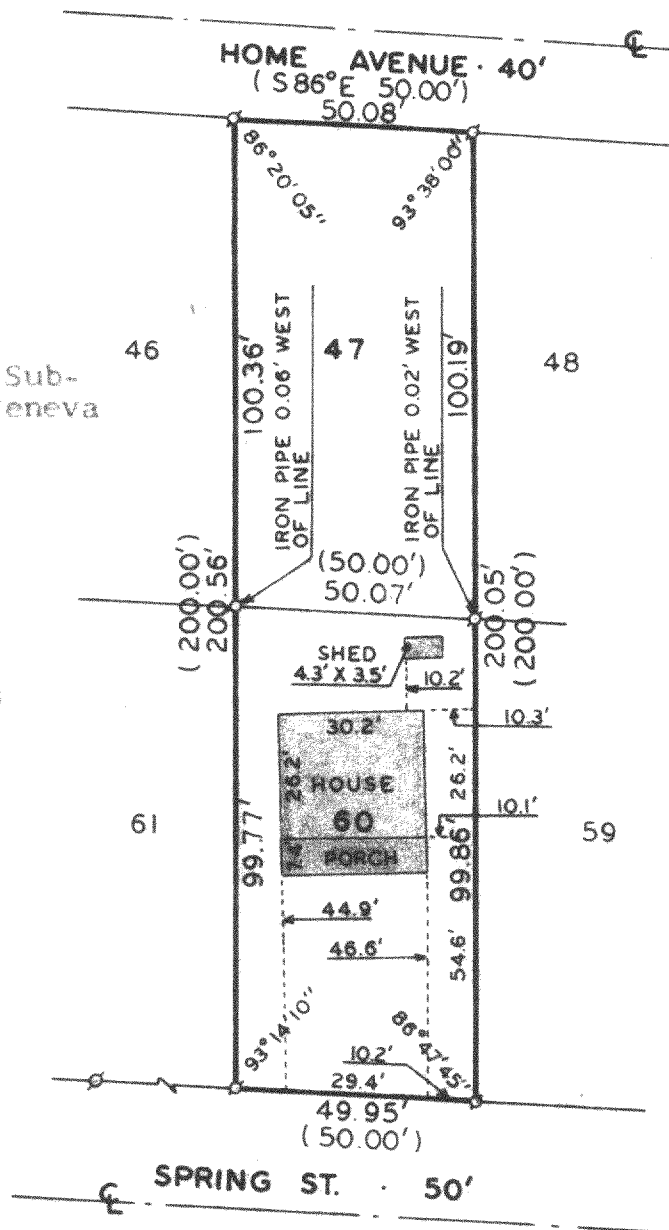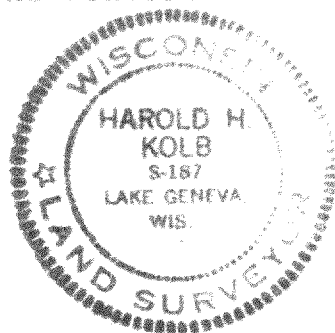

I, HAROLD H. KOLB, DO HEREBY CERTIFY THAT I HAVE
SURVEYED THE PROPERTY HEREON DESCRIBED ACCORDING
TO THE OFFICIAL RECORDS, AND THAT THE PLAT HEREON
IS A CORRECT REPRESENTATION OF THE LOT LINES, and
the principle lines of the buildings thereon.

Harold H. Kolb
HAROLD H. KOLB
WISCONSIN REGISTERED LAND SURVEYOR, S-187
DATE Dec. 12, 1974

SR0-34, 41

5-381