


HAROLD H. KOLB

REGISTERED PROFESSIONAL LAND SURVEYOR
LAKE GENEVA, WISCONSIN

10' wide easement as described
in volume 509 page 395, Document
No. 488959, Deeds, Walworth County

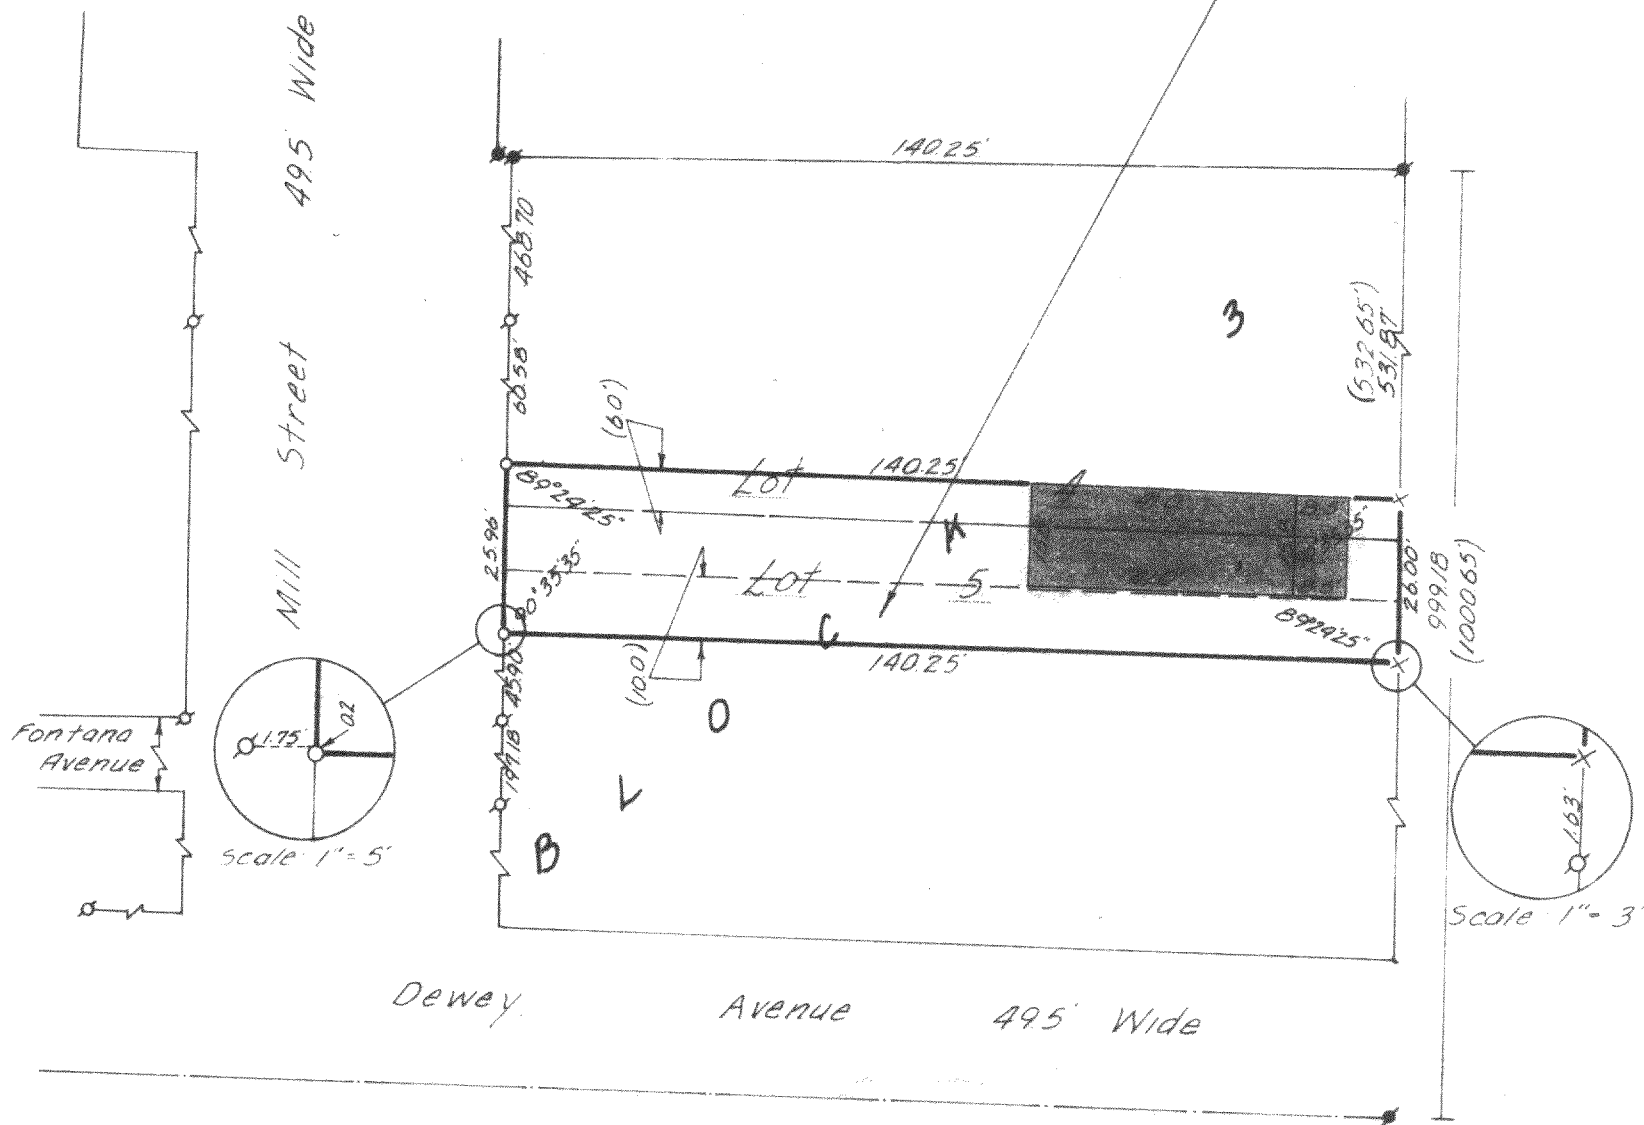

PLAT OF SURVEY OF


The South 6 feet of Lot 4 and the North 20 feet of
Lot 5, Block 3, Assessor's Plat Number 1, C. L. Donnell's
Addition to the Village of Fontana-on-Geneva Lake,
Walworth County, Wisconsin.

OWNER: Conroy Realty Co.

ACCURACY: Distances $\pm 0.01'$
Angles $\pm 15"$
Error of closure less
than 1/3000

N
SCALE- 1"= 30'
LEGEND

- φ - IRON PIPE FOUND
- O - IRON PIPE PLACED
- - CONCRETE MONUMENT
- x - SPIKE (Railroad)
- () - Platted As

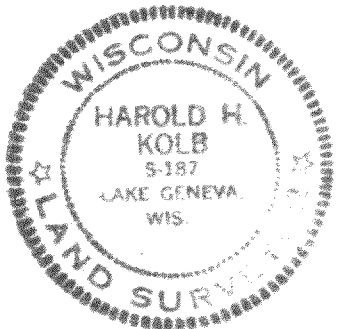

I, HAROLD H. KOLB, DO HEREBY CERTIFY THAT I HAVE
SURVEYED THE PROPERTY HEREON DESCRIBED ACCORDING
TO THE OFFICIAL RECORDS, AND THAT THE PLAT HEREON
IS A CORRECT REPRESENTATION OF THE LOT LINES.

Harold H. Kolb
HAROLD H. KOLB
WISCONSIN REGISTERED LAND SURVEYOR, S-187
DATE Nov. 22, 1974

STFU-192

5-384