




STATE TRUNK HIGHWAY #36

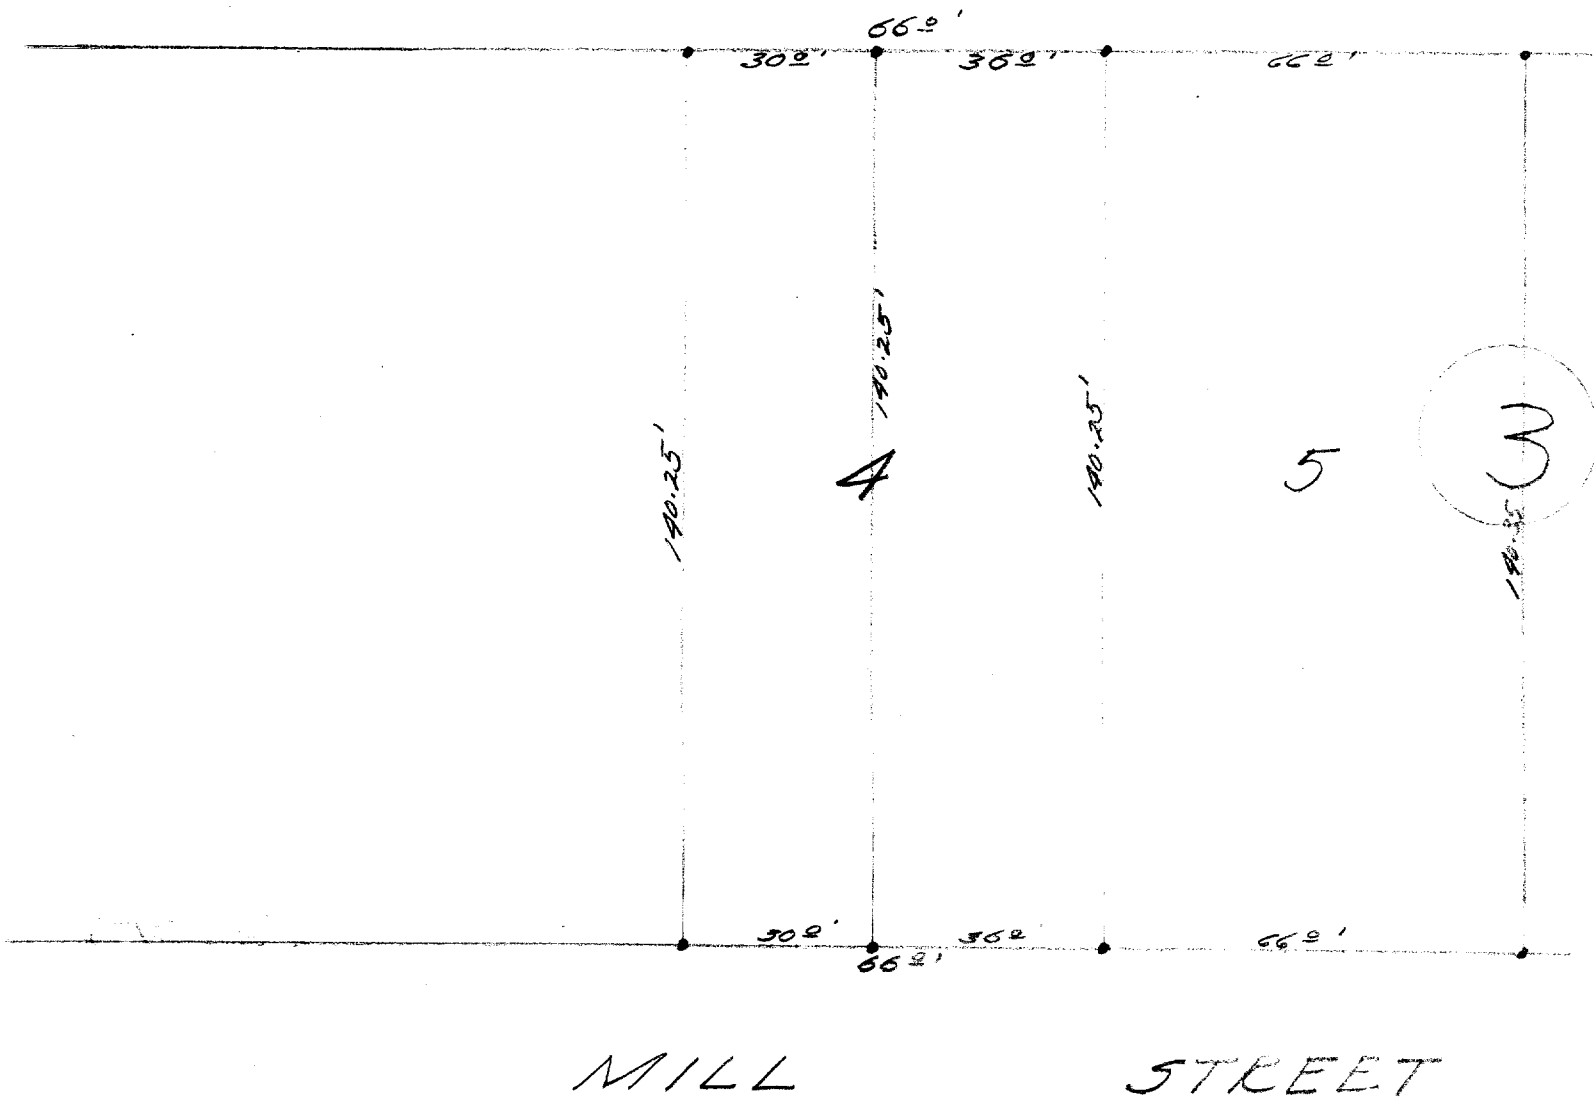

DESCRIPTION:

The North 30 feet of Lot 4, Block 3; Assessor's Plat Number One, C. L. Douglass Addition to the Village of Fontana, Walworth County, Wisconsin.

DESCRIPTION:

The South 36 feet of Lot 4, Block 3; Assessor's Plat Number One, C.L. Douglass Addition to the Village of Fontana, Walworth County, Wisconsin.

CERTIFICATE:

I, hereby certify that I have on this the fifteenth day of November 1949, surveyed the aboves described properties, according to the official records on file in the office of the Recorder of Deeds in and for Walworth County, Wisconsin, and find that the measurements and bearings of the boundaries of said property as taken at the site on this day substantially agree with those in said official record and that no encroachments exist.

SIGNED AND SEALED THIS 16TH DAY OF NOVEMBER 1949

Joseph M. Biagi
Joseph M. Biagi. Professional Engineer
Elkhorn Wisconsin.