

HAROLD H. KOLB

REGISTERED PROFESSIONAL LAND SURVEYOR
LAKE GENEVA, WISCONSIN

LAKE SHORE DRIVE - 49.5' WIDE

PLAT OF SURVEY OF

LOT 1, BLOCK 4, BROOKWOOD
SUBDIVISION, VILLAGE OF
FONTANA-ON-GENEVA-LAKE,
WALWORTH COUNTY, WISCONSIN.

OWNER: RONALD J. POLSTER
529 BRIAR LANE
LAKE FOREST, IL 60045

ACCURACY: DISTANCES 0.01'
ANGLES 05"
ERROR OF CLOSURE LESS
THAN 1/3000



N



SCALE: 1" = 50'

LEGEND

- φ - IRON PIPE FOUND
- - IRON PIPE PLACED
- - CONCRETE MONUMENT
- x - SPIKE

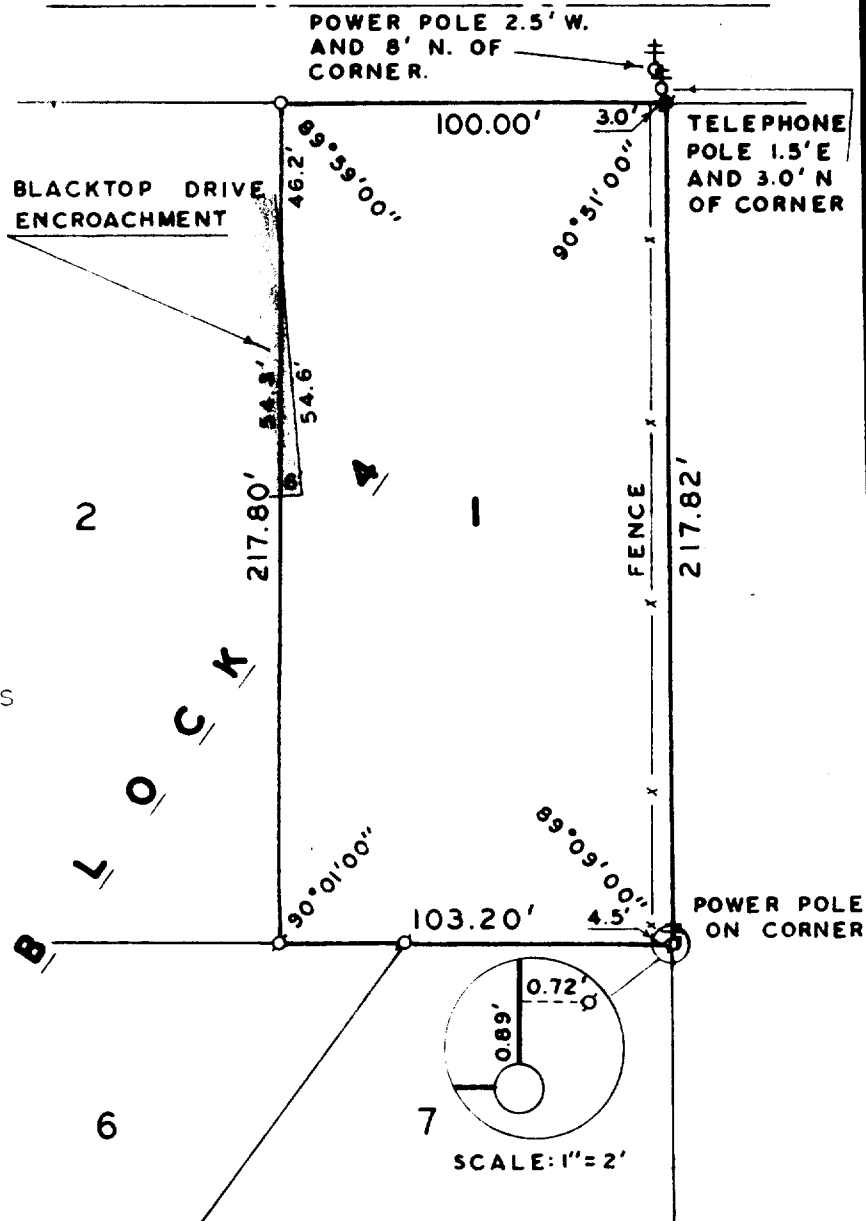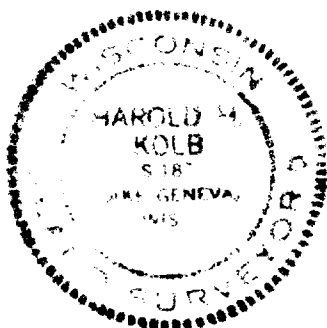

I, HAROLD H. KOLB, DO HEREBY CERTIFY THAT I HAVE
SURVEYED THE PROPERTY HEREON DESCRIBED ACCORDING
TO THE OFFICIAL RECORDS, AND THAT THE PLAT HEREON
IS A CORRECT REPRESENTATION OF THE LOT LINES.

Harold H. Kolb

HAROLD H. KOLB
WISCONSIN REGISTERED LAND SURVEYOR, S-187
DATE Aug 25, 1975

SBS-37

5-401