


# HAROLD H. KOLB

REGISTERED PROFESSIONAL LAND SURVEYOR  
LAKE GENEVA, WISCONSIN



N

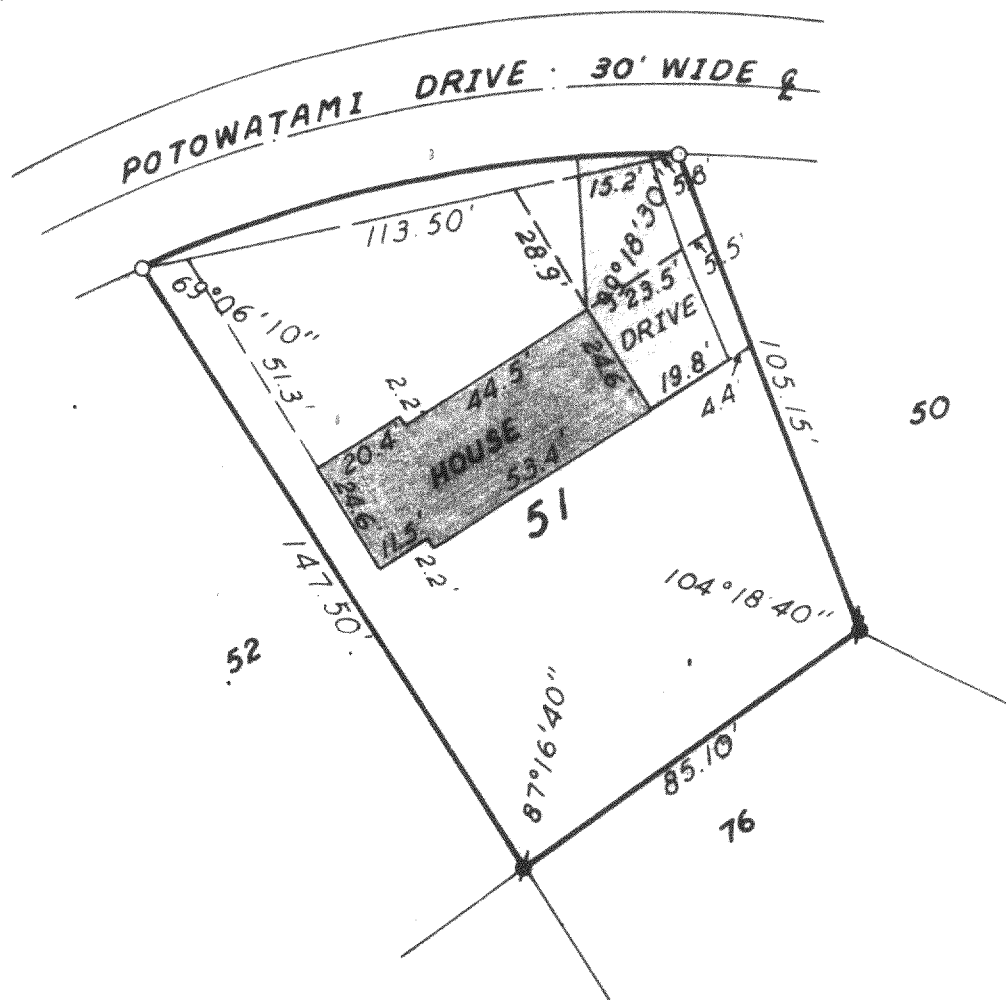

SCALE: 1"=40'

## LEGEND

- φ — IRON PIPE FOUND
- — IRON PIPE PLACED
- — CONCRETE MONUMENT
- x — SPIKE

PLAT OF SURVEY OF  
LOT 51, UNIT 2 OF COUNTRY CLUB ESTATES,  
VILLAGE OF FONTANA-ON-GENEVA LAKE, WALWORTH  
COUNTY, WISCONSIN.


OWNER: LEE SIUDZINSKI

ACCURACY: ANGLES  $\pm 05''$   
DISTANCES  $\pm 0.01'$   
ERROR OF CLOSURE—  
LESS THAN  $1/3000$

I, HAROLD H. KOLB, DO HEREBY CERTIFY THAT I HAVE  
SURVEYED THE PROPERTY HEREON DESCRIBED ACCORDING  
TO THE OFFICIAL RECORDS, AND THAT THE PLAT HEREON  
IS A CORRECT REPRESENTATION OF THE LOT LINES, & THE  
PRINCIPLE LINES OF THE BUILDINGS THEREON.

*Harold H. Kolb*

HAROLD H. KOLB  
WISCONSIN REGISTERED LAND SURVEYOR, S-187  
DATE JULY 3, 1975

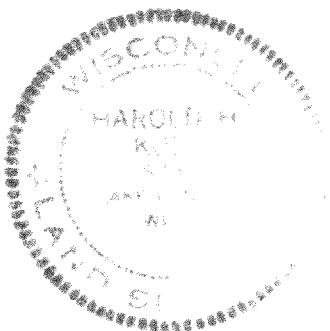

5-402