

HAROLD H. KOLB

REGISTERED PROFESSIONAL LAND SURVEYOR
LAKE GENEVA, WISCONSIN

PLAT OF SURVEY OF

PART OF LOT 4, BLOCK 3, C. L.
DOUGLAS ADDITION TO THE VILLAGE
OF FONTANA-ON-GENEVA LAKE, WAL-
WORTH COUNTY, WISCONSIN, AS
DESCRIBED IN VOL. 76, PAGE 193
OF DEEDS.

OWNER: MERLIN F. KITTLE

ACCURACY: DISTANCE $\pm 0.01'$
ANGLES $\pm 05''$
ERROR OF CLOSURE
LESS THAN 1/3000

NOTE: PROPORTIONAL DIMENSIONS
USED BETWEEN EXISTING
MONUMENTS.



N



SCALE: 1"=50'

LEGEND

- φ — IRON PIPE FOUND
- — IRON PIPE PLACED
- — CONCRETE MONUMENT
- x — SPIKE
- () — AS RECORDED

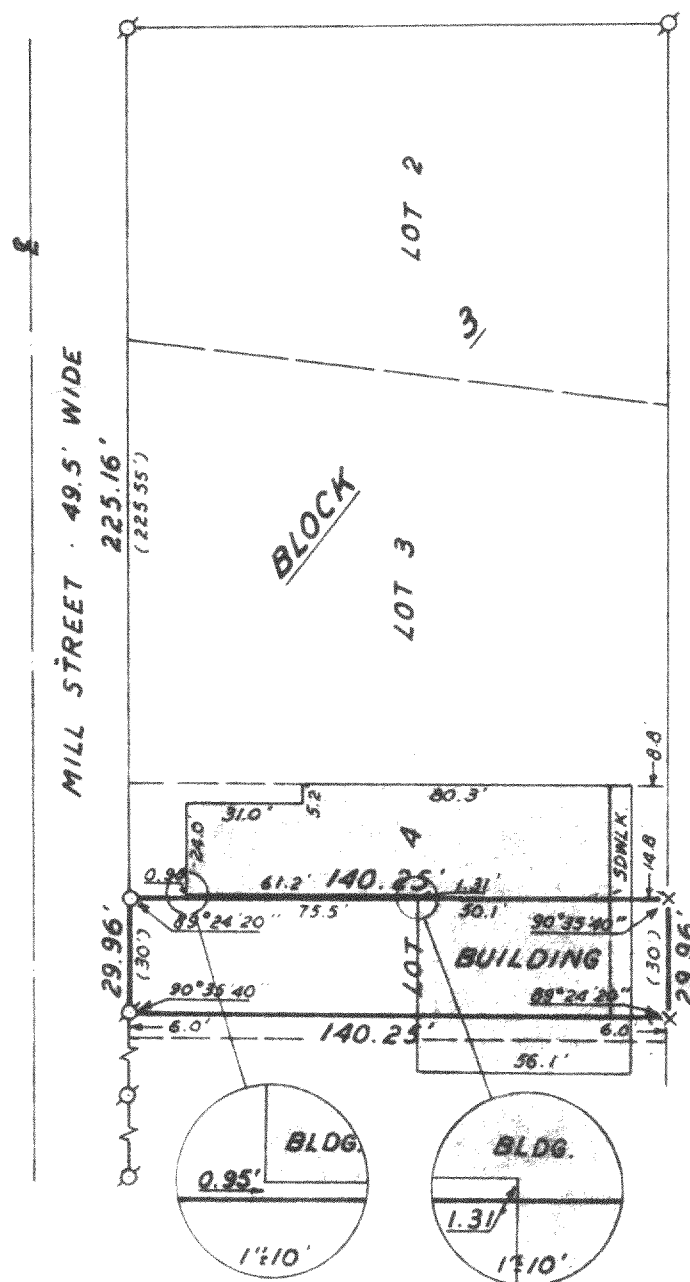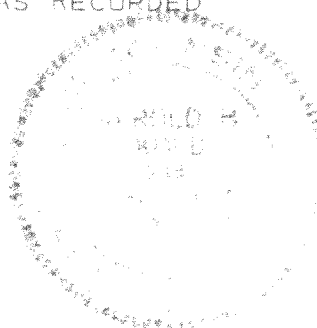

I, HAROLD H. KOLB, DO HEREBY CERTIFY THAT I HAVE
SURVEYED THE PROPERTY HEREON DESCRIBED ACCORDING
TO THE OFFICIAL RECORDS, AND THAT THE PLAT HEREON
IS A CORRECT REPRESENTATION OF THE LOT LINES.

Harold H. Kolb

HAROLD H. KOLB
WISCONSIN REGISTERED LAND SURVEYOR, S-187
DATE Oct. 9, 1975

5-403