



NOTE: IN ALL FORMER SURVEYS OF THIS AREA THE WESTERLY LINE OF LOT 8 WAS FOUND TO BE THE LENGTH AS SHOWN AND WAS SO USED IN THIS SURVEY.

CONC. MONU. THAT IS LOCATED 310.3' SOUTH AND 1015' S58°45'E OF THE SE CORNER OF THE NE 1/4 OF THE NW 1/4 OF SEC. 11, T1N R16E.

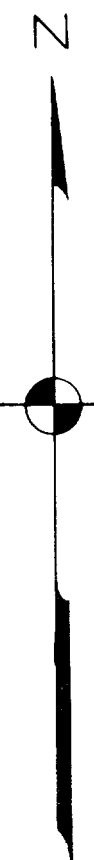

SCALE ~ 1" = 30'
O = IRON PIPE
● = CONC. MONU.

BUILDING UP TO LINE
EAVES OVER 10 INCHES
EAVES OVER 14 INCHES

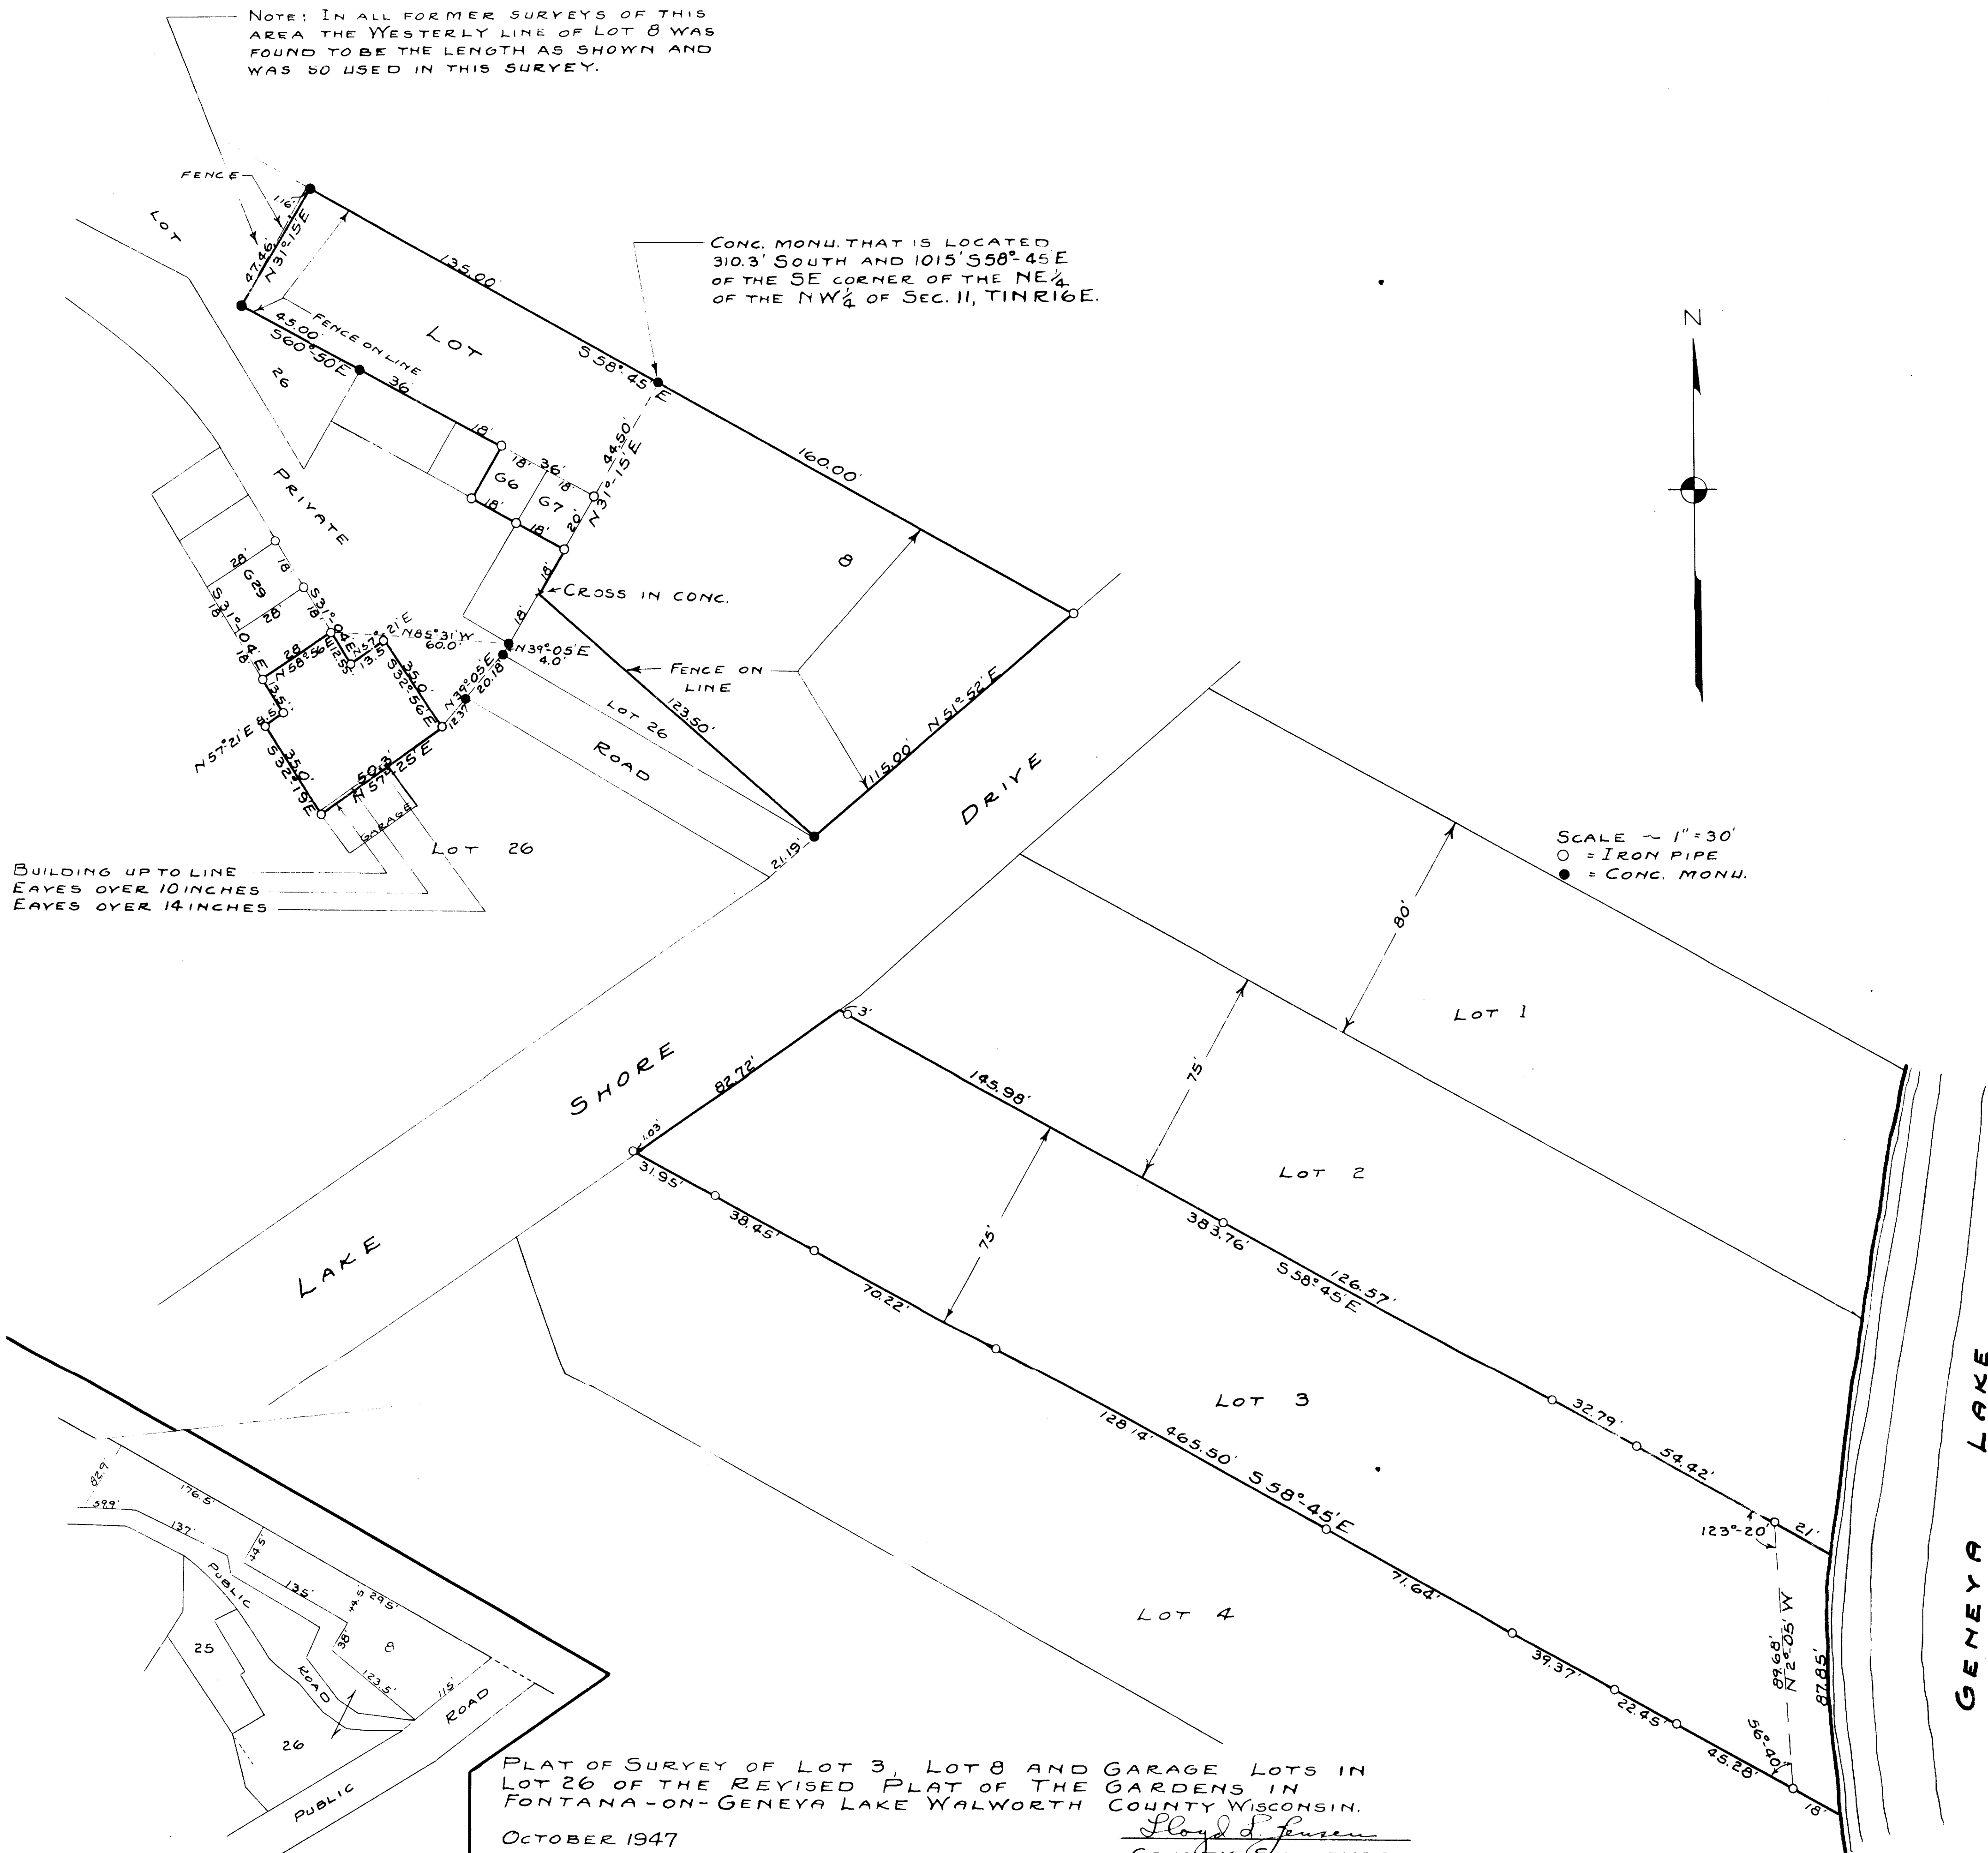

PLAT OF SURVEY OF LOT 3, LOT 8 AND GARAGE LOTS IN LOT 26 OF THE REVISED PLAT OF THE GARDENS IN FONTANA-ON-GENEVA LAKE WALWORTH COUNTY WISCONSIN.

OCTOBER 1947

Lloyd S. Jensen
COUNTY SURVEYOR

LOCATION DRAWING OF LOTS SURVEYED
LYING NORTHWEST OF LAKE SHORE
DRIVE - COPY OF ORIGINAL PLAT