


HAROLD H. KOLB

REGISTERED PROFESSIONAL LAND SURVEYOR
LAKE GENEVA, WISCONSIN

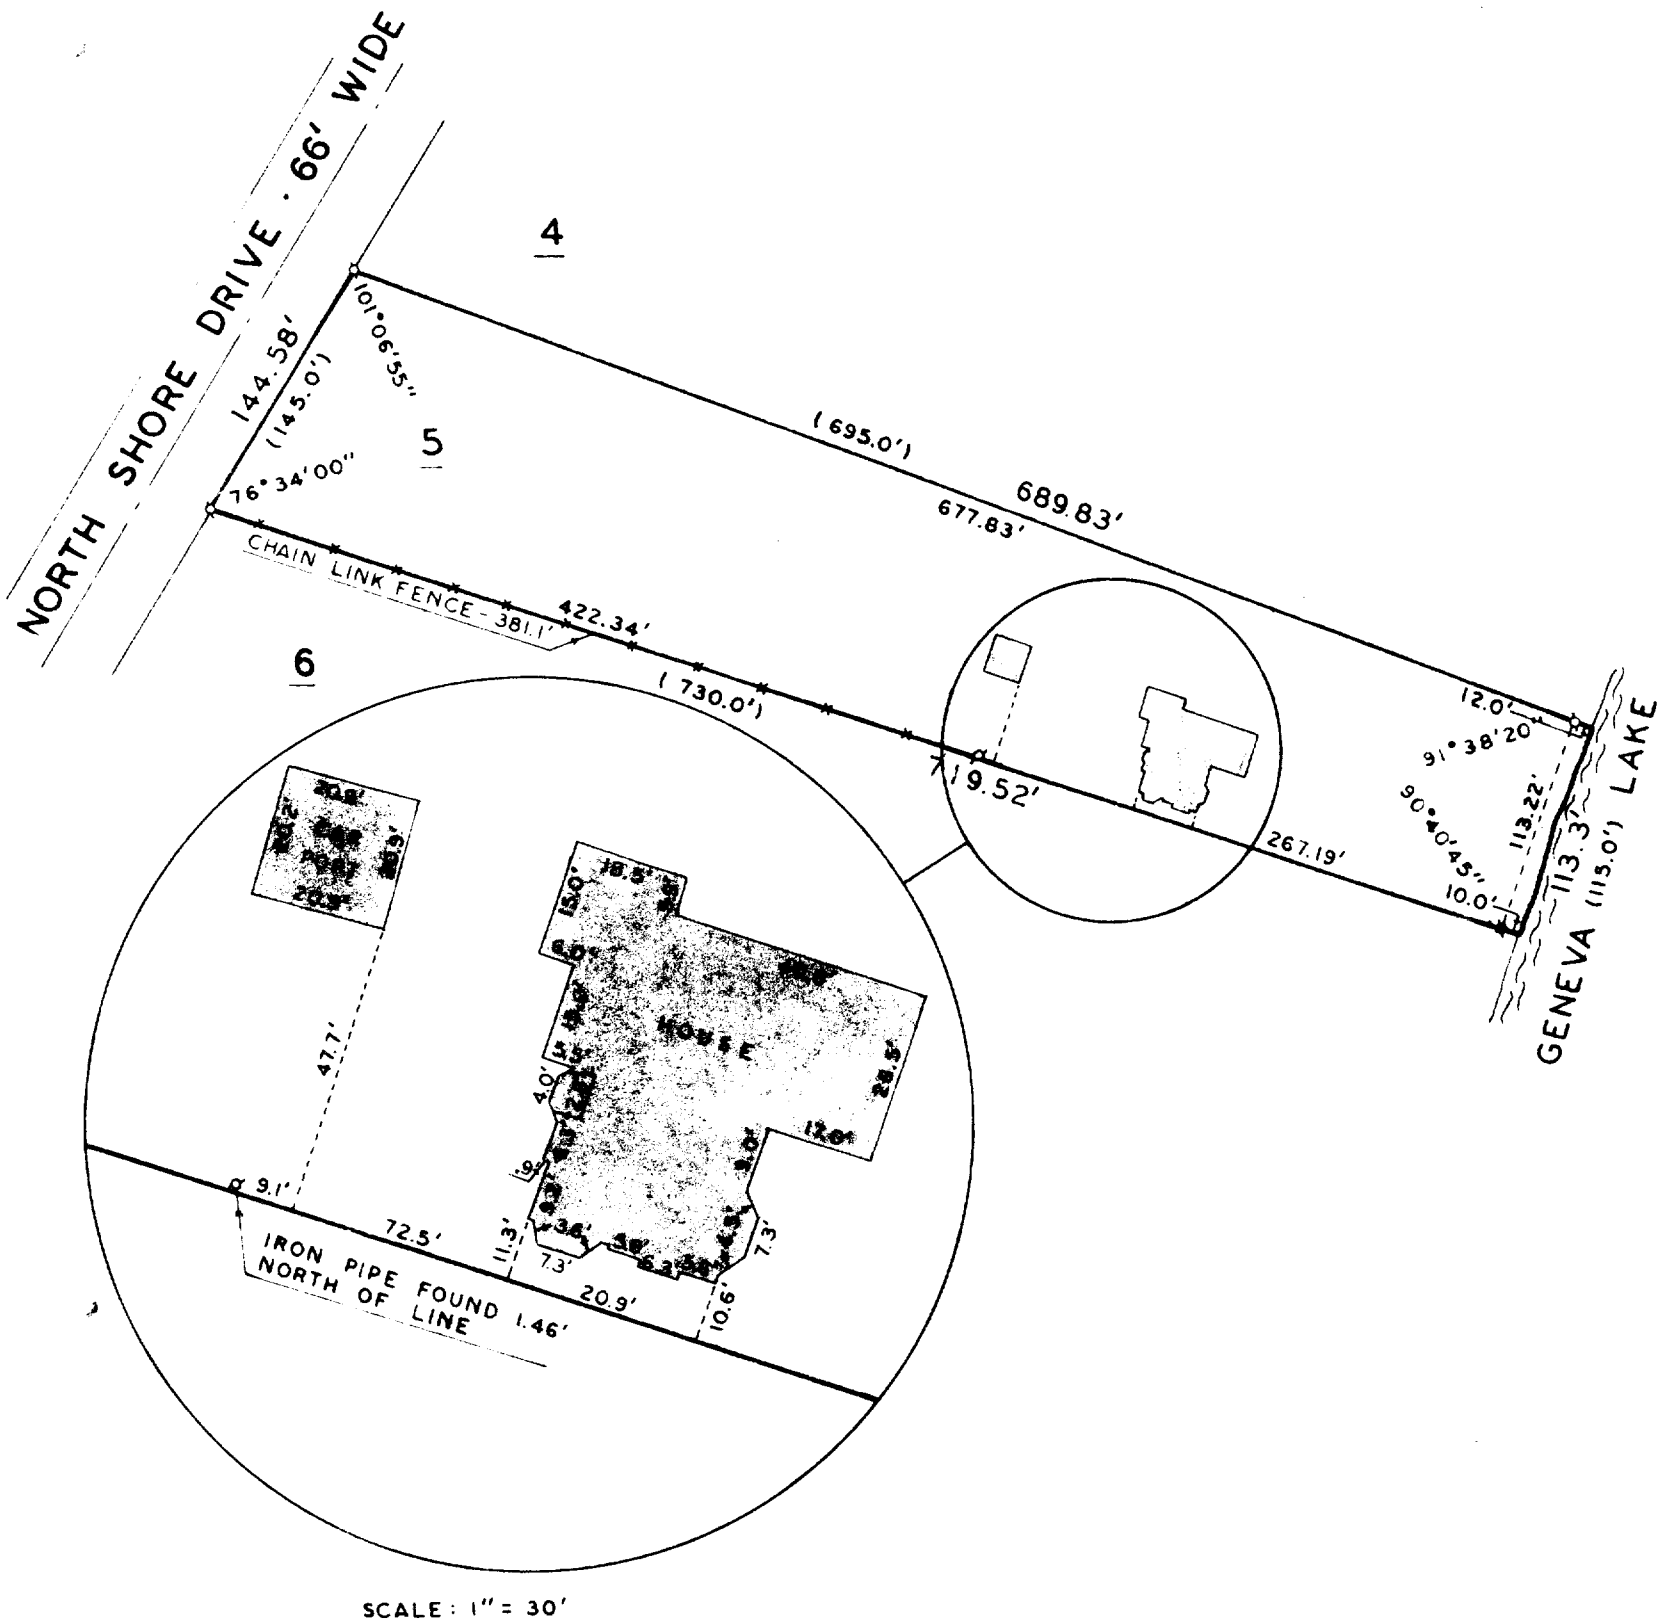

PLAT OF SURVEY OF

LOT 5, STEARN'S AND GEROULD'S SUBDIVISION, VILLAGE OF FONTANA-
ON GENEVA LAKE, SECTION 11, T 1 N, R 16 E, WALWORTH COUNTY,
WISCONSIN.

OWNER: PHILLIP D. ELBERT

ACCURACY: DISTANCE $\pm 0.01'$
ANGLES $\pm 05''$
ERROR OF CLOSURE LESS THAN 1/3000


N



SCALE: 1" = 100'

LEGEND

- φ - IRON PIPE FOUND
- O - IRON PIPE PLACED
- - IRON ROD FOUND
- x - SPIKE
- () - AS PLATTED

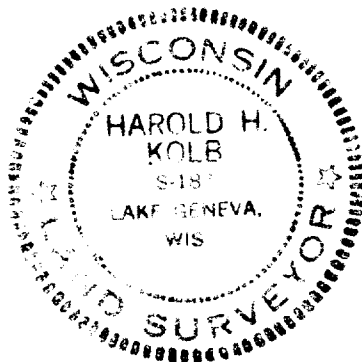

I, HAROLD H. KOLB, DO HEREBY CERTIFY THAT I HAVE
SURVEYED THE PROPERTY HEREON DESCRIBED ACCORDING
TO THE OFFICIAL RECORDS, AND THAT THE PLAT HEREON
IS A CORRECT REPRESENTATION OF THE LOT LINES.

Harold H. Kolb

HAROLD H. KOLB
WISCONSIN REGISTERED LAND SURVEYOR, S-187
DATE Dec. 5, 1975

5576-5

5-421