

LEGEND

- = Found Iron Pipe shown on earlier survey by Willson
- △ = Found Iron Pipe shown on earlier survey by Willson and used as primary control to reconstruct survey
- = Found iron rod indicated on Certified Survey No. 661
- ⊙ = Set Iron Pipe survey stake
- (***) = Dimension indicated on Willson survey

Legal description of land surveyed


Lot 9 of Stearns and Gerould's Subdivision located in the South 1/2 of Section 11, Town 1 North, Range 16 East, Village of Fontana-on-Geneva Lake, Walworth County, Wisconsin.

Work ordered by Carl Reeves for Keefe Real Estate, Inc.

I hereby certify that I have surveyed the property described hereon; that this Plat of Survey is a retracement of a Plat of Survey of this same parcel done by George B. Wilson dated October 25, 1966 and correctly shows the dimensions of the boundary and location of all principal structures located thereon to the best of my professional knowledge and belief.

REVISED 32ND DAY OF SEPTEMBER 1980
Dated this 18 day of Sept, 1980

Daniel D Cooper
Daniel D. Cooper, RLS No. S-1464

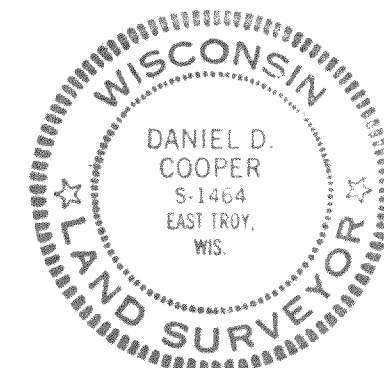

FARRIS, HANSEN & COOPER, INC.
ENGINEERING, SURVEYING AND LAND PLANNING
715 W. WALWORTH ST. - P.O. Box 487 - ELKHORN, WI 53121

SEPT, 18, 1980
PROJECT 1751

5-421-F