


Garage on Lot 3 of Block 4 of Brookwood Sub
located in Government Lot 4, Sec. 18, T. 1 N., R. 17 E.
Walworth County, Wisconsin for Kenneth Kanarowski

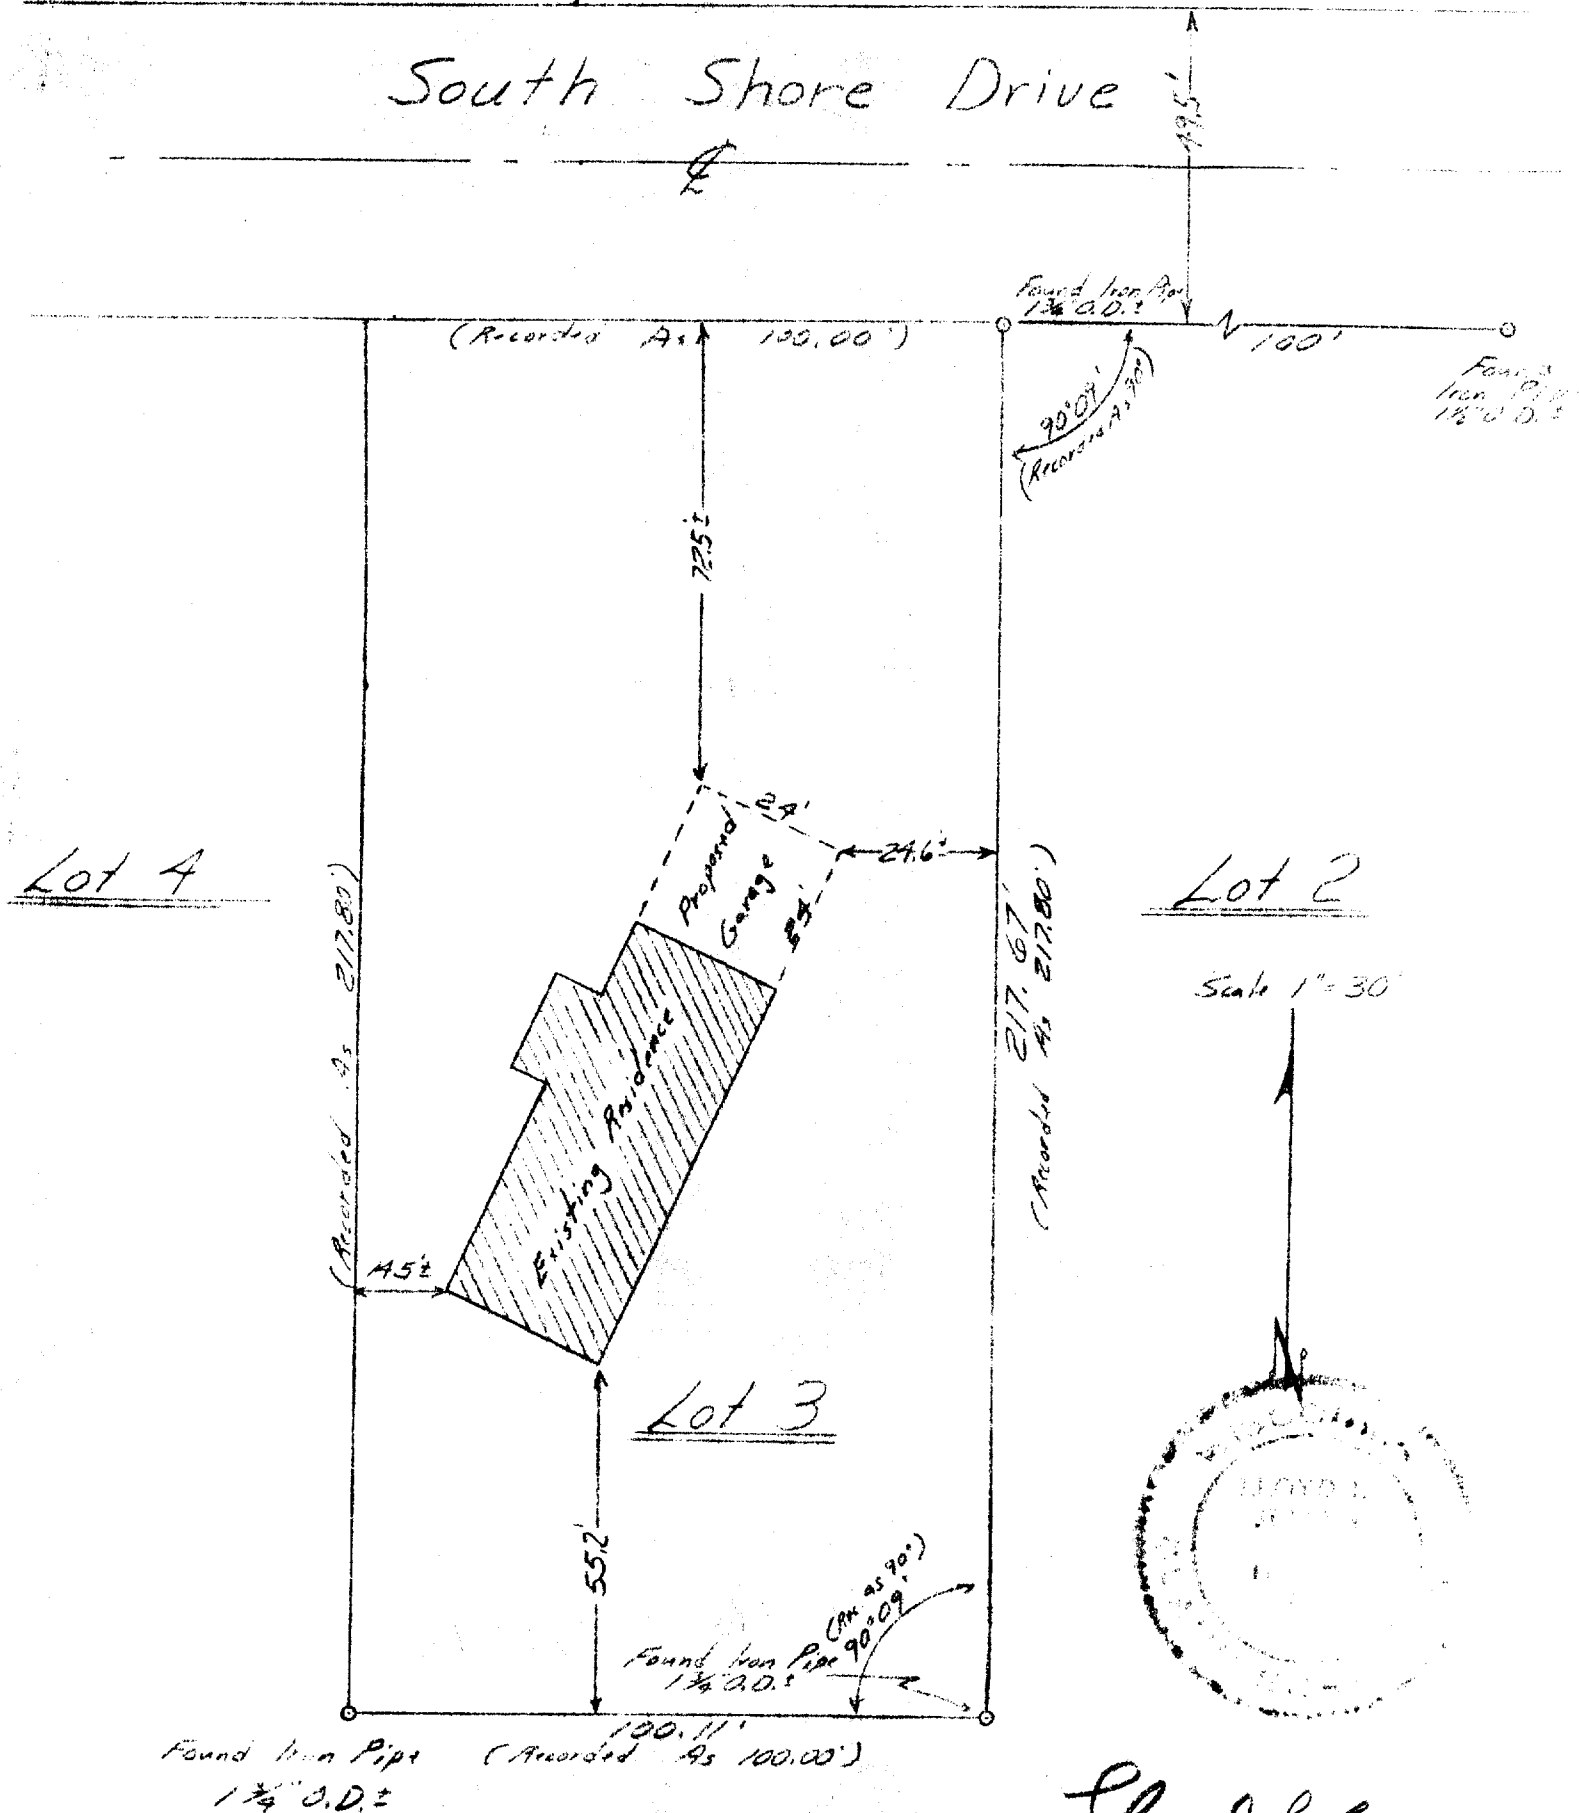

Lloyd L. Jensen
Lloyd L. Jensen 5-211

5-427