


UNIT 170 OF ABBEY SPRINGS

Beginning at the Northeast corner of Unit 171 of Abbey Springs; thence S88°-44'E, 80.00 feet; thence S1°-16'W, 214.48 feet; thence N81°-24'W, 80.65 feet; thence N1°-16'E, 204.16 feet to the point of beginning, containing 0.3844 acres more or less.

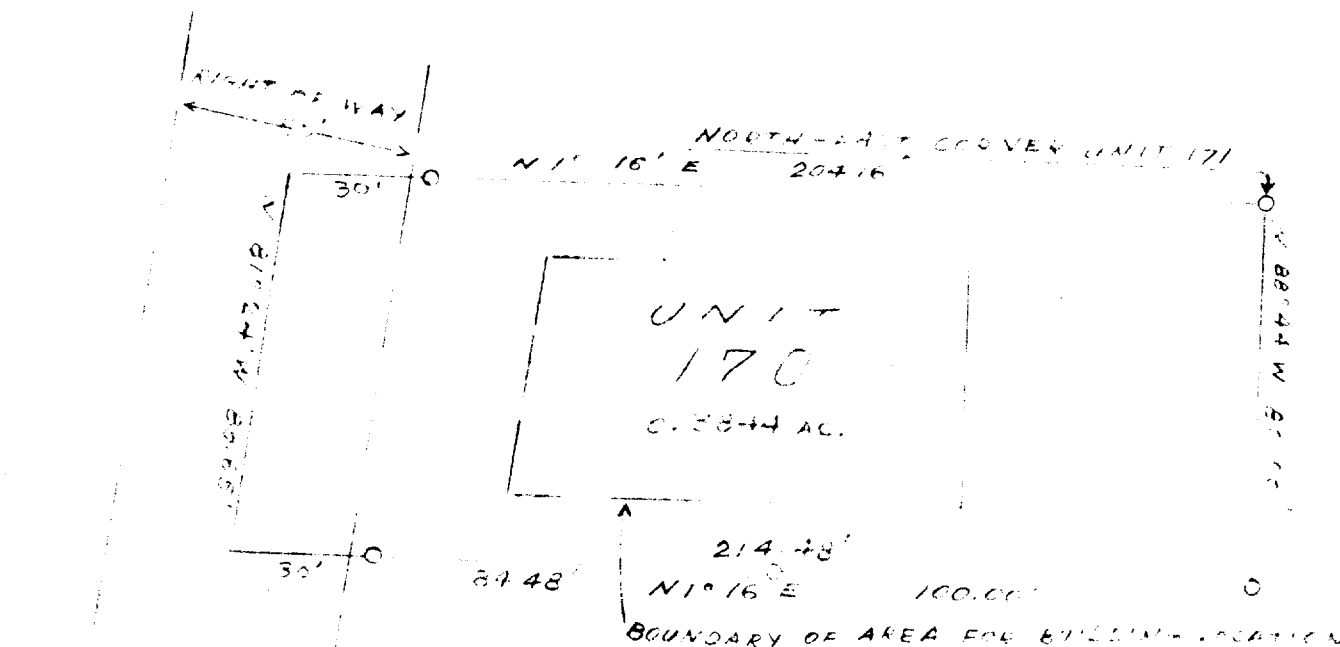

Elkhorn, Wisconsin

○ — Iron Pipe
● — Concrete Monument
Scale 1" = 40'

WE CERTIFY: That we have surveyed the above described property and that the plat shown hereon is an accurate survey and a true representation thereof and correctly shows the exterior boundary lines and all divisions of said property.

Date _____

LLOYD L. JENSEN.

Wisconsin Registered Land Surveyor, No. S-211