


- = Iron Pipe Set
- = Iron Pipe Found
- = Concrete Monument Found
- = Fence Line

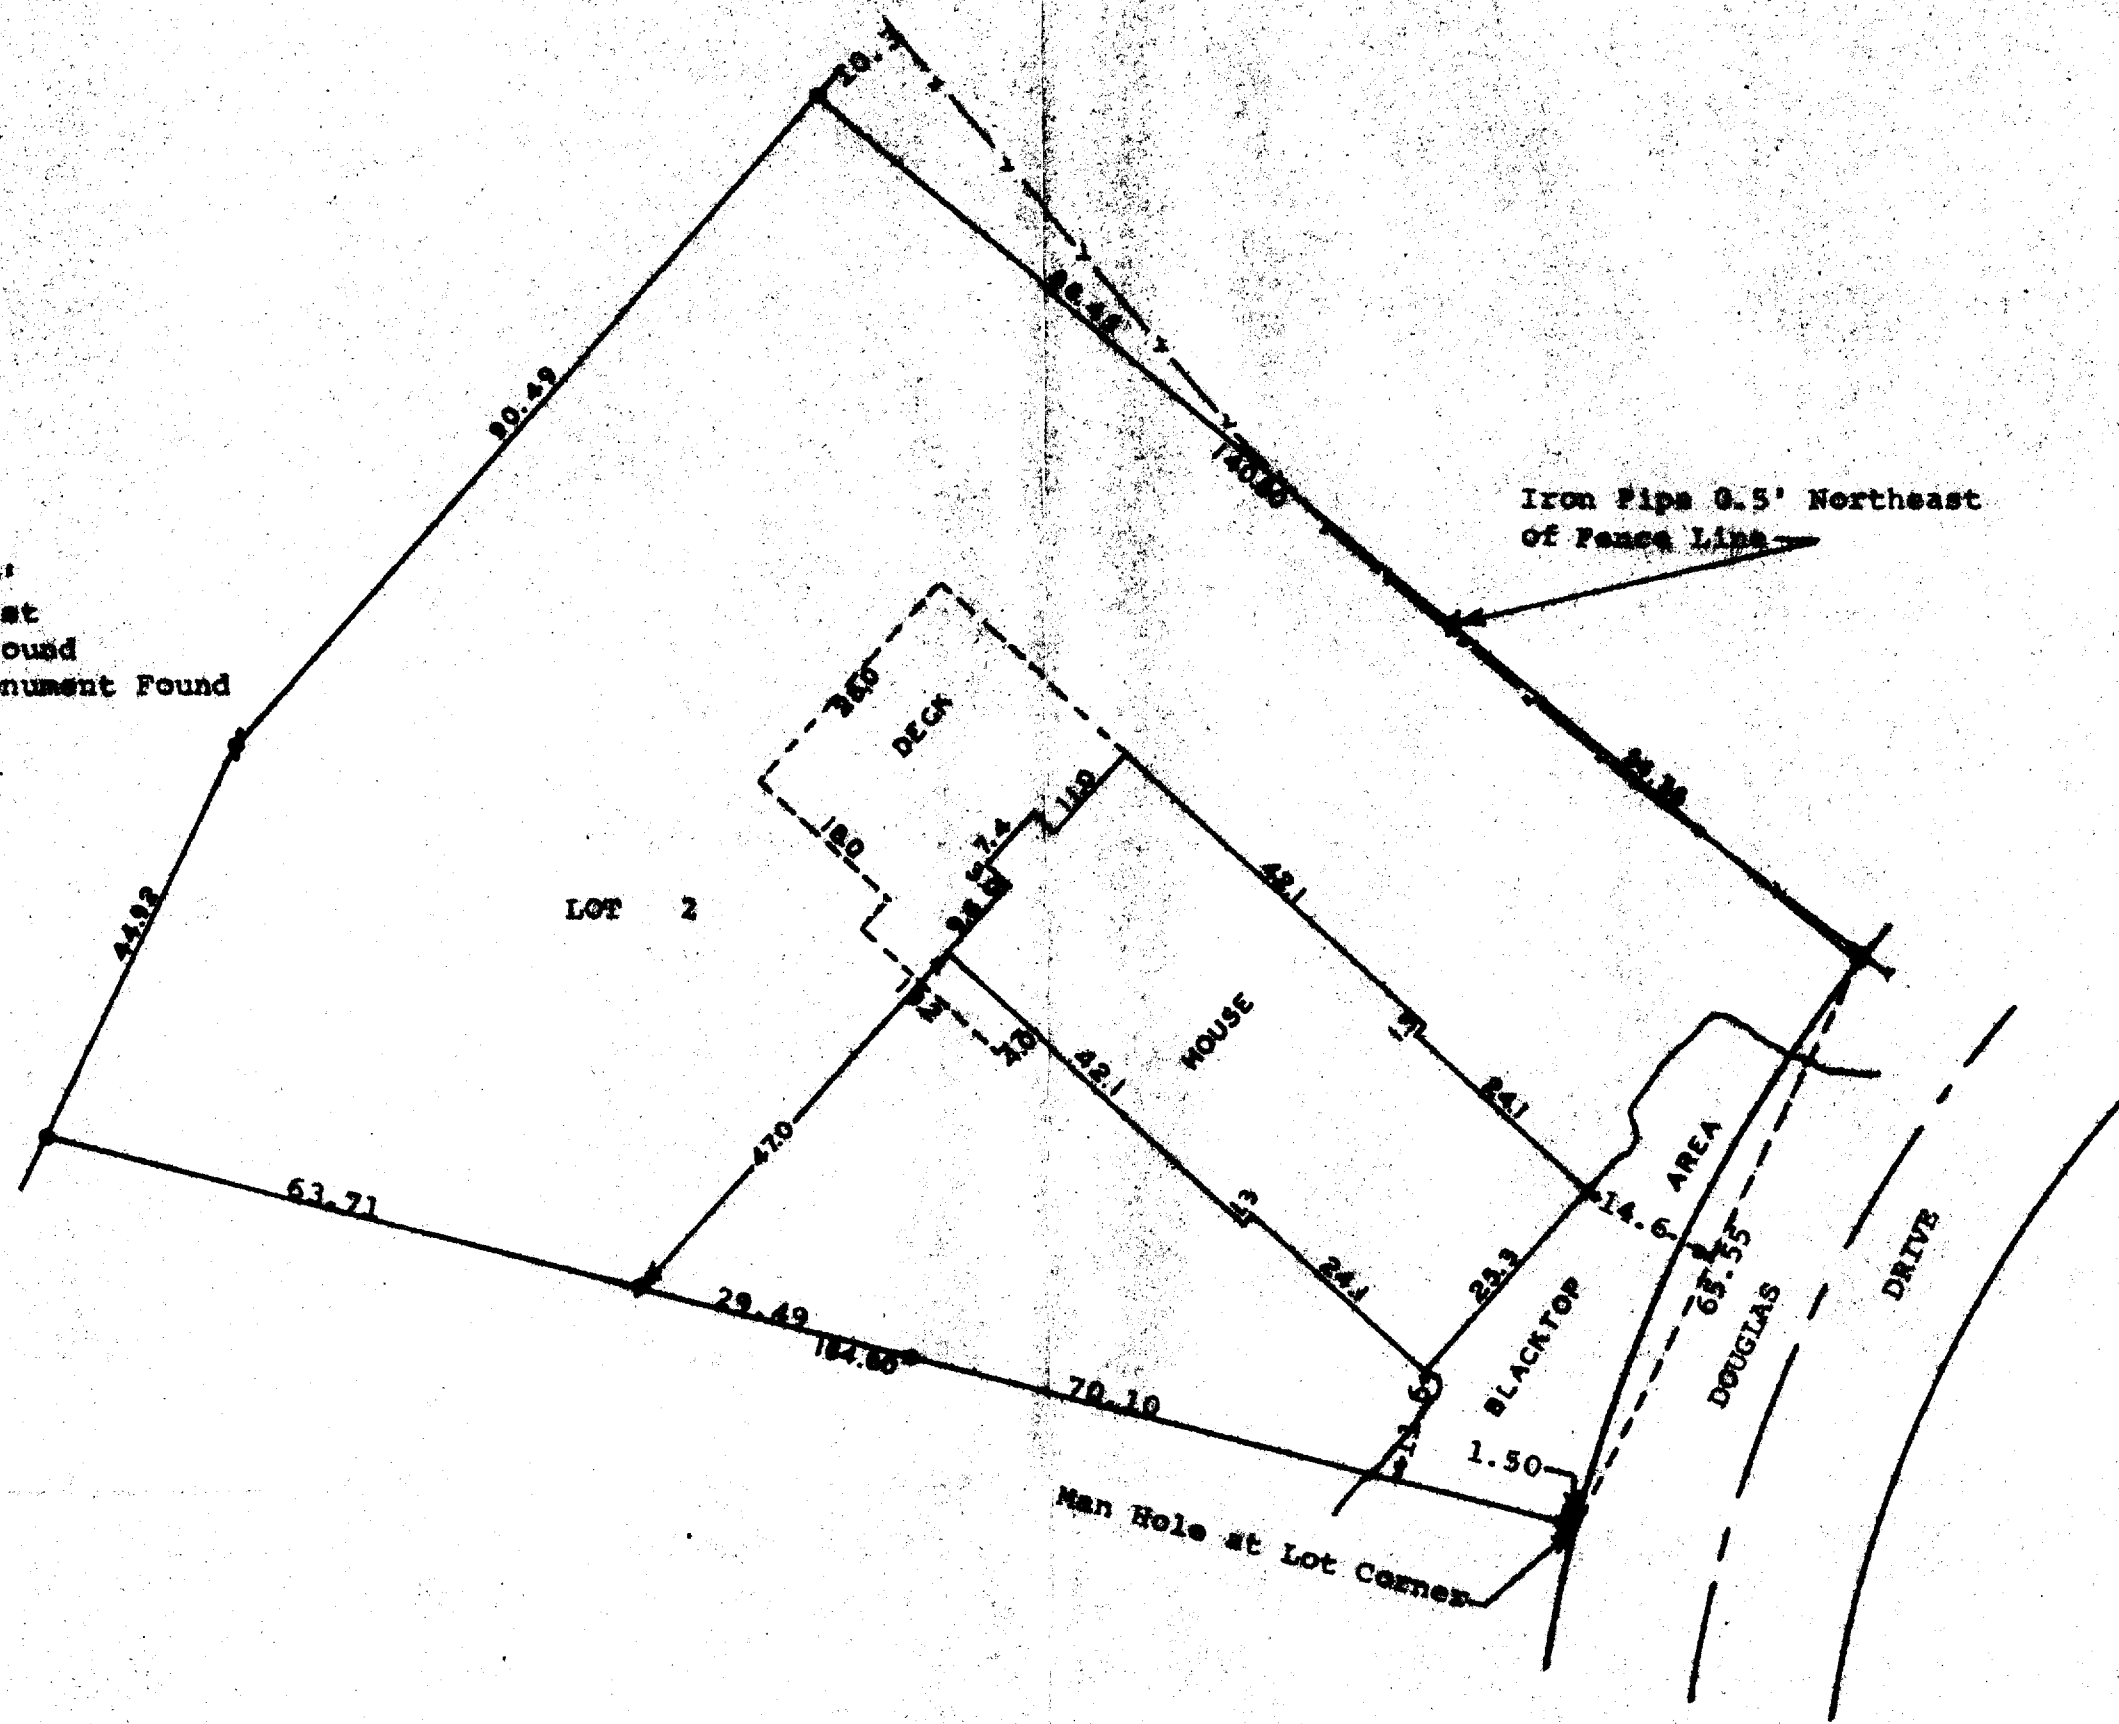

accuracy of said survey
March 1, 1976
Rechecked April 5, 1977

WISCONSIN
 GEORGE T.
 DUNHAM
 DELAVER,
 WIS.
 LAND SURVEYOR