

# MORTGAGE INSPECTION SURVEY

OF THE EAST 30 FEET OF LOT 4, LOT 5, AND THE WEST 20 FEET OF LOT 6,  
BLOCK 4, INDIAN HILLS, VILLAGE OF FONTANA ON GENEVA LAKE WALWORTH  
COUNTY, WISCONSIN

NORTH

NORTHERLY LINE OF SOUTH SHORE DRIVE  
ASSUMED TO BEAR EAST

SCALE 1" = 20'



○ 1" iron pipe found


mortgage inspection for:

WAUKESHA SAVINGS AND LOAN ASSOCIATION

I HEREBY, CERTIFY THAT THE MORTGAGE INSPECTION SURVEY OF  
THE ABOVE DESCRIBED PROPERTY HAS BEEN DONE UNDER MY  
DIRECTION AND THAT THE PLAT SHOWN HEREON CORRECTLY SHOWS  
THE LOCATION OF THE BUILDINGS ON SAID PROPERTY.

DATED THIS 22<sup>nd</sup> DAY OF July, 1977

WILLIAM A. SHEARMAN  
Registered Land Surveyor No. 3-1378

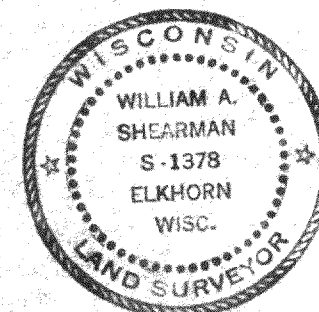

JENSEN & JOHNSON

ENGINEERS & SURVEYORS

P.O. BOX 290 ELKHORN

WIS. 53121

414-723-3204

Project NO. 1658.185

DRAWN BY D. COOPER

5-479

SIH-63