


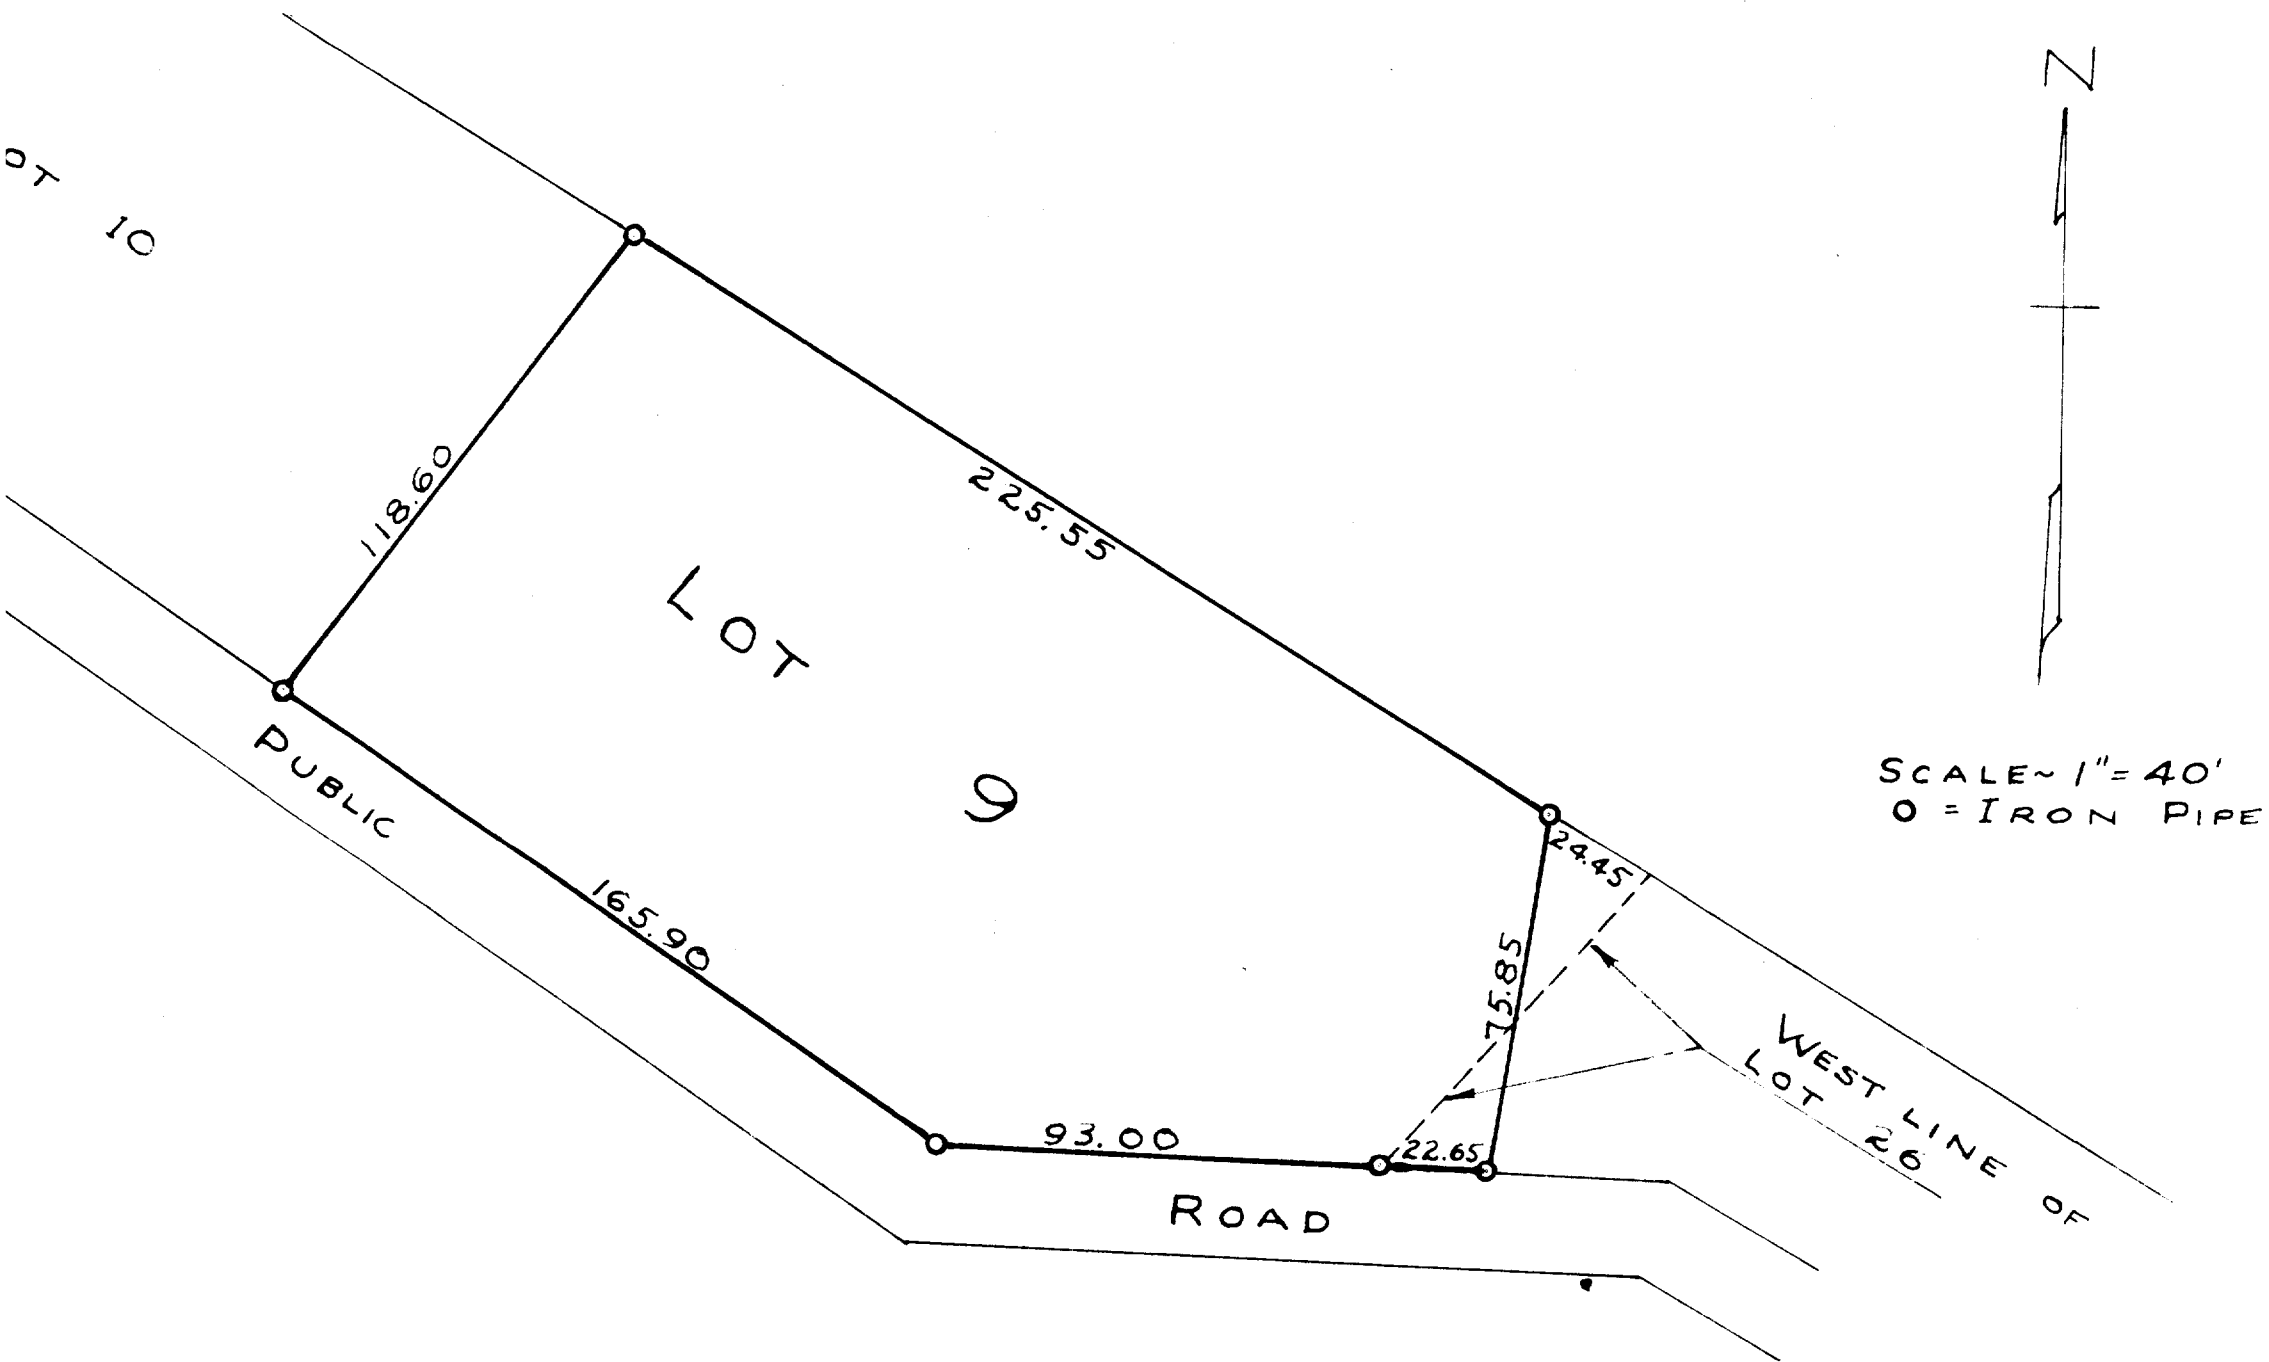

PLAT OF SURVEY OF LOT 9 AND PART OF
LOT 26 OF THE GARDENS LOCATED IN THE
VILLAGE OF FONTANA-ON-GENEVA LAKE,
WALWORTH COUNTY, WISCONSIN.

SEPT. 1948

Lloyd P. Jensen
COUNTY SURVEYOR

5-473