
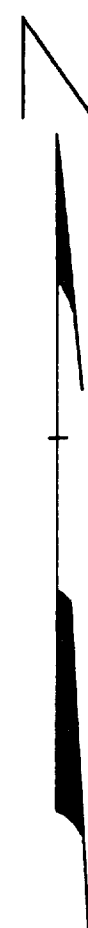



DUNHAM SURVEYING, S. C.
SURVEYING & SUBDIVIDING
DELAVAN, WISCONSIN 53115

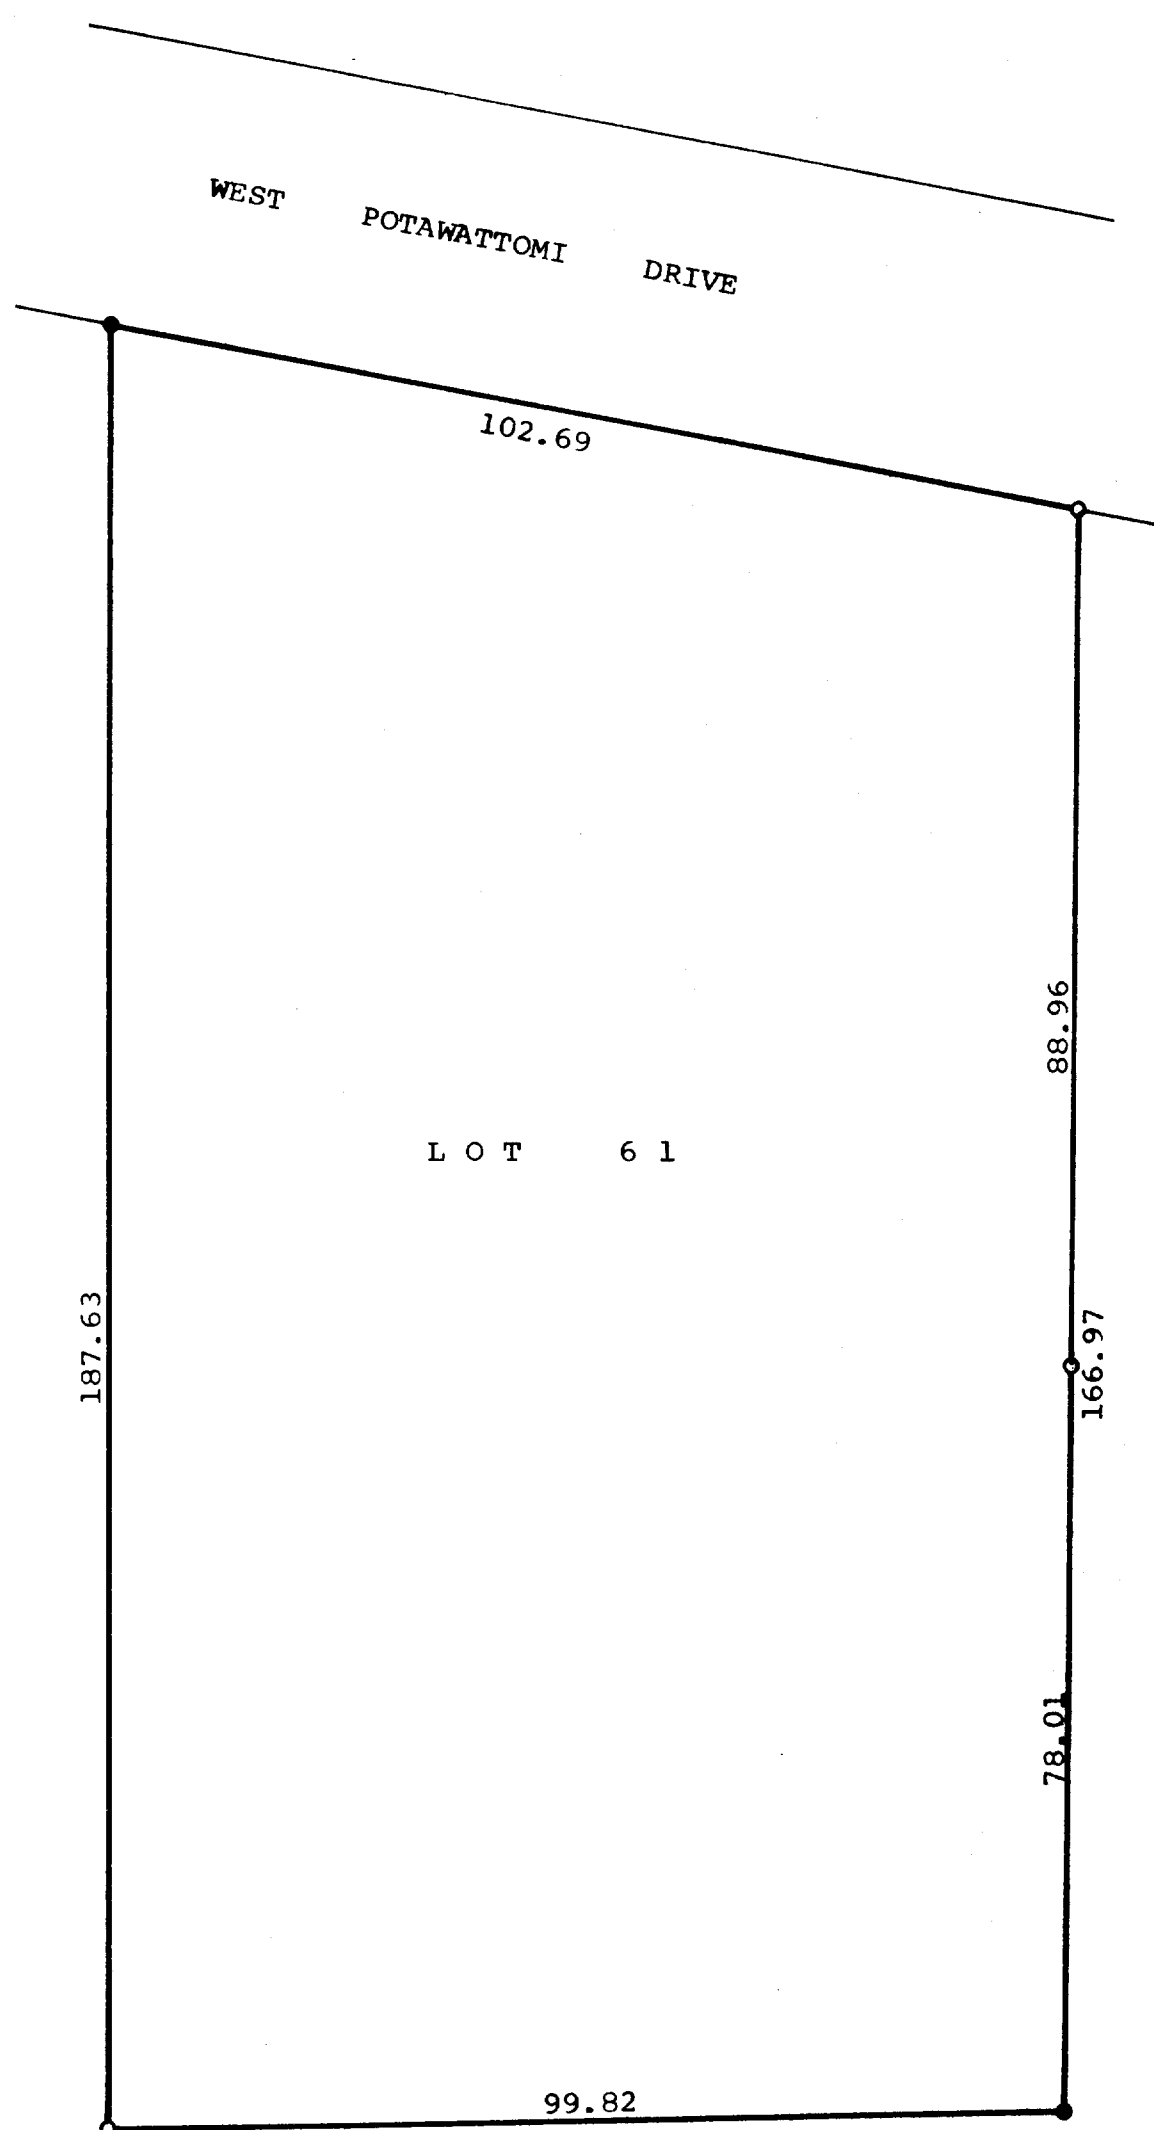

Scale - 1" = 20'
○ = Iron Pipe Found
● = Concrete Monument Found

Plat of survey of Lot 61 in Country Club Estates
Unit No. 2 located in the Village of Fontana-on-Geneva
Lake, Walworth County, Wisconsin.
November 3, 1977

James M. Dunham
James M. Dunham, Surveyor

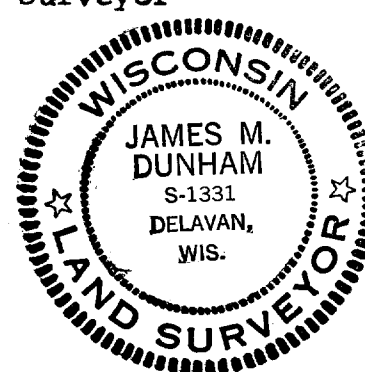

Parcel - SC02-55