


HAZEL COURT

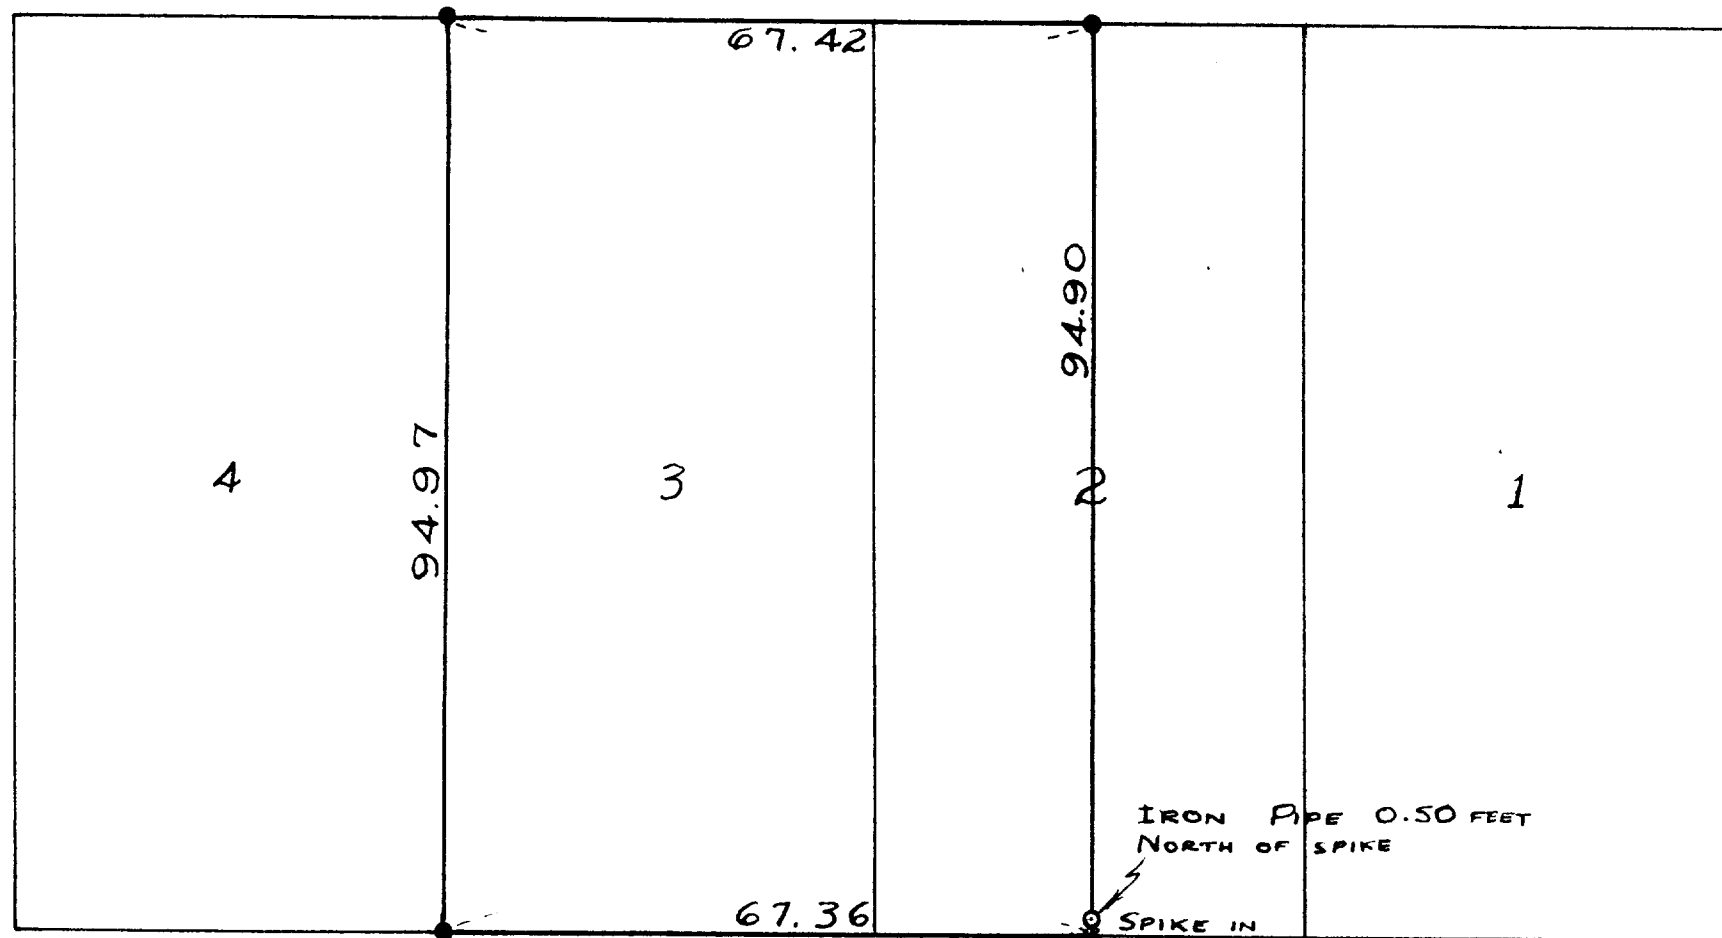

DUNLAP AVENUE

HARVARD AVENUE

PLAT OF SURVEY OF THE WEST 1/2 OF LOT 2 AND
LOT 3 OF BLOCK 6 IN GLENWOOD SPRINGS
LOCATED IN THE VILLAGE OF FONTANA ~ ON ~
GENEVA LAKE, WALWORTH COUNTY, WISCONSIN
OCTOBER 1948

Lloyd D. Jensen
COUNTY SURVEYOR

SG-5-19

5-48J