


GEORGE T. DUNHAM
SURVEYING & SUBDIVIDING
DELAVER, WISCONSIN

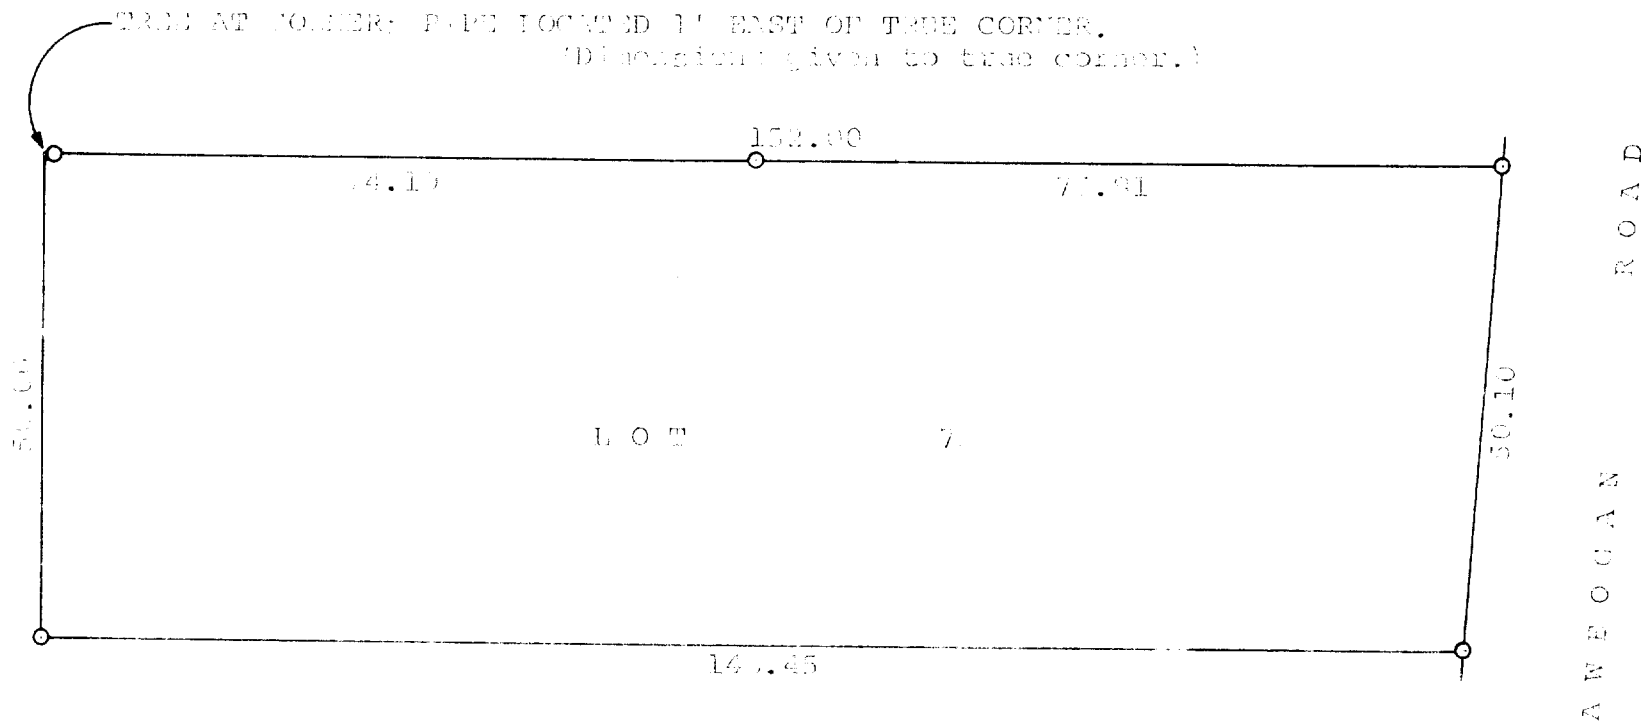

Plot of survey of Lot 7, Blk 6, Delmar Hills
Subdivided, within the town of Wilbert
County, Wisconsin.
August 6, 1921

George T. Dunham
George T. Dunham, Surveyor

5-49

Scale - 1" = 200'
O = Iron Pipe