


N
 SCALE - 1" = 20'
 O = IRON PIPE

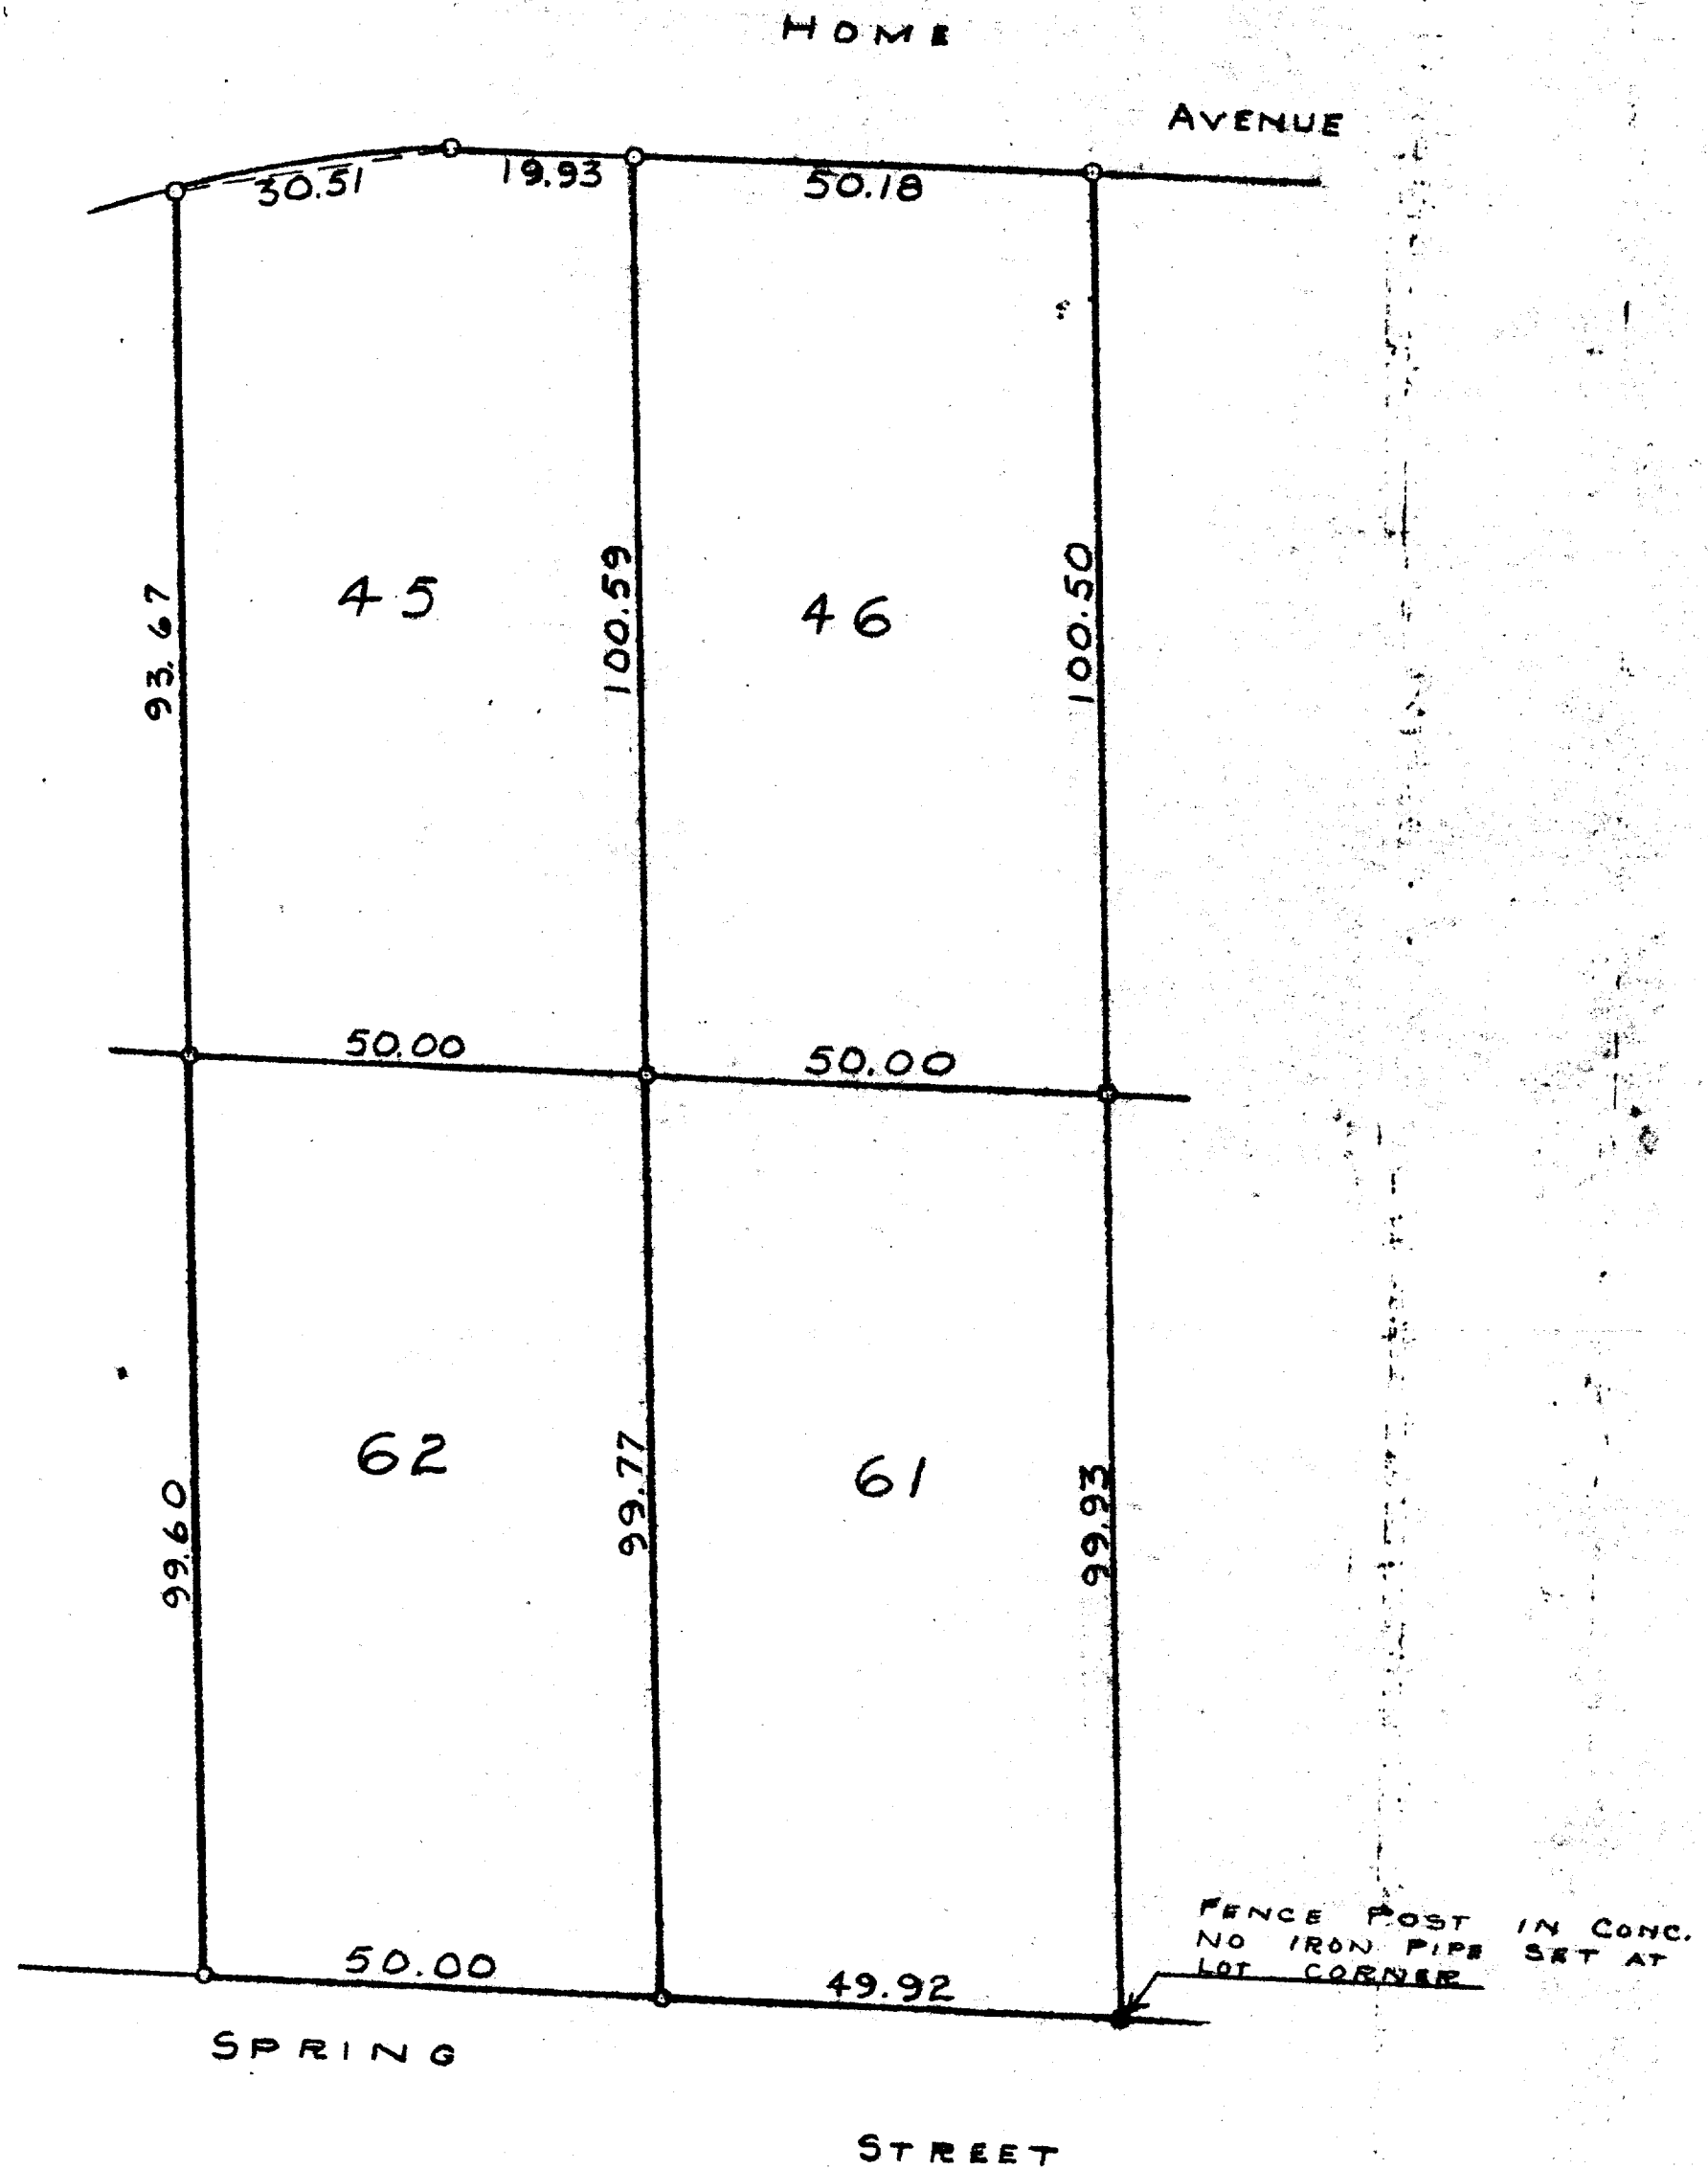

PLAT OF SURVEY OF LOTS 45, 46, 61, AND 62 OF BUENA VISTA LOCATED IN THE VILLAGE OF FONTANA-ON-GENEVA LAKE, WALWORTH COUNTY, WISCONSIN
 AUGUST 1953

George T. Dunham
 GEORGE T. DUNHAM, SURVEYOR
 DELAVAN, WISCONSIN

SBV-33, 42

5-5