


DUNHAM & RASMUSSEN
SURVEYING & ENGINEERING
DELAVAN, WISCONSIN

N



Scale - 1" = 20'
○ = Iron Pipe
● = Concrete Monument

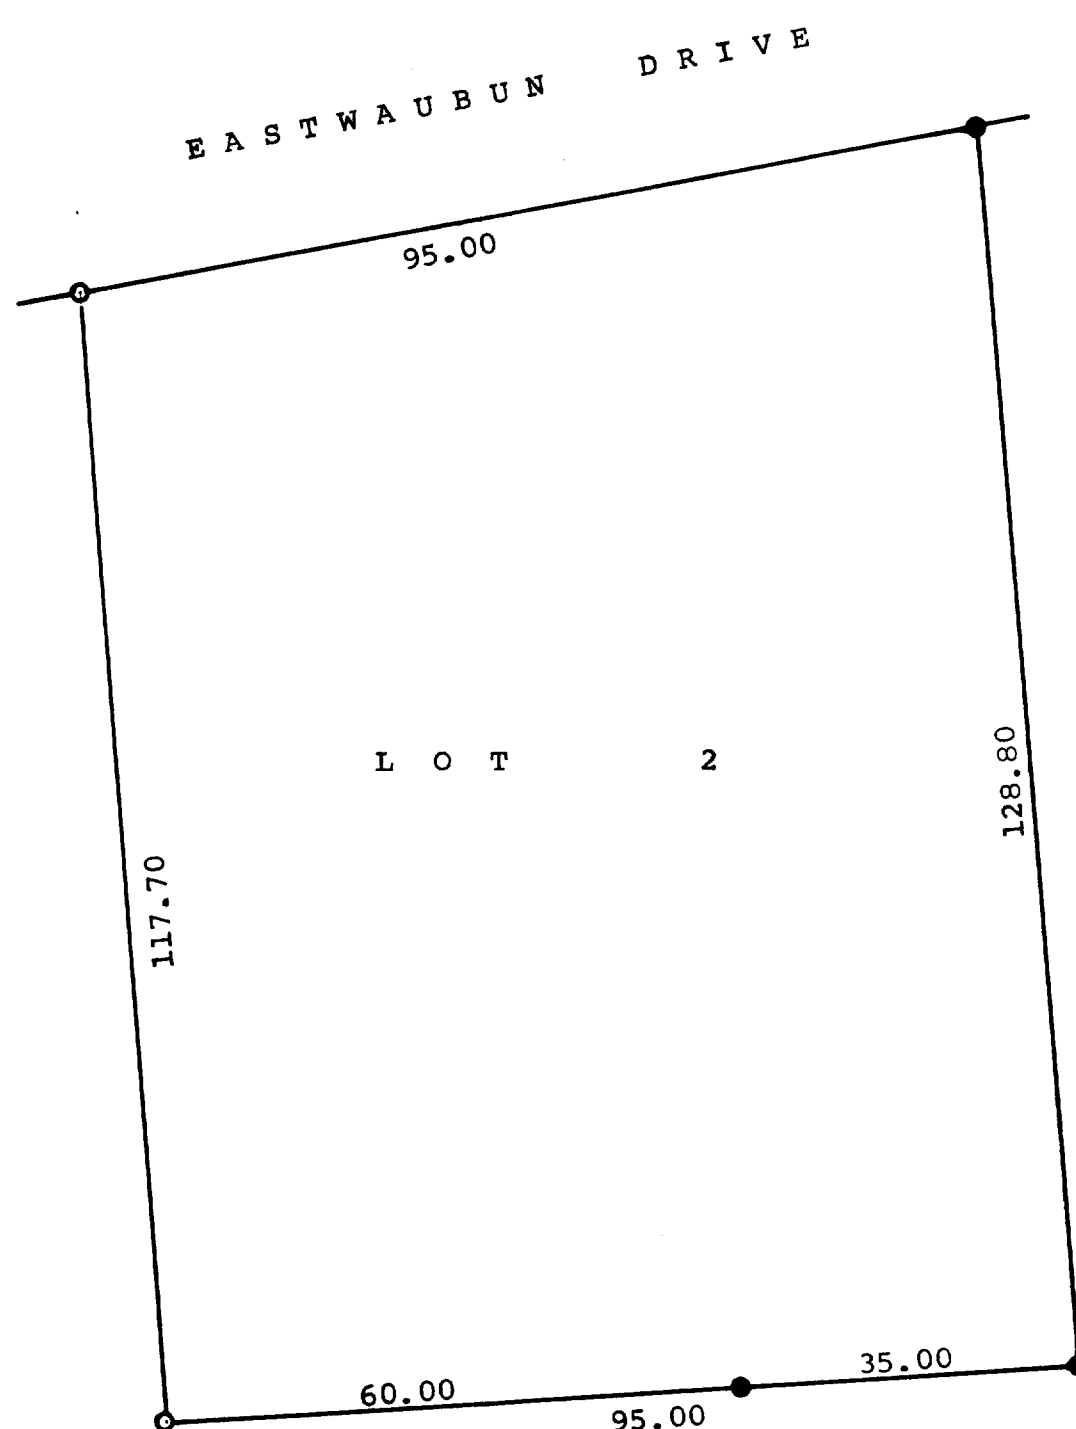

Plat of survey of Lot 2, Block "H" Country Club Estates Unit
No. 3 located in the Village of Fontana, Walworth County, Wisconsin
April 2, 1962

George T. Dunham
George T. Dunham, Surveyor