


GEORGE T. DUNHAM  
SURVEYING & SUBDIVIDING  
DELAVER, WISCONSIN

N



Scale - 1" = 20'  
O = Iron Pipe  
● = Concrete Monument

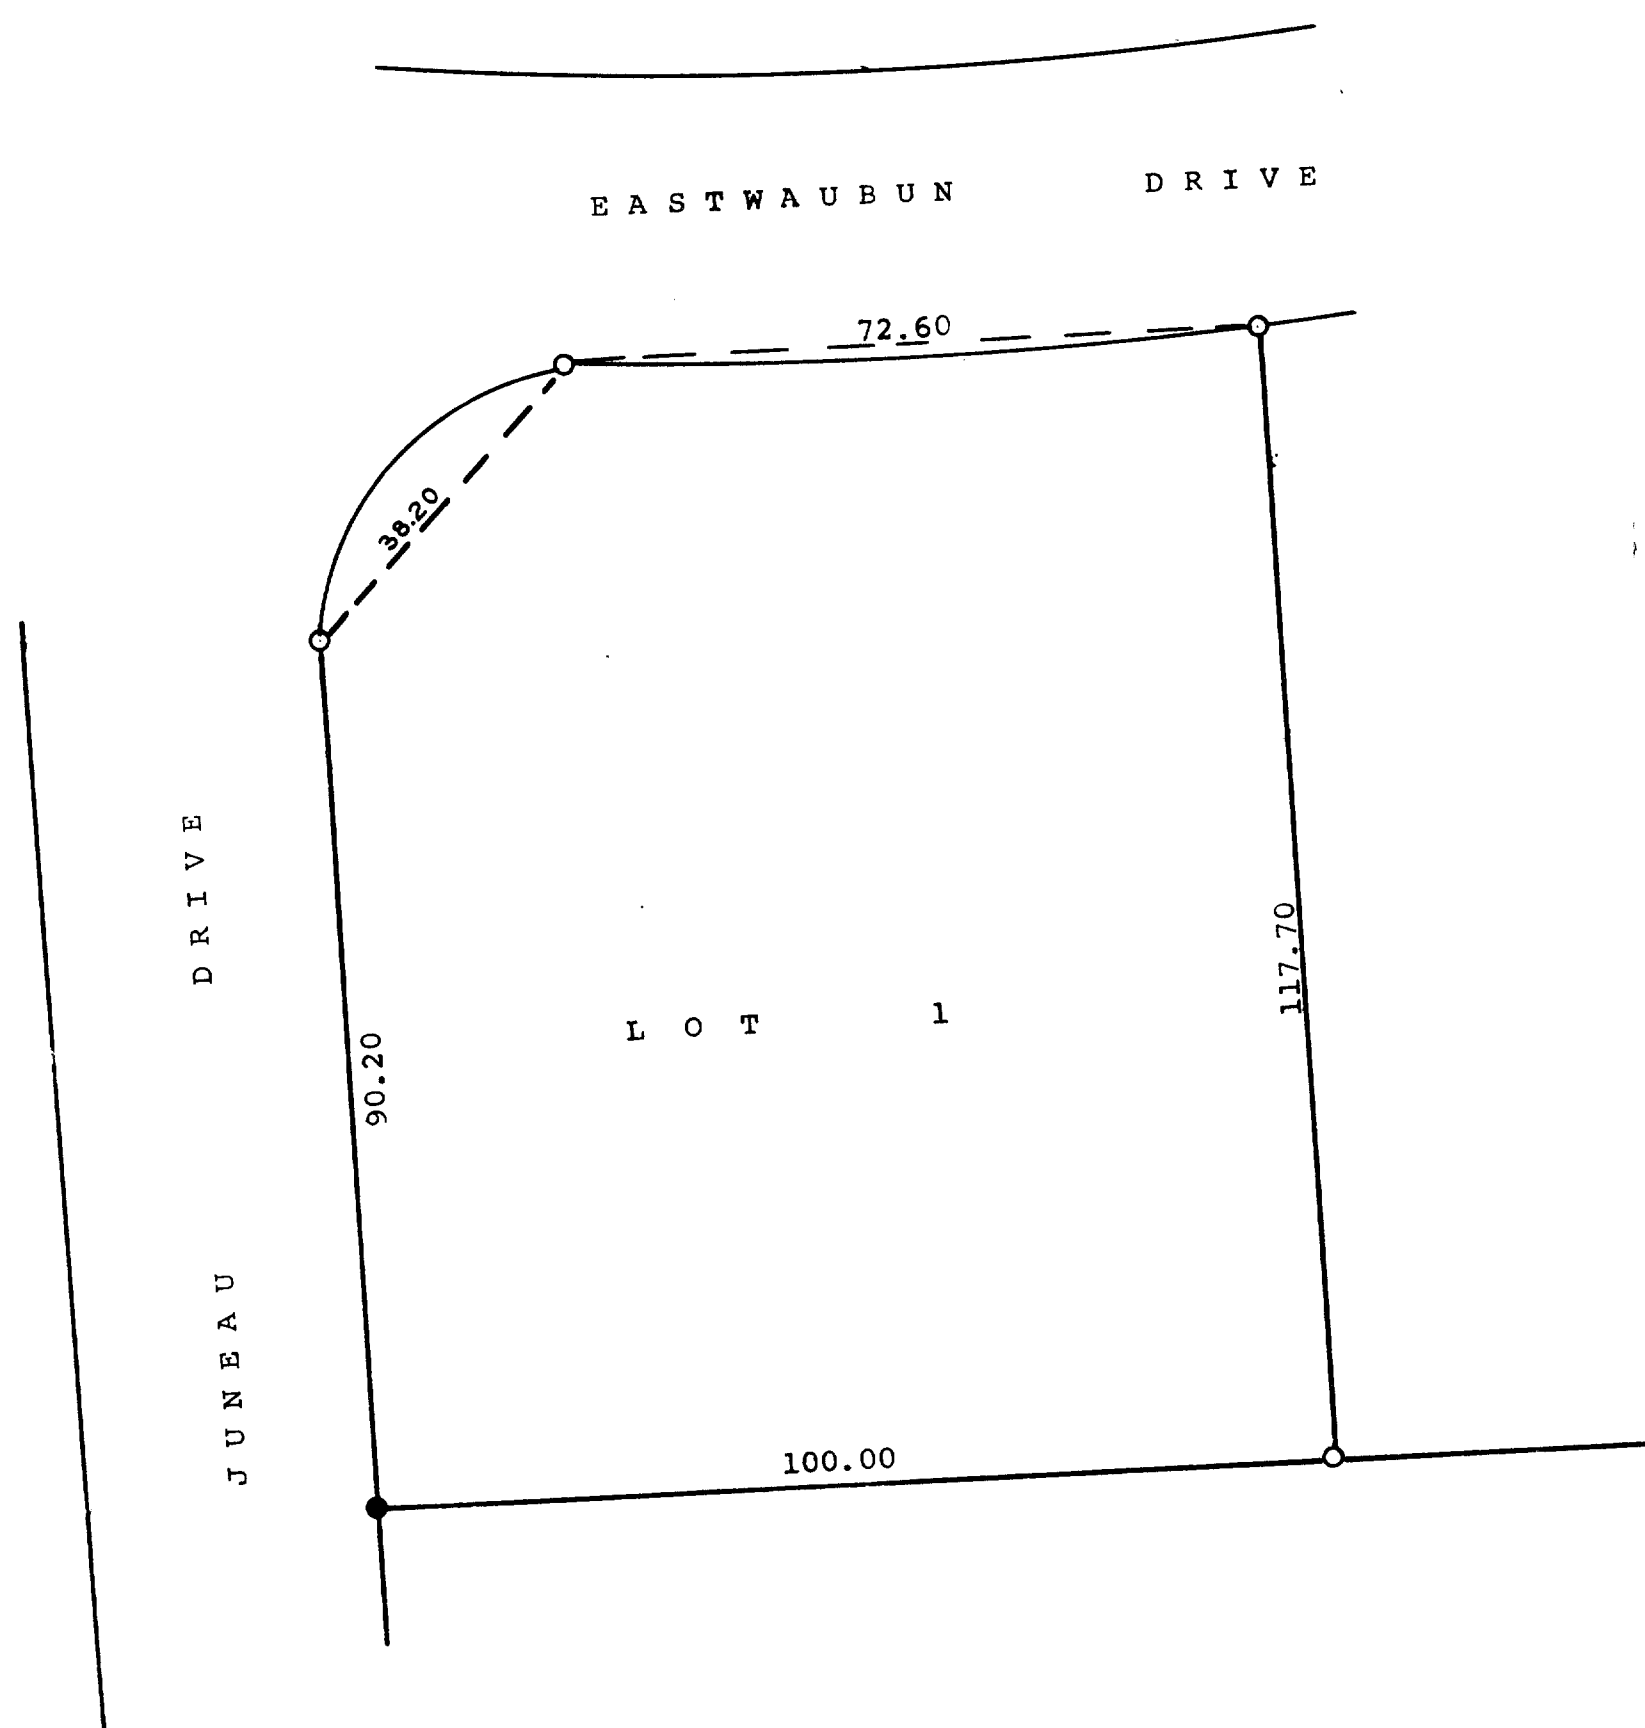

Plat of survey of Lot 1, Block "H" Country Club Estates Unit  
No. 3 located in the Village of Fontana, Walworth County, Wisconsin  
September 12, 1962

*George T. Dunham*  
George T. Dunham, Surveyor