


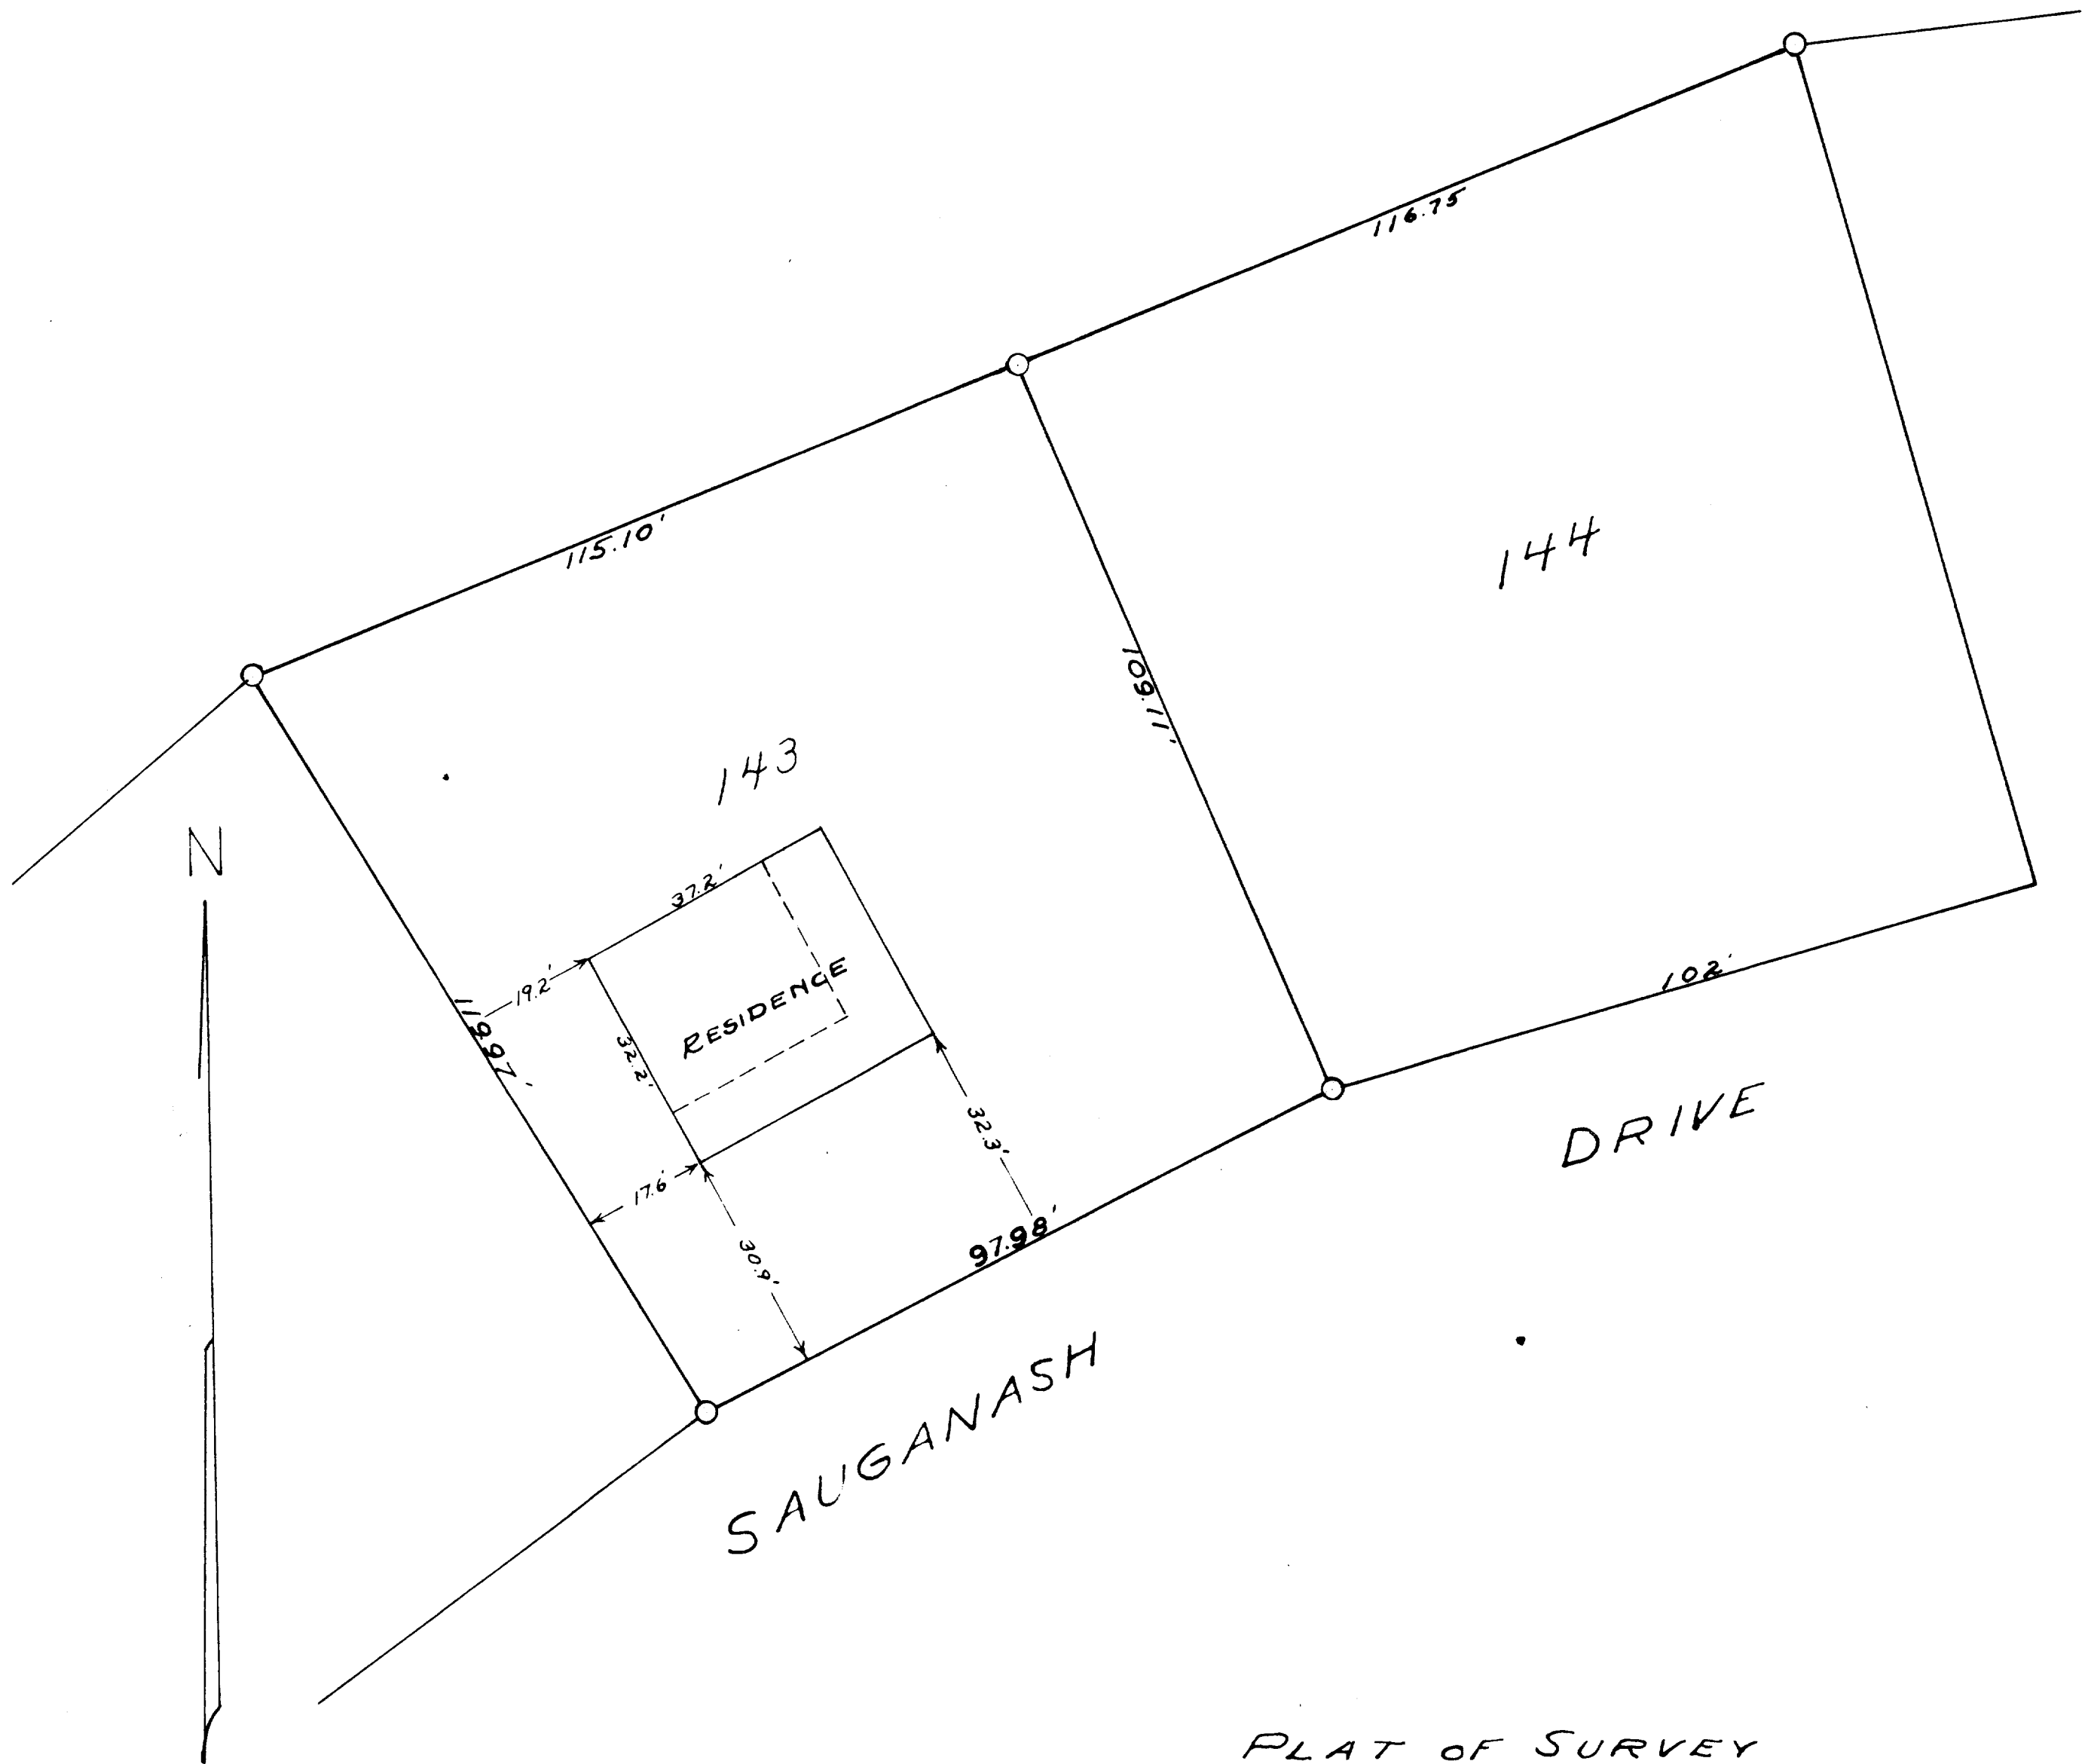

SCALE 1" = 20'
O = IRON PIPE

PLAT OF SURVEY

LOT 143 OF COUNTRY CLUB ESTATES UNIT
2, LOCATED IN THE VILLAGE OF FONTANA
ON GENEVA LAKE, WALWORTH COUNTY,
WISCONSIN.
AUGUST 12, 1949

H. E. Johnson
SURVEYOR

THEREBY CERTIFY THAT THERE ARE NO
EASEMENTS OF RECORD ON LOT 143 OF
UNIT 2 OF COUNTRY CLUB ESTATES.

Lloyd L. Jensen

FEB. 1950

WALWORTH COUNTY SURVEYOR

5-51J