


GEORGE T. DUNHAM
SURVEYING & SUBDIVIDING
DELAVER, WISCONSIN

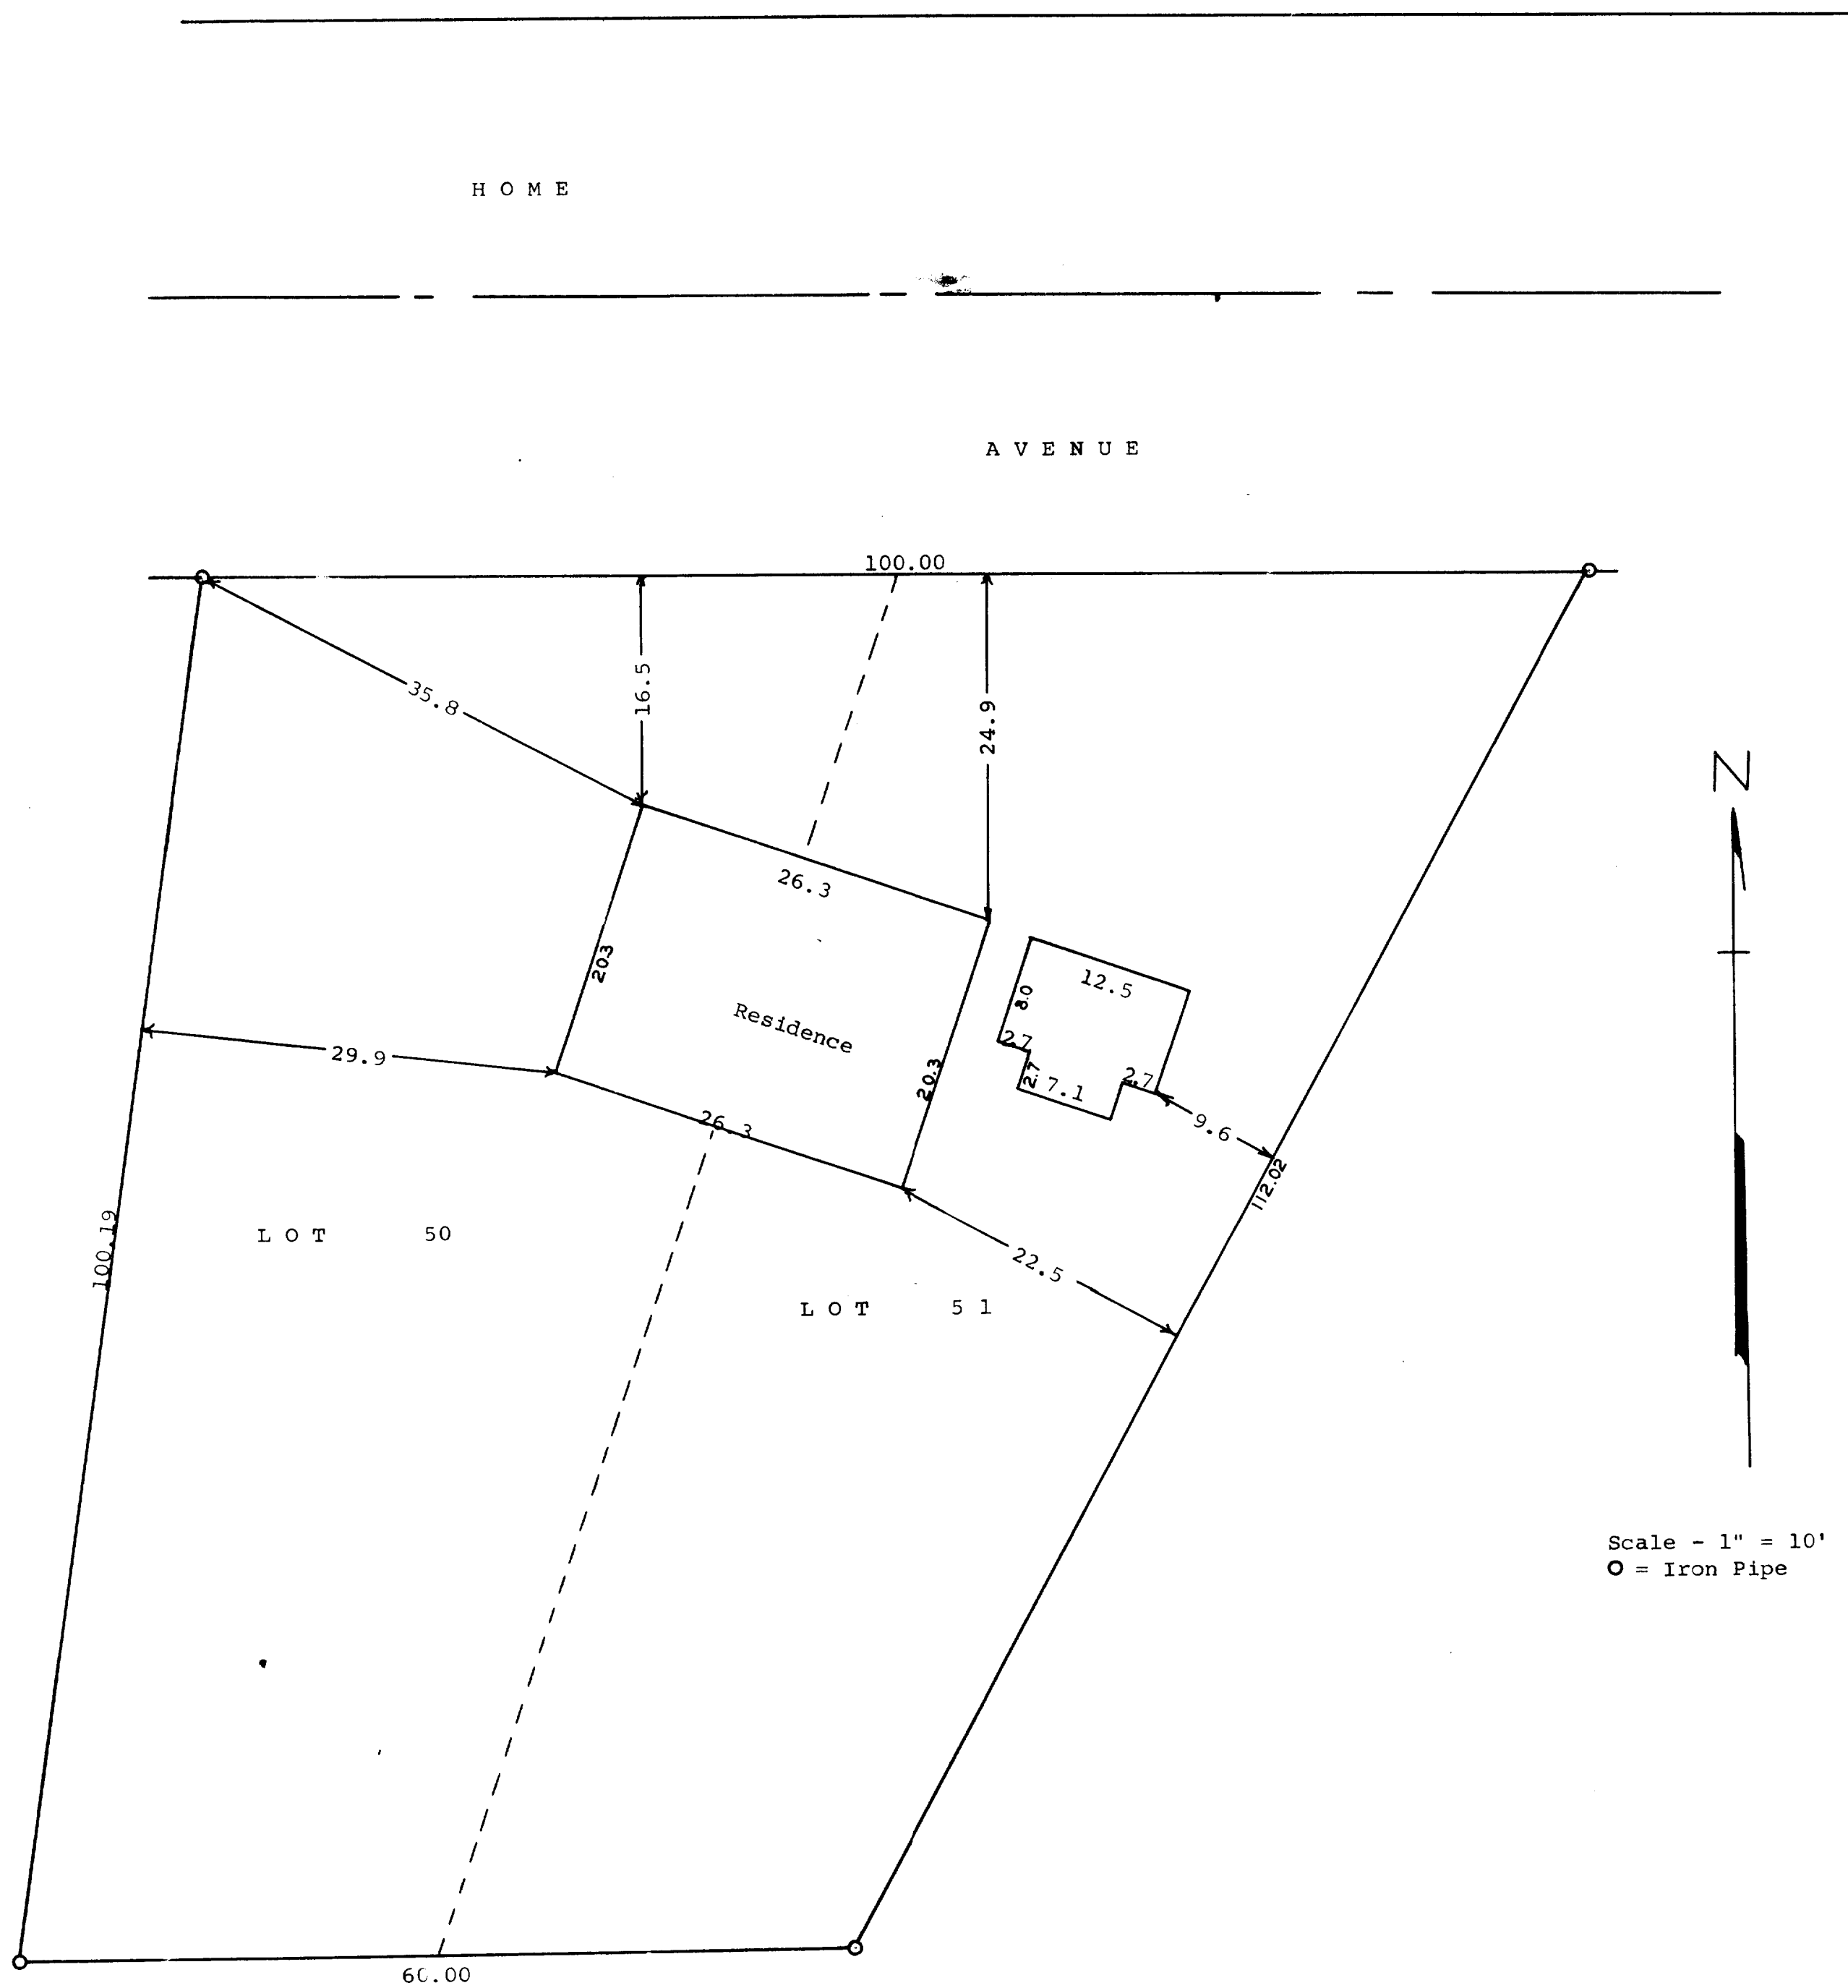

Plat of survey of Lots 50 & 51 of Buena Vista located in the Village
of Fontana, Walworth County, Wisconsin
January 10, 1963

George T. Dunham
George T. Dunham, Surveyor