


KOLB LAND CONSULTING, INC.

LAKE GENEVA, WI.



PLAT OF SURVEY OF LOTS 43 AND 64, BUENA VISTA,
A SUBDIVISION LOCATED IN THE VILLAGE OF
FONTANA-ON-GENEVA LAKE, WALWORTH
COUNTY, WISCONSIN.

TOTAL AREA OF LOTS 43 AND 64
EQUALS 5460 SQ. FT.

SURVEY FOR: N. J. MURRAY
CONSTRUCTION COMPANY
P.O. BOX 24
WHEATON, IL. 60187

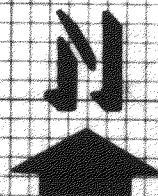

SCALE: 1"=30'

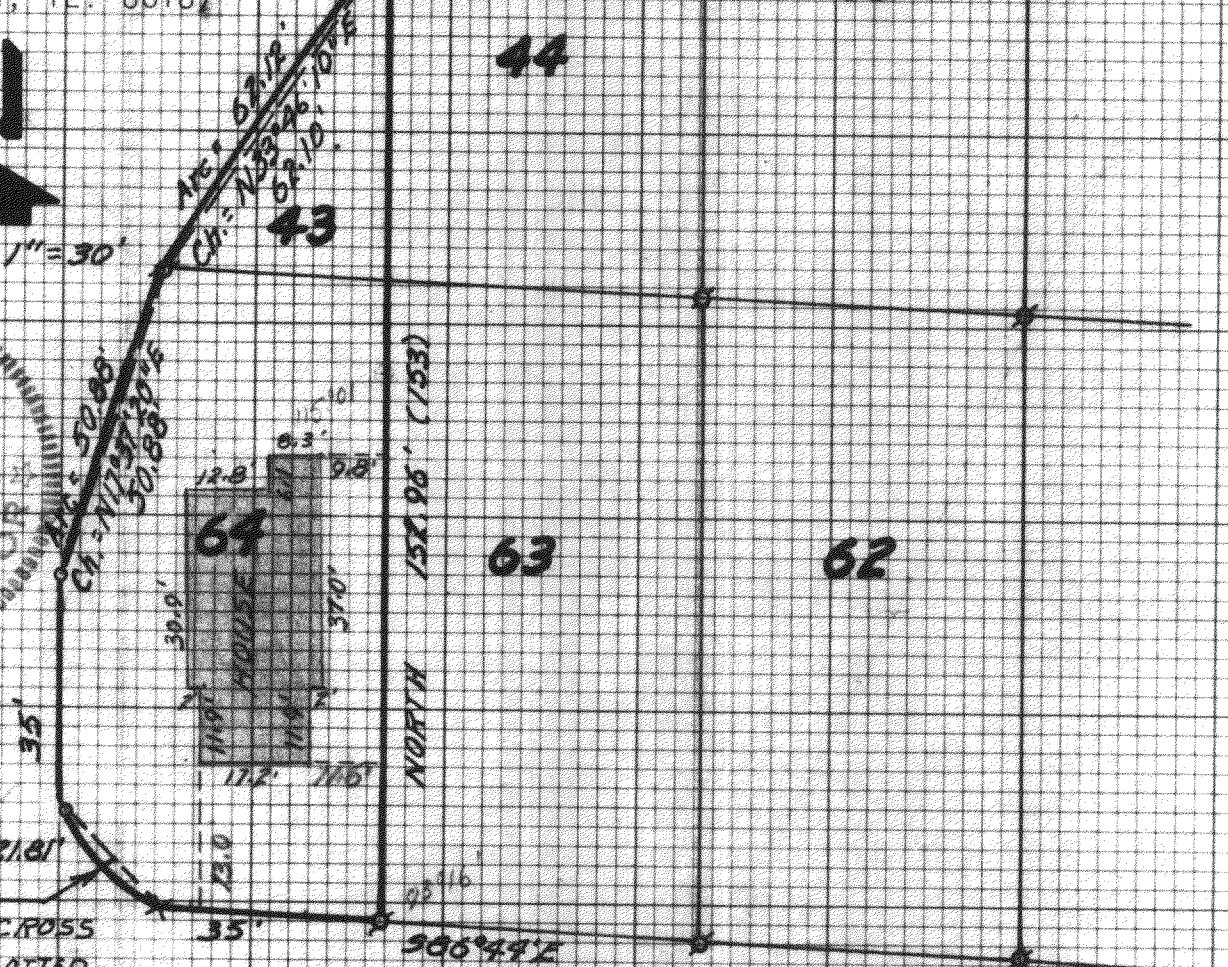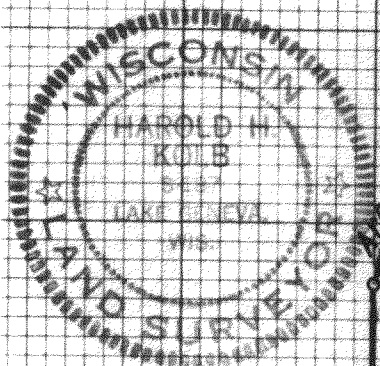

CH: N43°22'W 21.81'
ARC: = 22.32'

X - CUT CROSS

(1) - AS PLATTED

O - IRON PIPE SET

O - IRON PIPE FOUND

Harold H. Kolb

HAROLD H. KOLB

DATE: *Jan. 24, 1977*

REVISED: JAN 13, 1978

SBV-B11

SPRING STREET

5-525