


**SURVEYING & SUBDIVIDING
DELA VAN, WISCONSIN 53115**

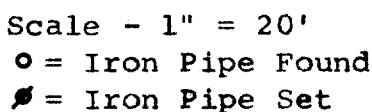

I, George T. Dunham, Surveyor, certify that I have surveyed the property described as follows:
Lot 8 of Addition "B" to Country Club Estates located in the Village of Fontana, Walworth County, Wisconsin. and the above plat is a true representation thereof and shows the size and location of the property, its exterior boundaries, the location and dimensions of all structures thereon, fences, apparent easements and roadways and visible encroachments, if any.
This survey is made for the exclusive use of the present owners of the property, and also those who purchase, mortgage, or guarantee the title thereto within one (1) year from date hereof; and as to them I warrant the accuracy of said survey and map.
February 24, 1978

George F. Dunham, Surveyor