


FARRIS, HANSEN & COOPER, INC.

ENGINEERING, SURVEYING AND LAND PLANNING
715 W. WALWORTH ST. - P.O. BOX 487 - ELKHORN, WI 53121
OFFICE 414/723-2098

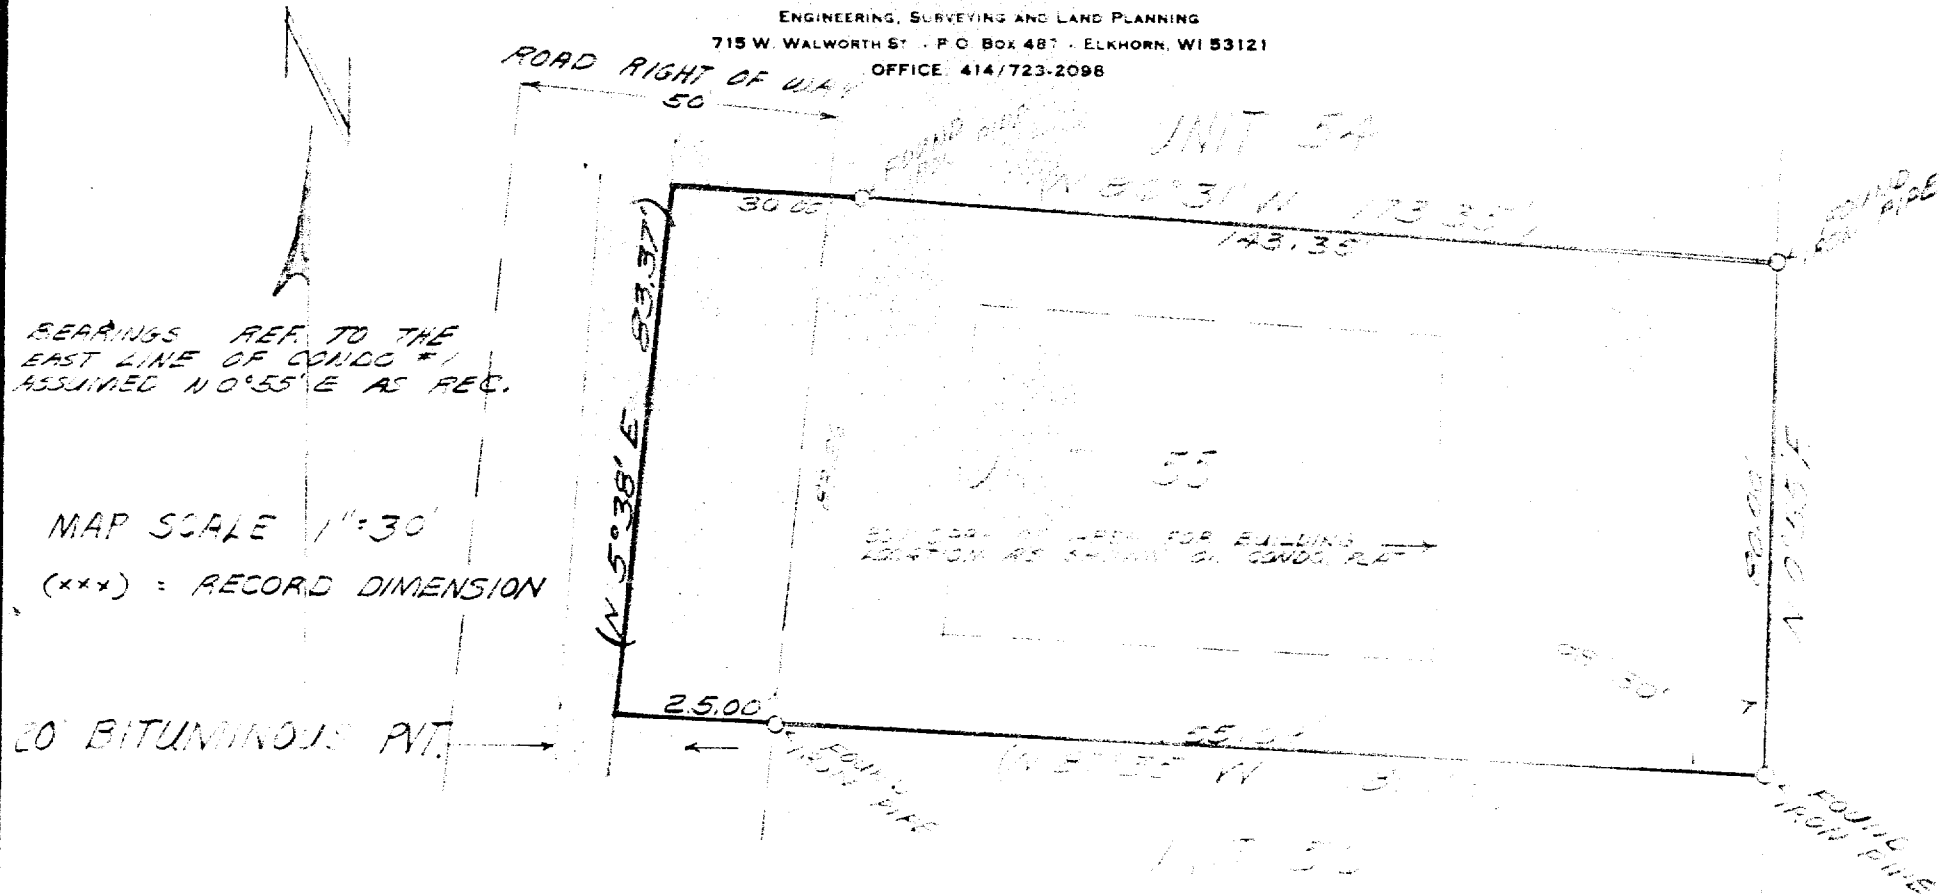

PLAT OF SURVEY OF UNIT 55 OF ABBEY SPRINGS CONDOMINIUM NO. 1
LOCATED IN THE SOUTHEAST 1/4 OF SECTION 13, TOWN 1 NORTH, RANGE
16 EAST, VILLAGE OF FONTANA - ON - GENEVA LAKE, WALWORTH COUNTY, WIS.

Buyer: Robert Pascente

Glen Somers

Seller: Jack Phelan

Work ordered by : Mary Meyers - Keefe Realty

I HEREBY CERTIFY: that I have surveyed the above described property according to the official records and that this PLAT OF SURVEY is a true and accurate representation of the unit boundary lines and of the existing roadway pavement to the best of my professional knowledge and belief.

DATED THIS 29th DAY OF March, 1982

Robert A. Farris
Robert A. Farris RLS

DRAWING NUMBER

143
5-564 F

SCOB-55