


PLAT OF SURVEY OF UNIT 114 OF
 ABBEY SPRINGS CONDOMINIUM NO. 1V
 LOCATED IN THE SW $\frac{1}{4}$ OF SEC. 18, T14R17E,
 AND THE SE $\frac{1}{4}$ OF SEC. 13, T14R16E,
 VILLAGE OF FONTANA - ON - GENEVA LAKE,
 WAL. CO. WIS.
 JUNE 8, 1981

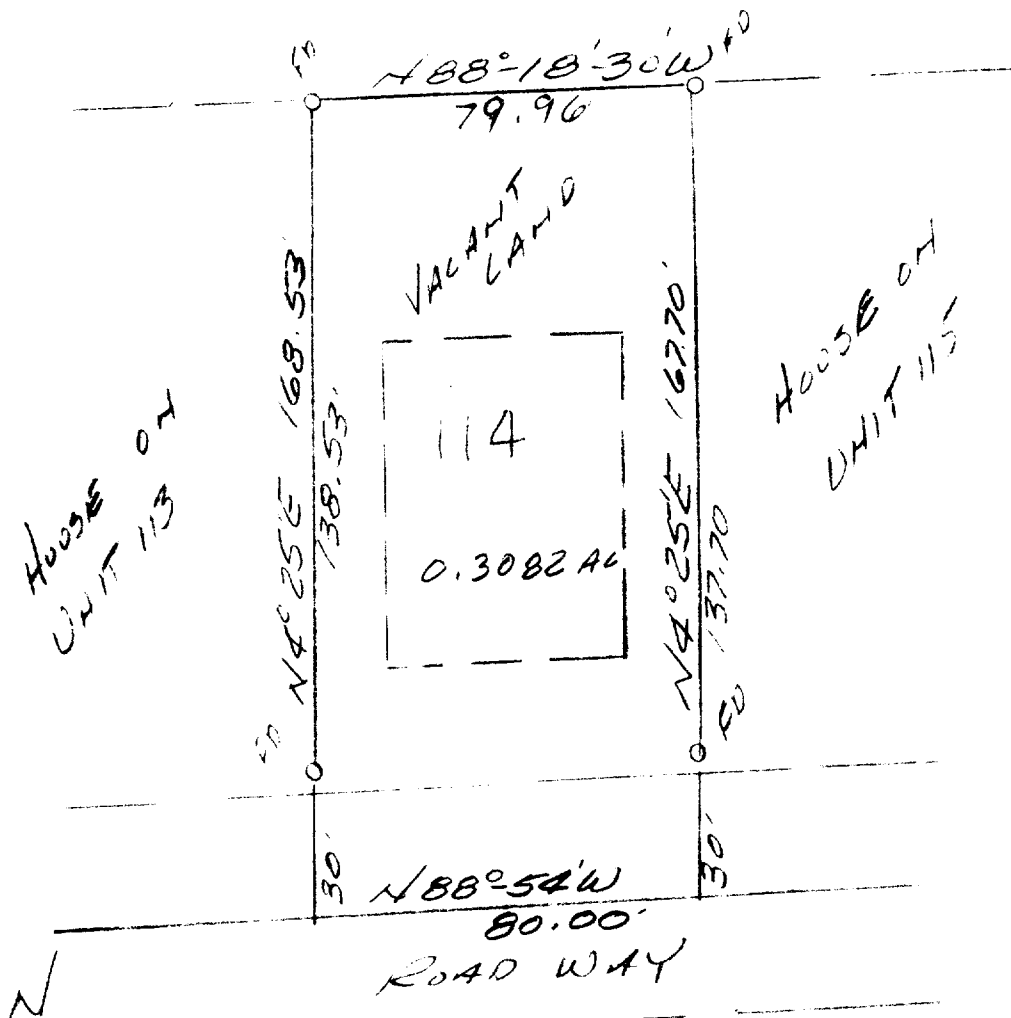


I CERTIFY THAT I SURVEYED THE ABOVE
 DESCRIBED PROPERTY & THAT THE PLAT
 SHOWN HEREON IS AN ACCURATE SURVEY &
 A TRUE REPRESENTATION THEREOF

SCALE
 1" = 40'

○ FOUND
 120" PIPE

SURVEYED FOR
 MR. HATHORN
 57 BOBOLINK DR
 FONTANA, WIS.
 53125

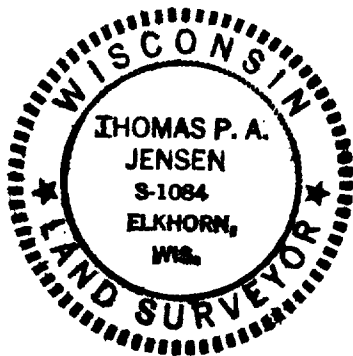

Thomas P. A. Jensen
 THOMAS P. A. JENSEN
 JENSEN SURVEYING &
 MAPPING, S. C.
 ELKHORN, WIS

81039

5-564-J

SC084-114