



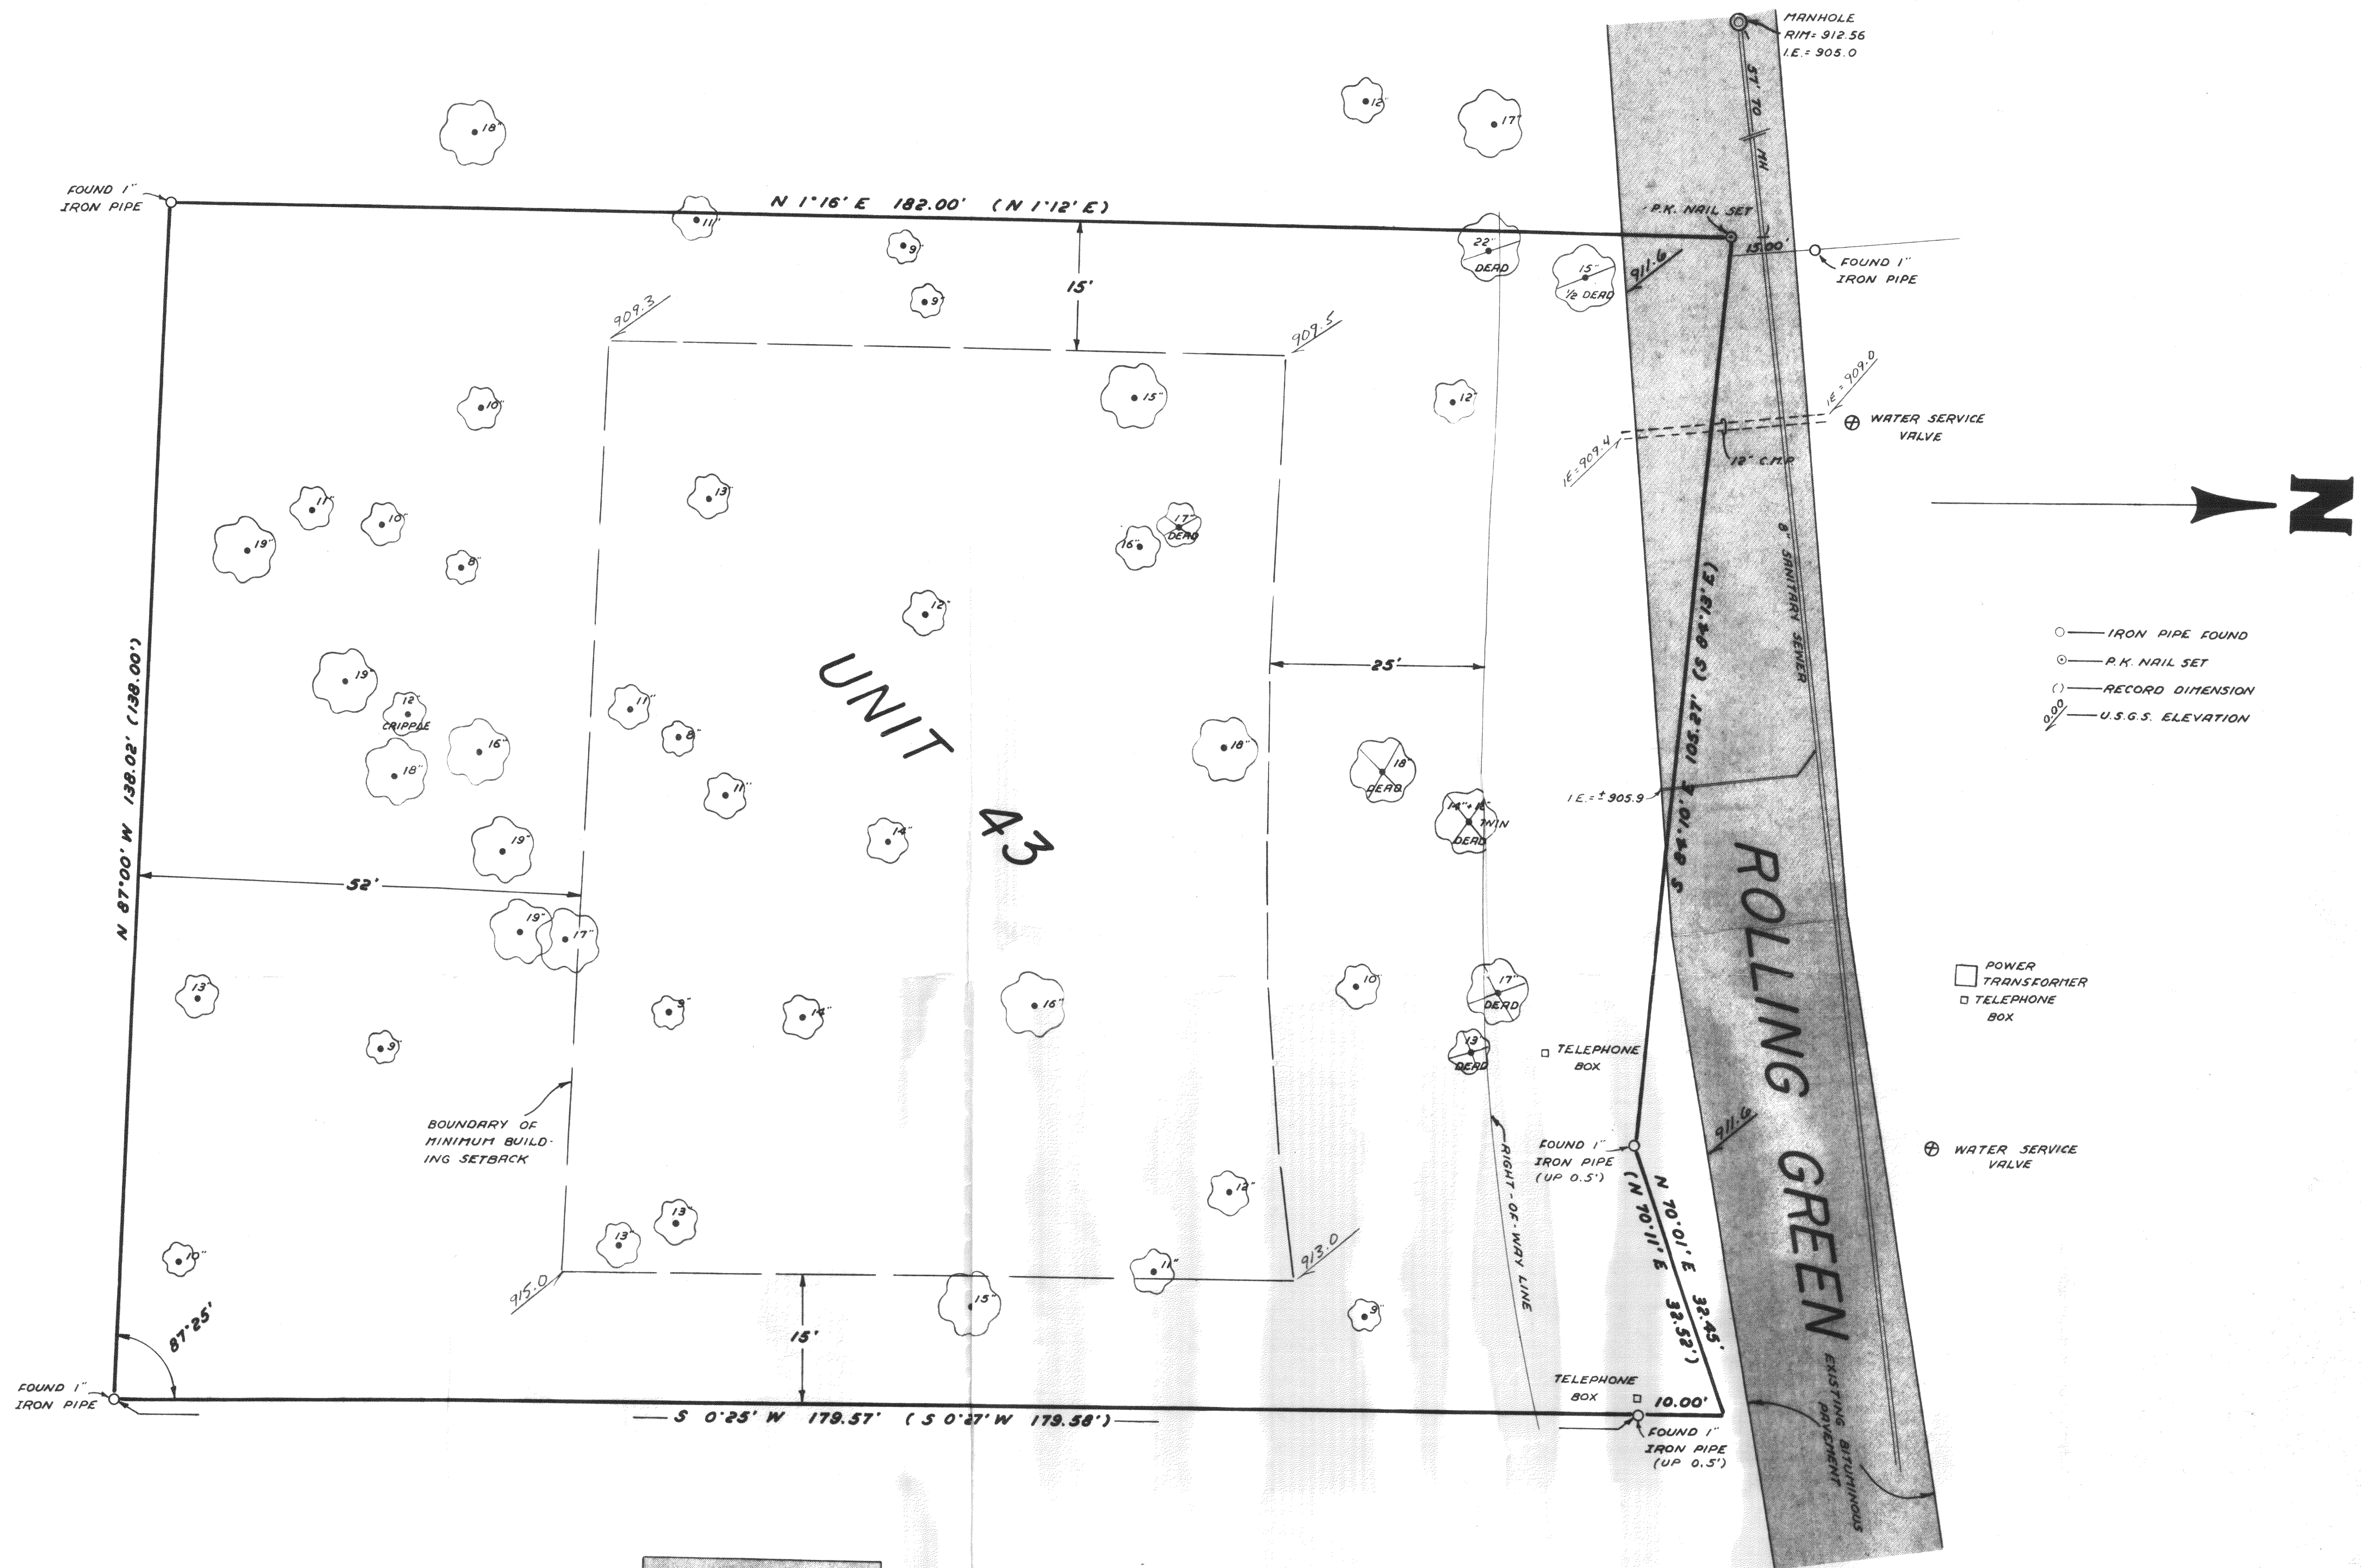

I HEREBY CERTIFY that I have surveyed the lands described herein and that this Plat of Survey is a true and accurate representation of the unit lines and improvements shown to the best of my professional knowledge and belief.

William R. Ohberg
 William R. Ohberg
 Wisconsin Registered Land Surveyor, S-1679
 Dated this 18th day of March, 1982

EXISTING RESIDENCE
 FIRST FLOOR EL.
 916.1

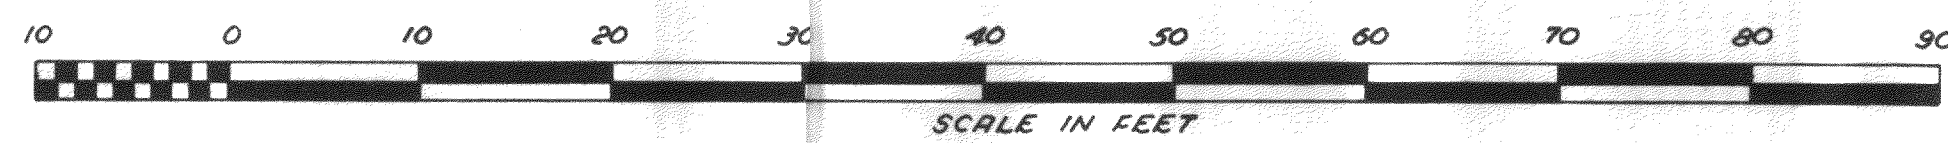


NOTE: The south line of unit 43 of Abbey Springs is assumed to bear N 87° 00' W.

LEGAL DESCRIPTION: A parcel of land located in the South 1/2 of Section 13, Town 1 North, Range 16 East, Village of Fontana - on Geneva Lake, Walworth County, Wisconsin, being more particularly described as follows:

Beginning at the Southwest corner of unit 43 of Abbey Springs; thence N 1° 16' E 182.00 feet; thence S 84° 10' E 105.27 feet; thence N 70° 01' E 32.45 feet; thence S 0° 25' W 179.57 feet; thence N 87° 00' W 138.02 feet to the point of beginning; containing 0.5654 acres more or less.

WORK ORDERED BY: Don Stoltenberg
 Stoltenberg - Ross, Inc.
 8216 W. Oakton Street
 Niles, IL 60648

DATE	DRAWN BY	REVISIONS	BY	DATE
MARCH 18, 1982	R. SPEARMAN			
	CHECKED BY			
	W. OHBERG			
SCALE	APPROVED BY			
1" = 10'	R. FARRIS			

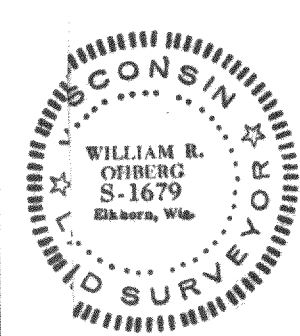

FARRIS, HANSEN & COOPER, INC.

ENGINEERING, SURVEYING & LAND PLANNING

715 W. WALWORTH ST. - BOX 487 - ELKHORN, WI 53121
 PHONE: 414-723-2098

PLAT OF SURVEY OF
 UNIT 43 OF ABBEY SPRINGS
 A SINGLE FAMILY CONDOMINIUM UNIT

PROJECT NO.
 1920

SHEET NO.
 1 OF 1

5-565F