


MAPLE AVENUE

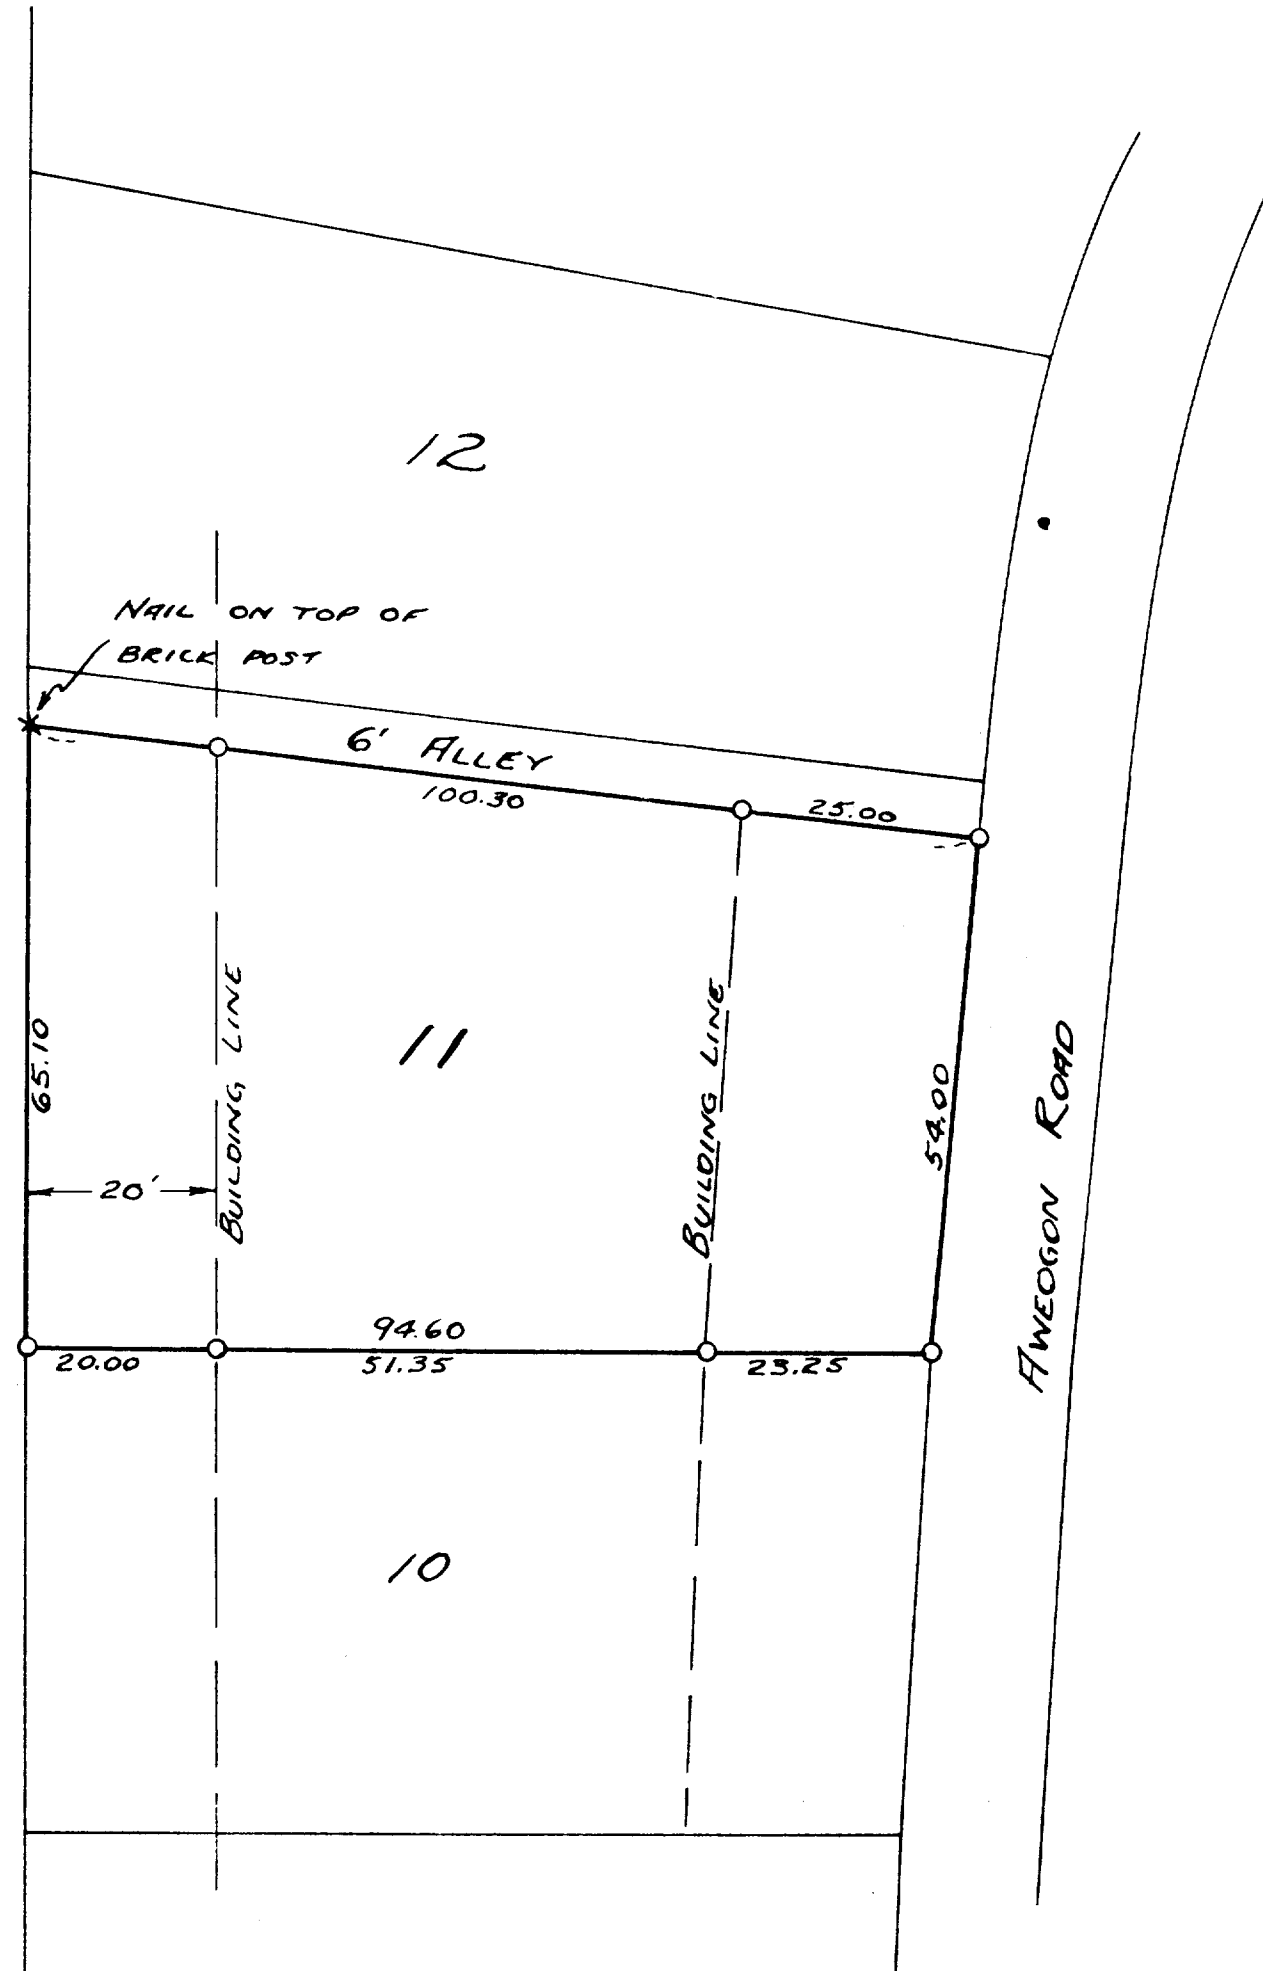

SCALE ~ 1" = 20'
O = IRON PIPE

PLAT OF SURVEY OF LOT 11, BLOCK I OF
INDIAN HILLS IN THE VILLAGE OF FONTANA-
ON - GENEVA LAKE, WALWORTH COUNTY, WIS.

MAY 1949

H. E. Johnson
SURVEYOR

5-56J

SIH-11