


DUNHAM SURVEYING, S.C.
SURVEYING & SUBDIVIDING
DELAVER, WISCONSIN 53115

N

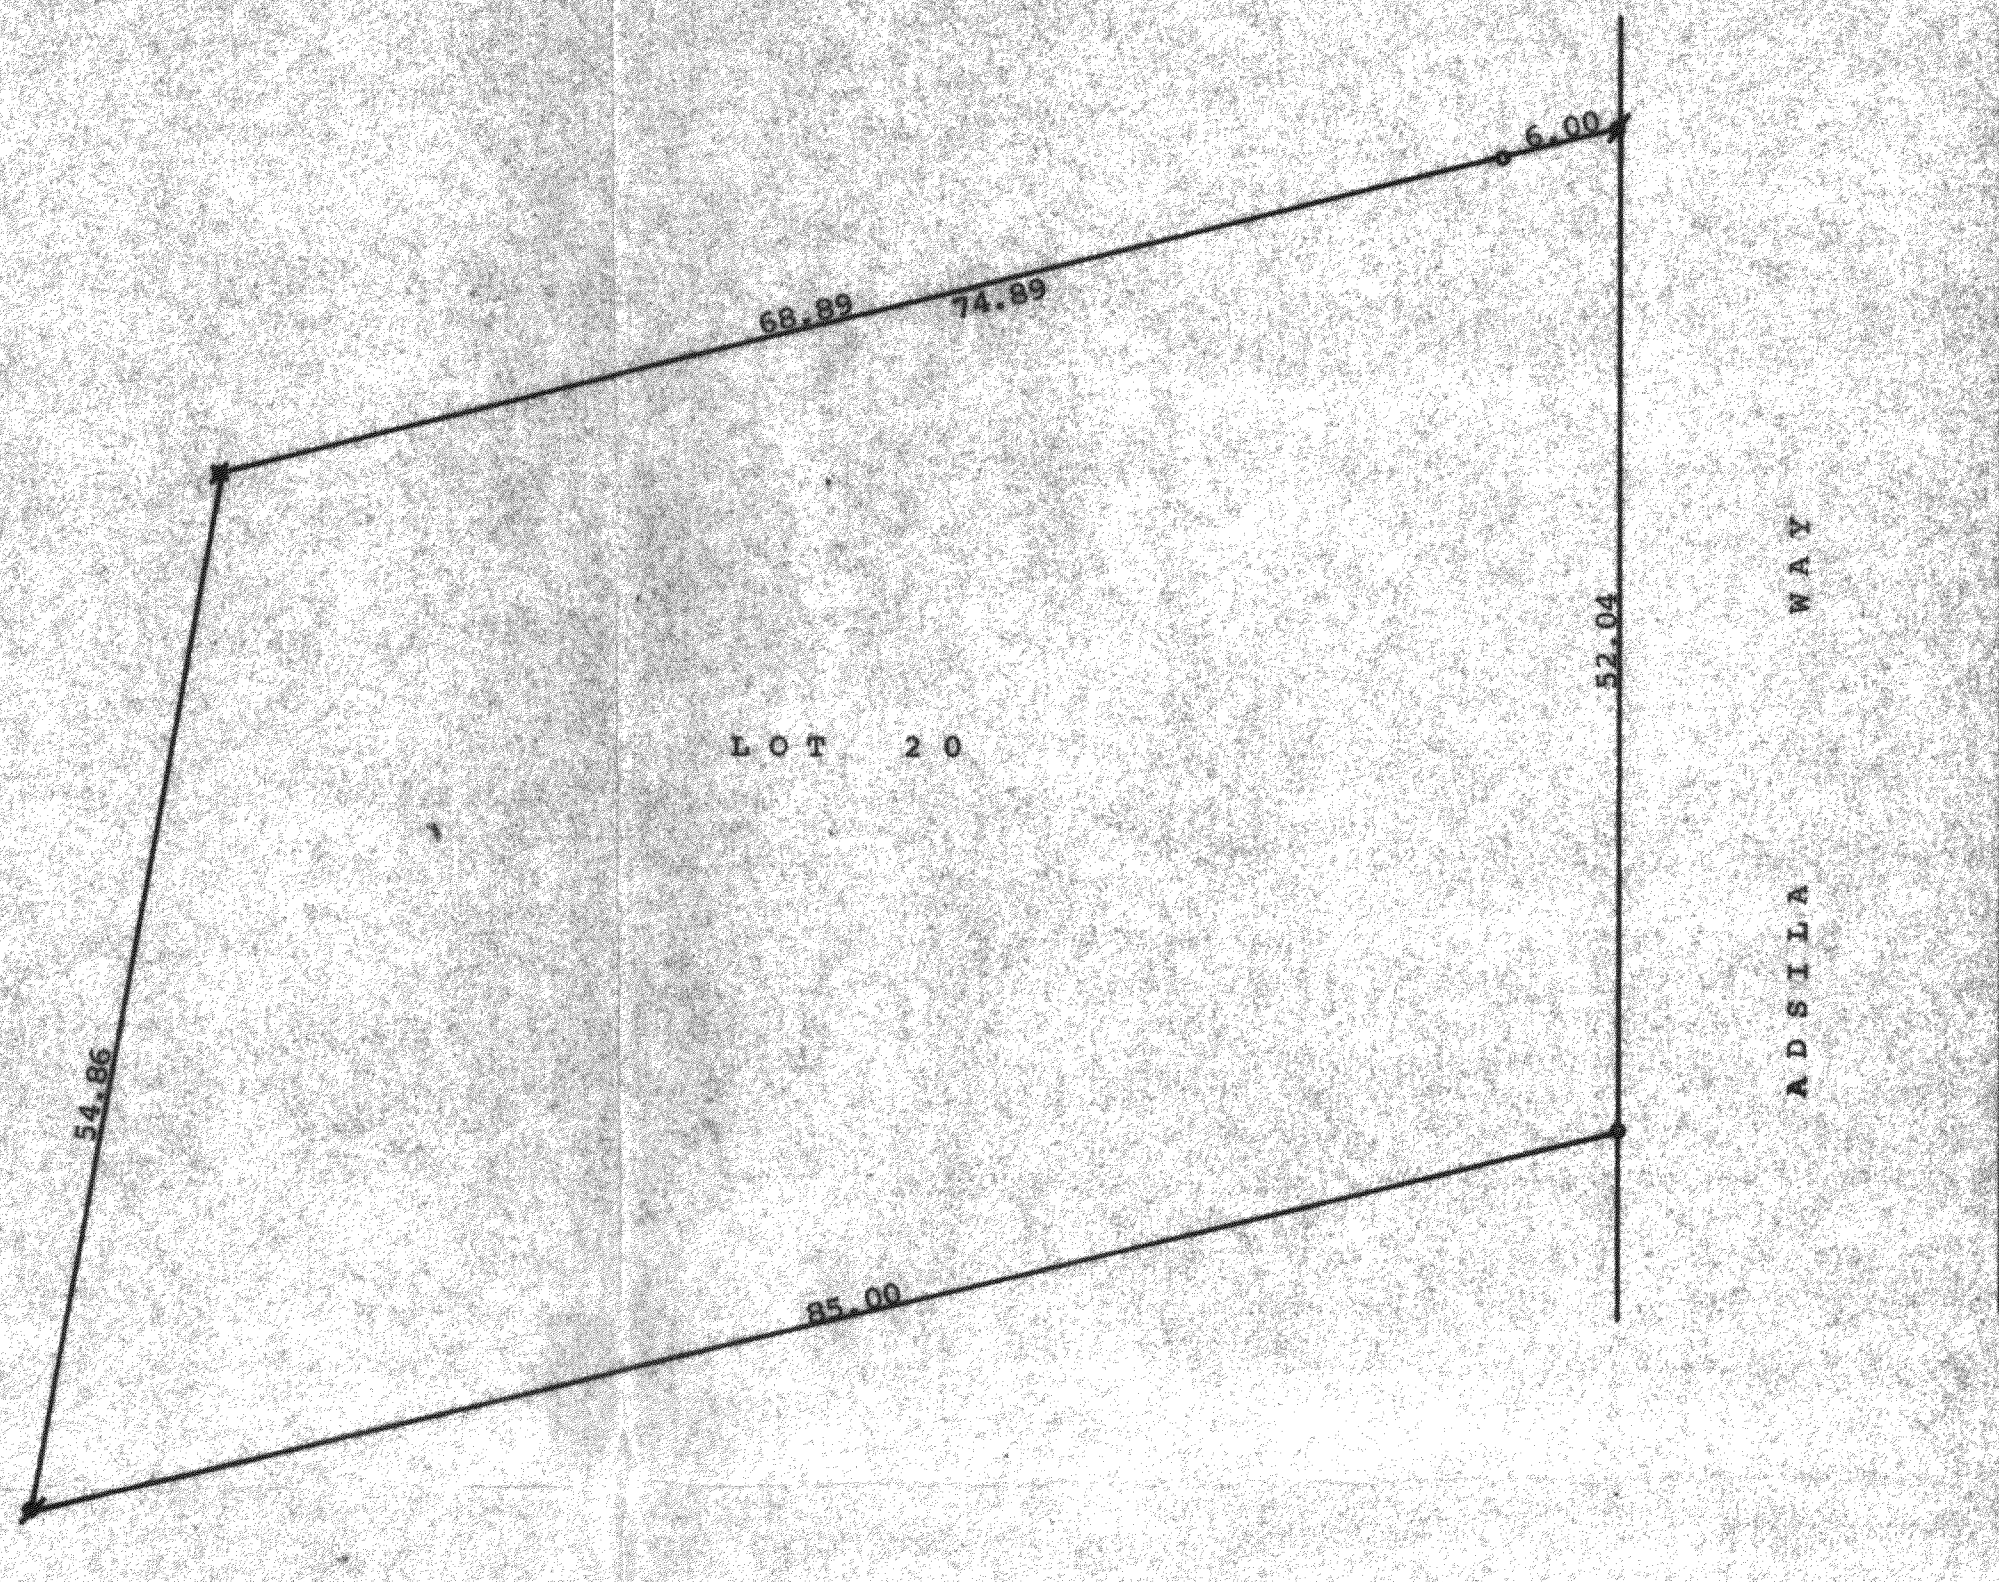

Scale - 1" = 10'
o = Iron Pipe Set
/ = Iron Pipe Found Bent.
Reset correctly
= Rust Mark Found. Set
Iron Pipe
M = Spike Found. Iron Pipe Set

STATE OF WISCONSIN)
COUNTY OF WALWORTH) SS

I, James M. Dunham, Surveyor, certify that I have surveyed
the property described as follows:

Lot 20, Block 5, Indian Hills 1st Addition, located in the
Village of Pontana, Walworth County, Wisconsin,
and that the above map is a true representation thereof and shows the
size and location of the property, its exterior boundaries, the location
of all visible structures and dimensions of all principal buildings
thereon, boundary fences, apparent easements, roadways and visible
encroachments, if any.

This survey is made for the use of the present owners of the property, and
also those who purchase, mortgage, or guarantee the title thereto within
one (1) year from date hereof.
September 5, 1979

James M. Dunham
James M. Dunham, Surveyor

