

FARRIS, HANSEN & COOPER, INC.
ENGINEERING, SURVEYING AND LAND PLANNING
715 W. WALWORTH ST. - P.O. BOX 487 - ELKHORN, WI 53121

LEGEND

- - Iron Pipe Found
- - 1" Dia. x 24" Iron Pipe Set
- () - Record Dimension


PLAT OF SURVEY OF

LOT 5, BLOCK 2, BROOKWOOD SUBDIVISION, LOCATED IN SECTION 18, TOWN 1 NORTH, RANGE 17 EAST, VILLAGE OF FONTANA-ON-GENEVA-LAKE, WALWORTH COUNTY, WISCONSIN.

SELLER: Mr. Scofield

BUYER: Ron Frankel


ORDERED BY: Joan Freitag
Rich Port Realty

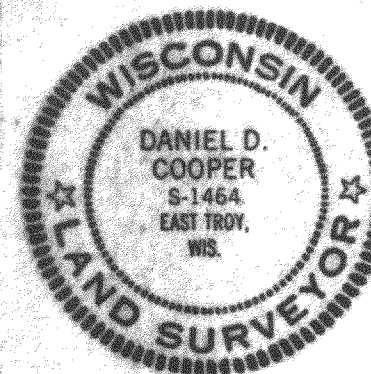


I hereby certify that I have surveyed the above described property and that the map hereon is a true representation thereof and shows the size and location of the property, its exterior boundaries, the location of all visible structures and dimensions of all principal buildings thereon, boundary fences, apparent easements, roadways and visible encroachments, if any.
This survey is made for the use of the present owners of the property, and also those who purchase, mortgage, or guarantee the title thereto within one (1) year from date hereof.

Daniel D. Cooper
DANIEL D. COOPER, RLS NO. 1464

DATED THIS 9 DAY OF JAN 1980.

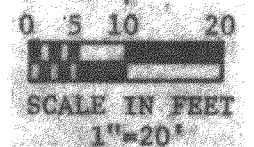

LAKELAND DRIVE - 66' WIDE

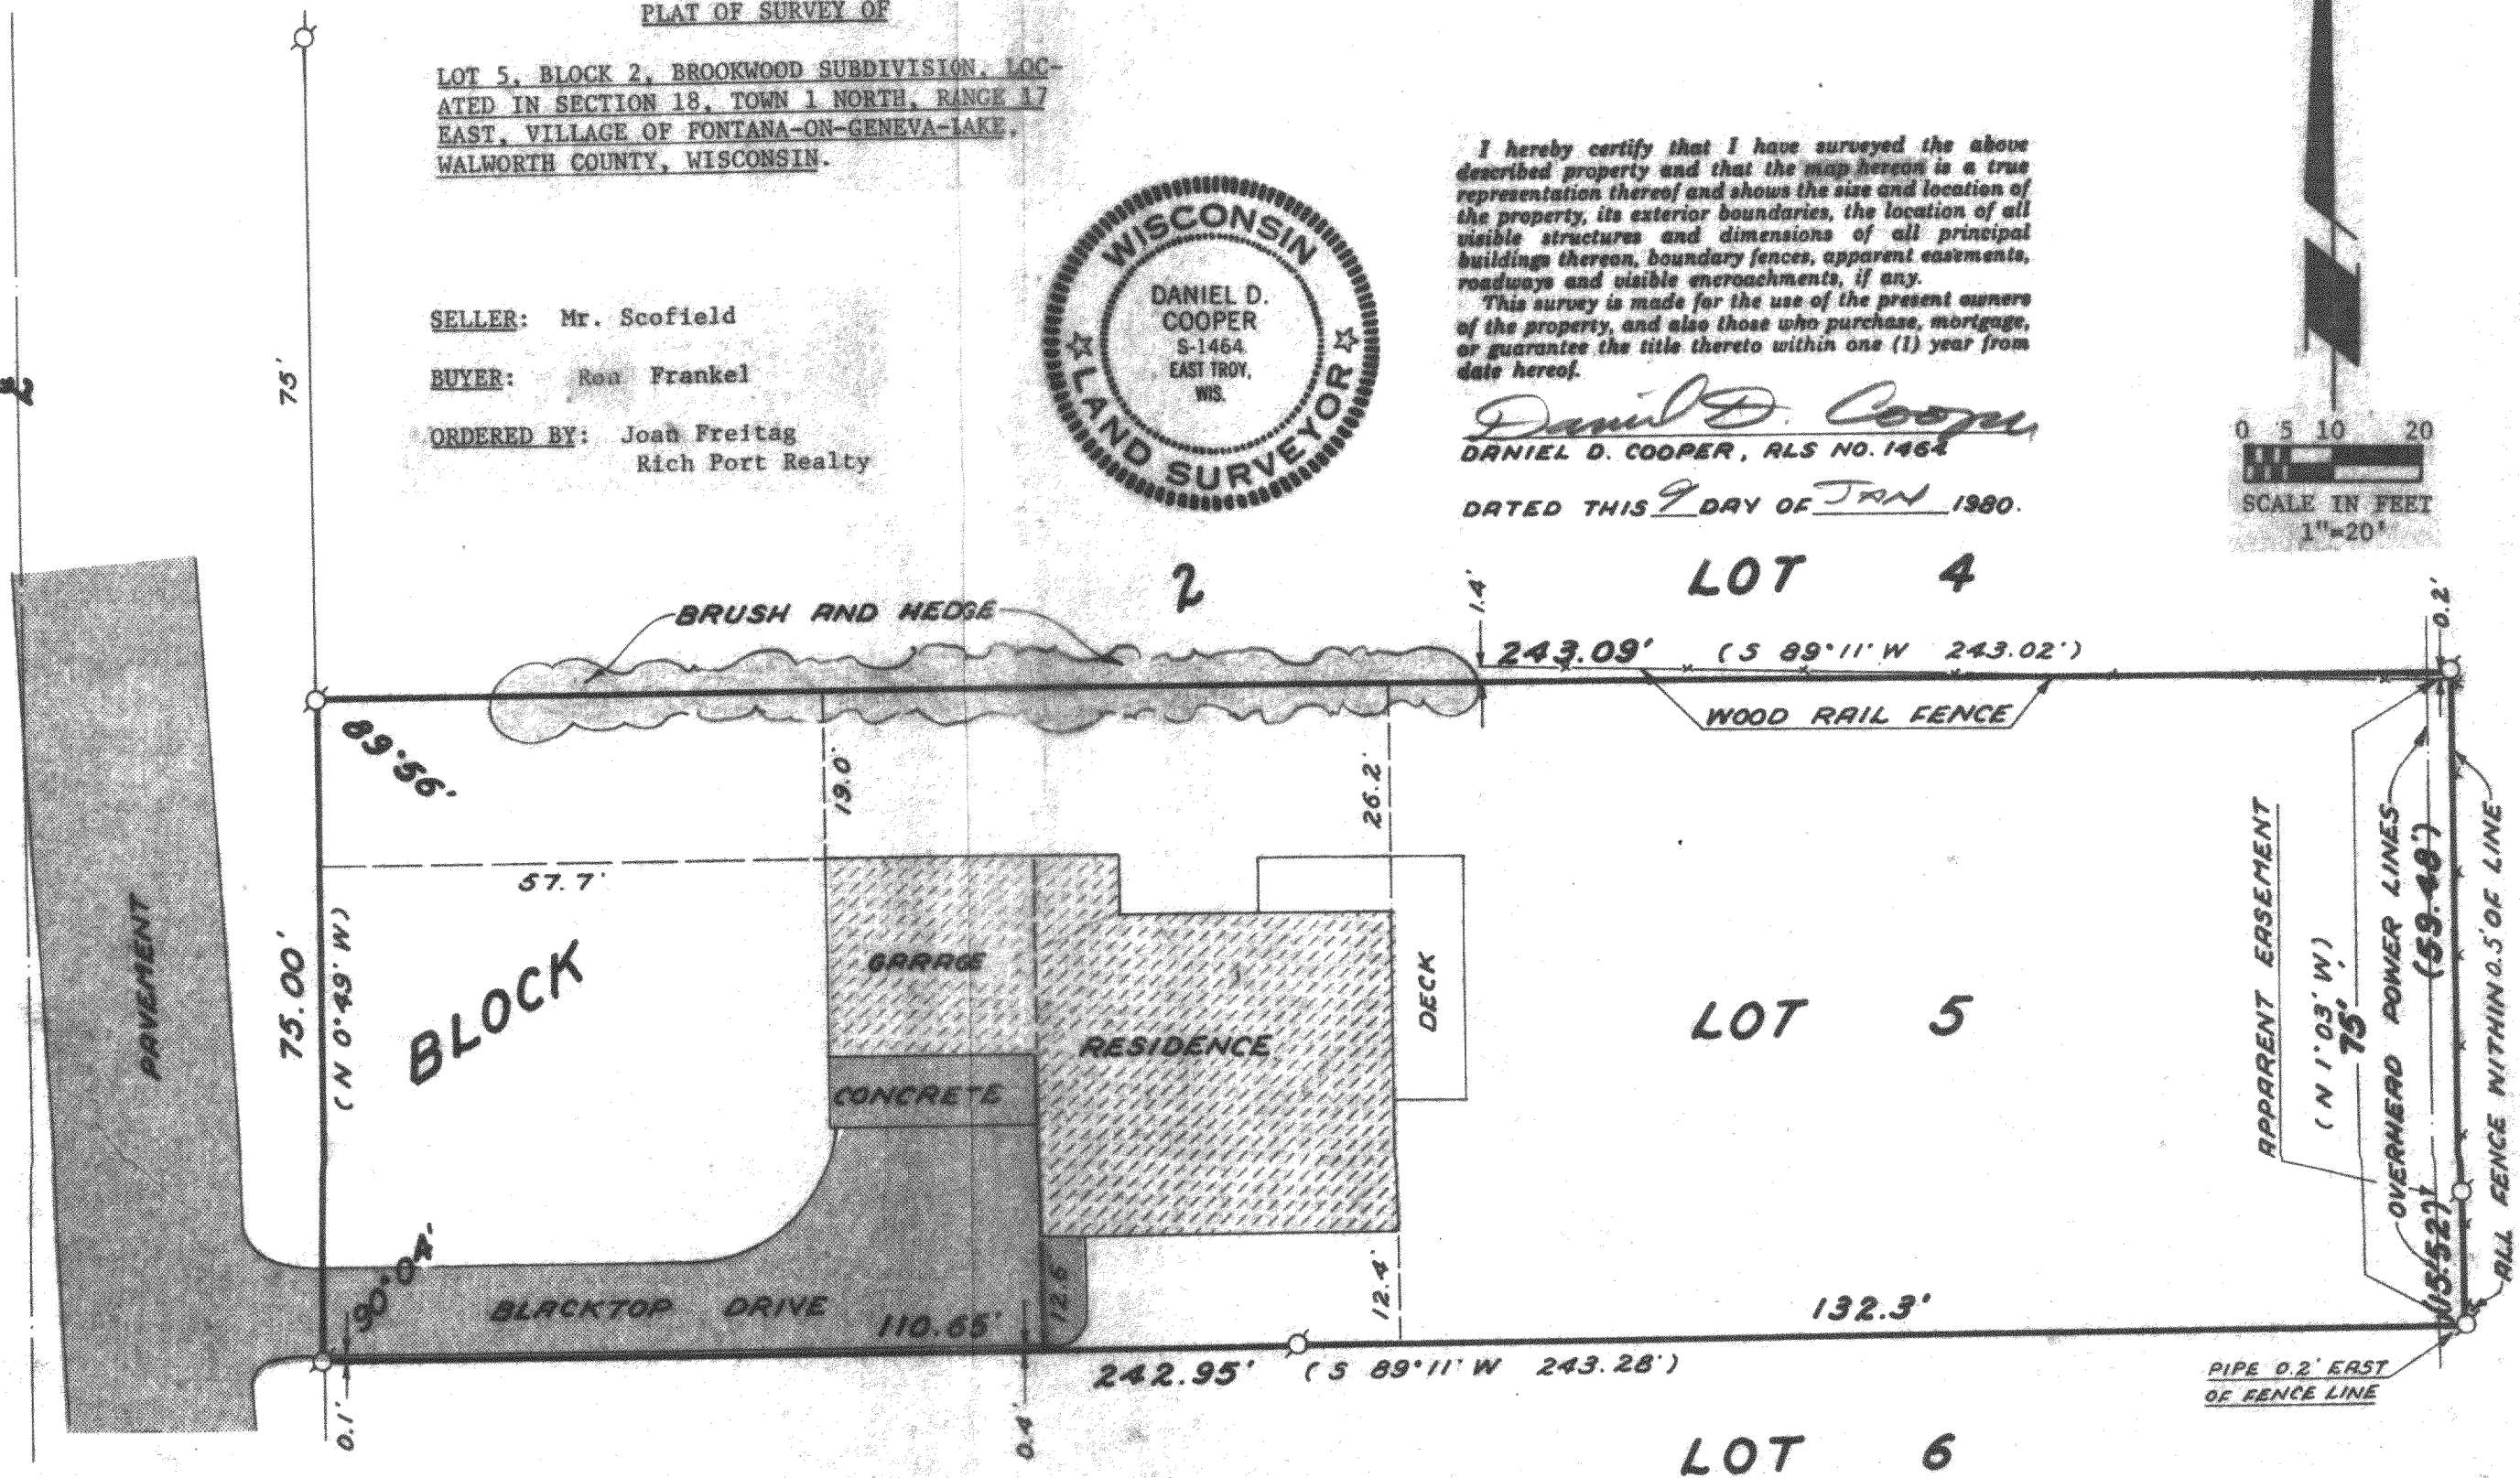

NOTE: REVISED CERTIFICATE ON 9, JAN. 1980
ACTUAL SURVEY DONE ON 21, SEPT 1979

ORIGINAL SURVEY: 21 SEPT. 1979
PROJECT NO. 1605

SB548

5-588