


PLAT OF SURVEY
FOR LOT 4, BLOCK 3 OF THE
ORIGINAL VILLAGE OF FONTANA

1st AVENUE

Parcel 1: Lot Four (4) in Block 3 of the Original Village of Fontana, Wis. a plat of which subdivision of part of Section Fourteen (14) T. 1 N. 37. 16 E. of the 4th P.M. is recorded in the office of the Register of Deeds for Walworth Co., Wis. in Vol. 5 on Page 94, except the North thirty (30) feet

BEARINGS ARE REFERENCED TO THE
OF STH 67 AS SHOWN ON PLAT
OF RIGHT OF WAY REQUIRED MAP WITH
LAST REVISION DATE OF 5/4/71

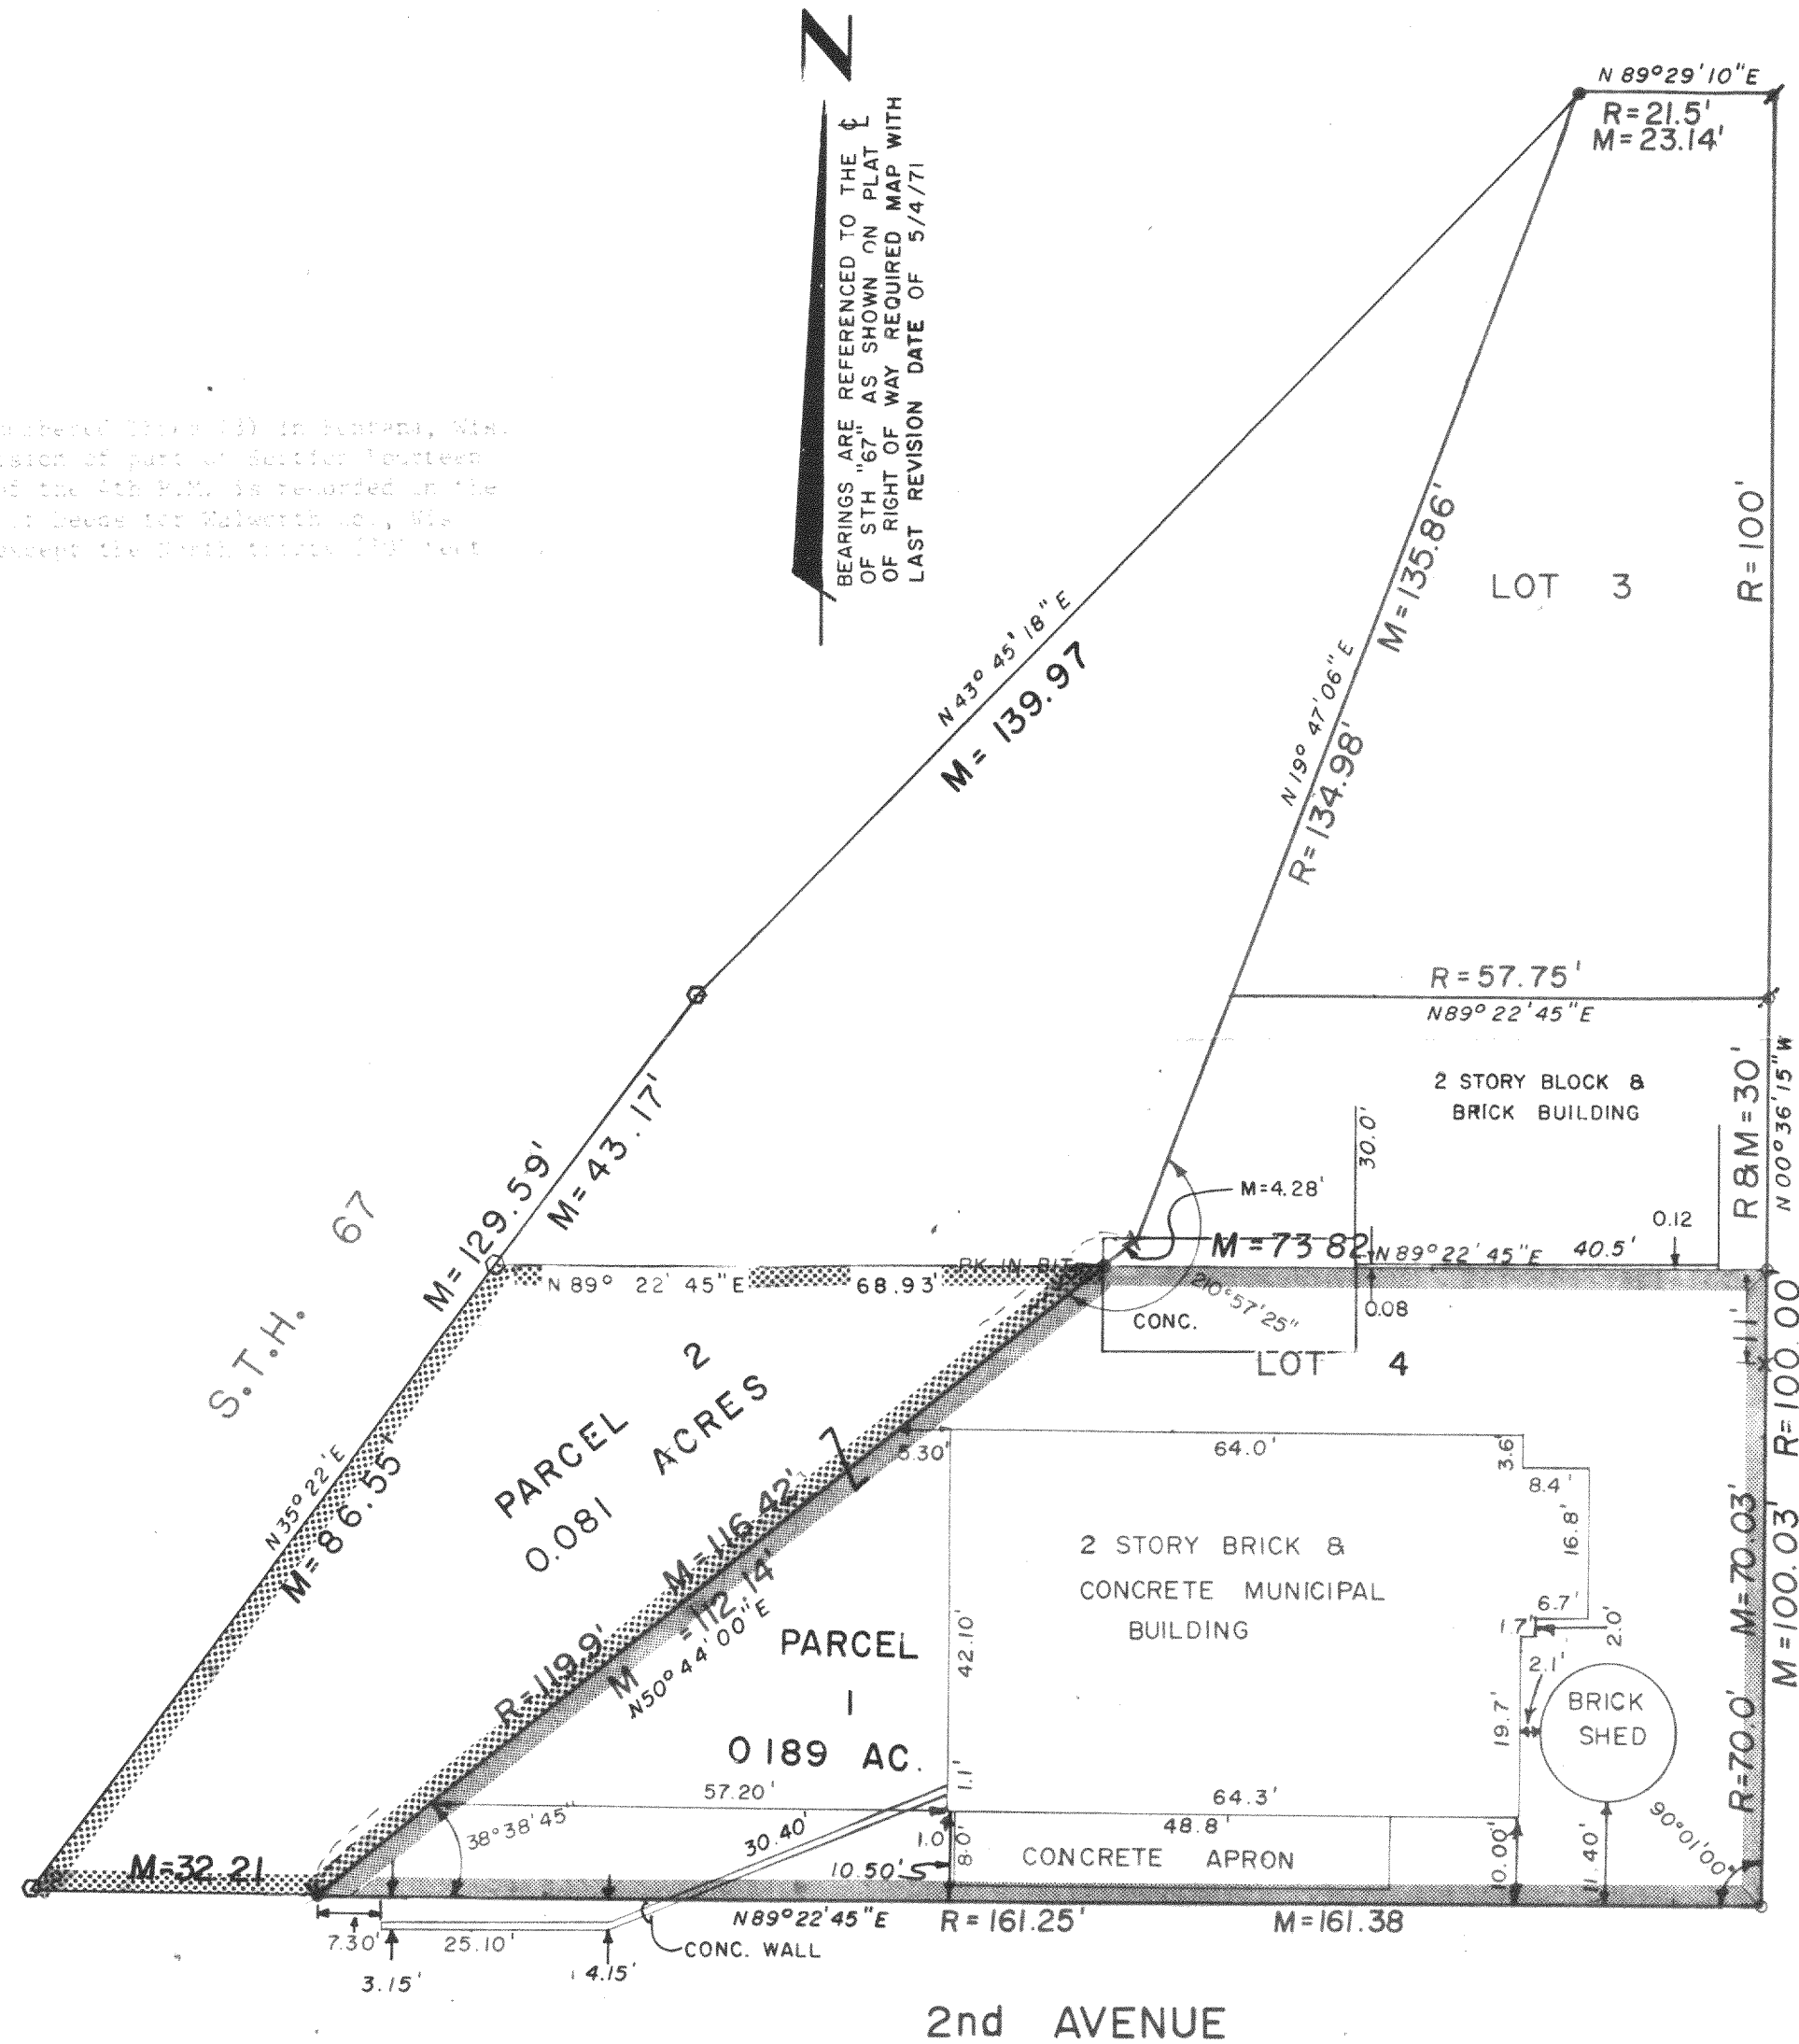

LEGEND

- RR SPIKE SET
- × CUT CROSS
- FOUND IRON ROD
- SET IRON ROD
- FOUND IRON PIPE
- SET PK NAIL
- R-RECORDED
- M-MEASURED

SURVEYORS CERTIFICATE

I, Robert S. Johnson, Surveyor, do hereby certify that the plat shown hereon is a true and accurate representation thereof and the exterior boundary lines and all divisions of said property have been surveyed under my direction and to the best of my knowledge and belief.


Dated this _____ day of _____, 1980.

Robert S. Johnson, R.L.S. 7513

DATE MARCH, 1980

DRAWN BY D. W. DAVIS

CHECKED BY

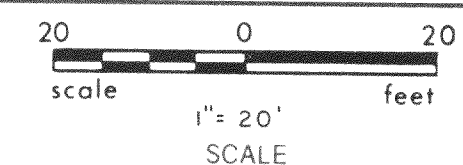

NO.	REVISIONS	DATE

donohue & associates inc.
CONSULTANTS • ENGINEERS • PLANNERS • ARCHITECTS

ES 180

5-591

City Hall