


DUNHAM SURVEYING, S.C.
SURVEYING & SUBDIVIDING
DELAVER, WISCONSIN 53115

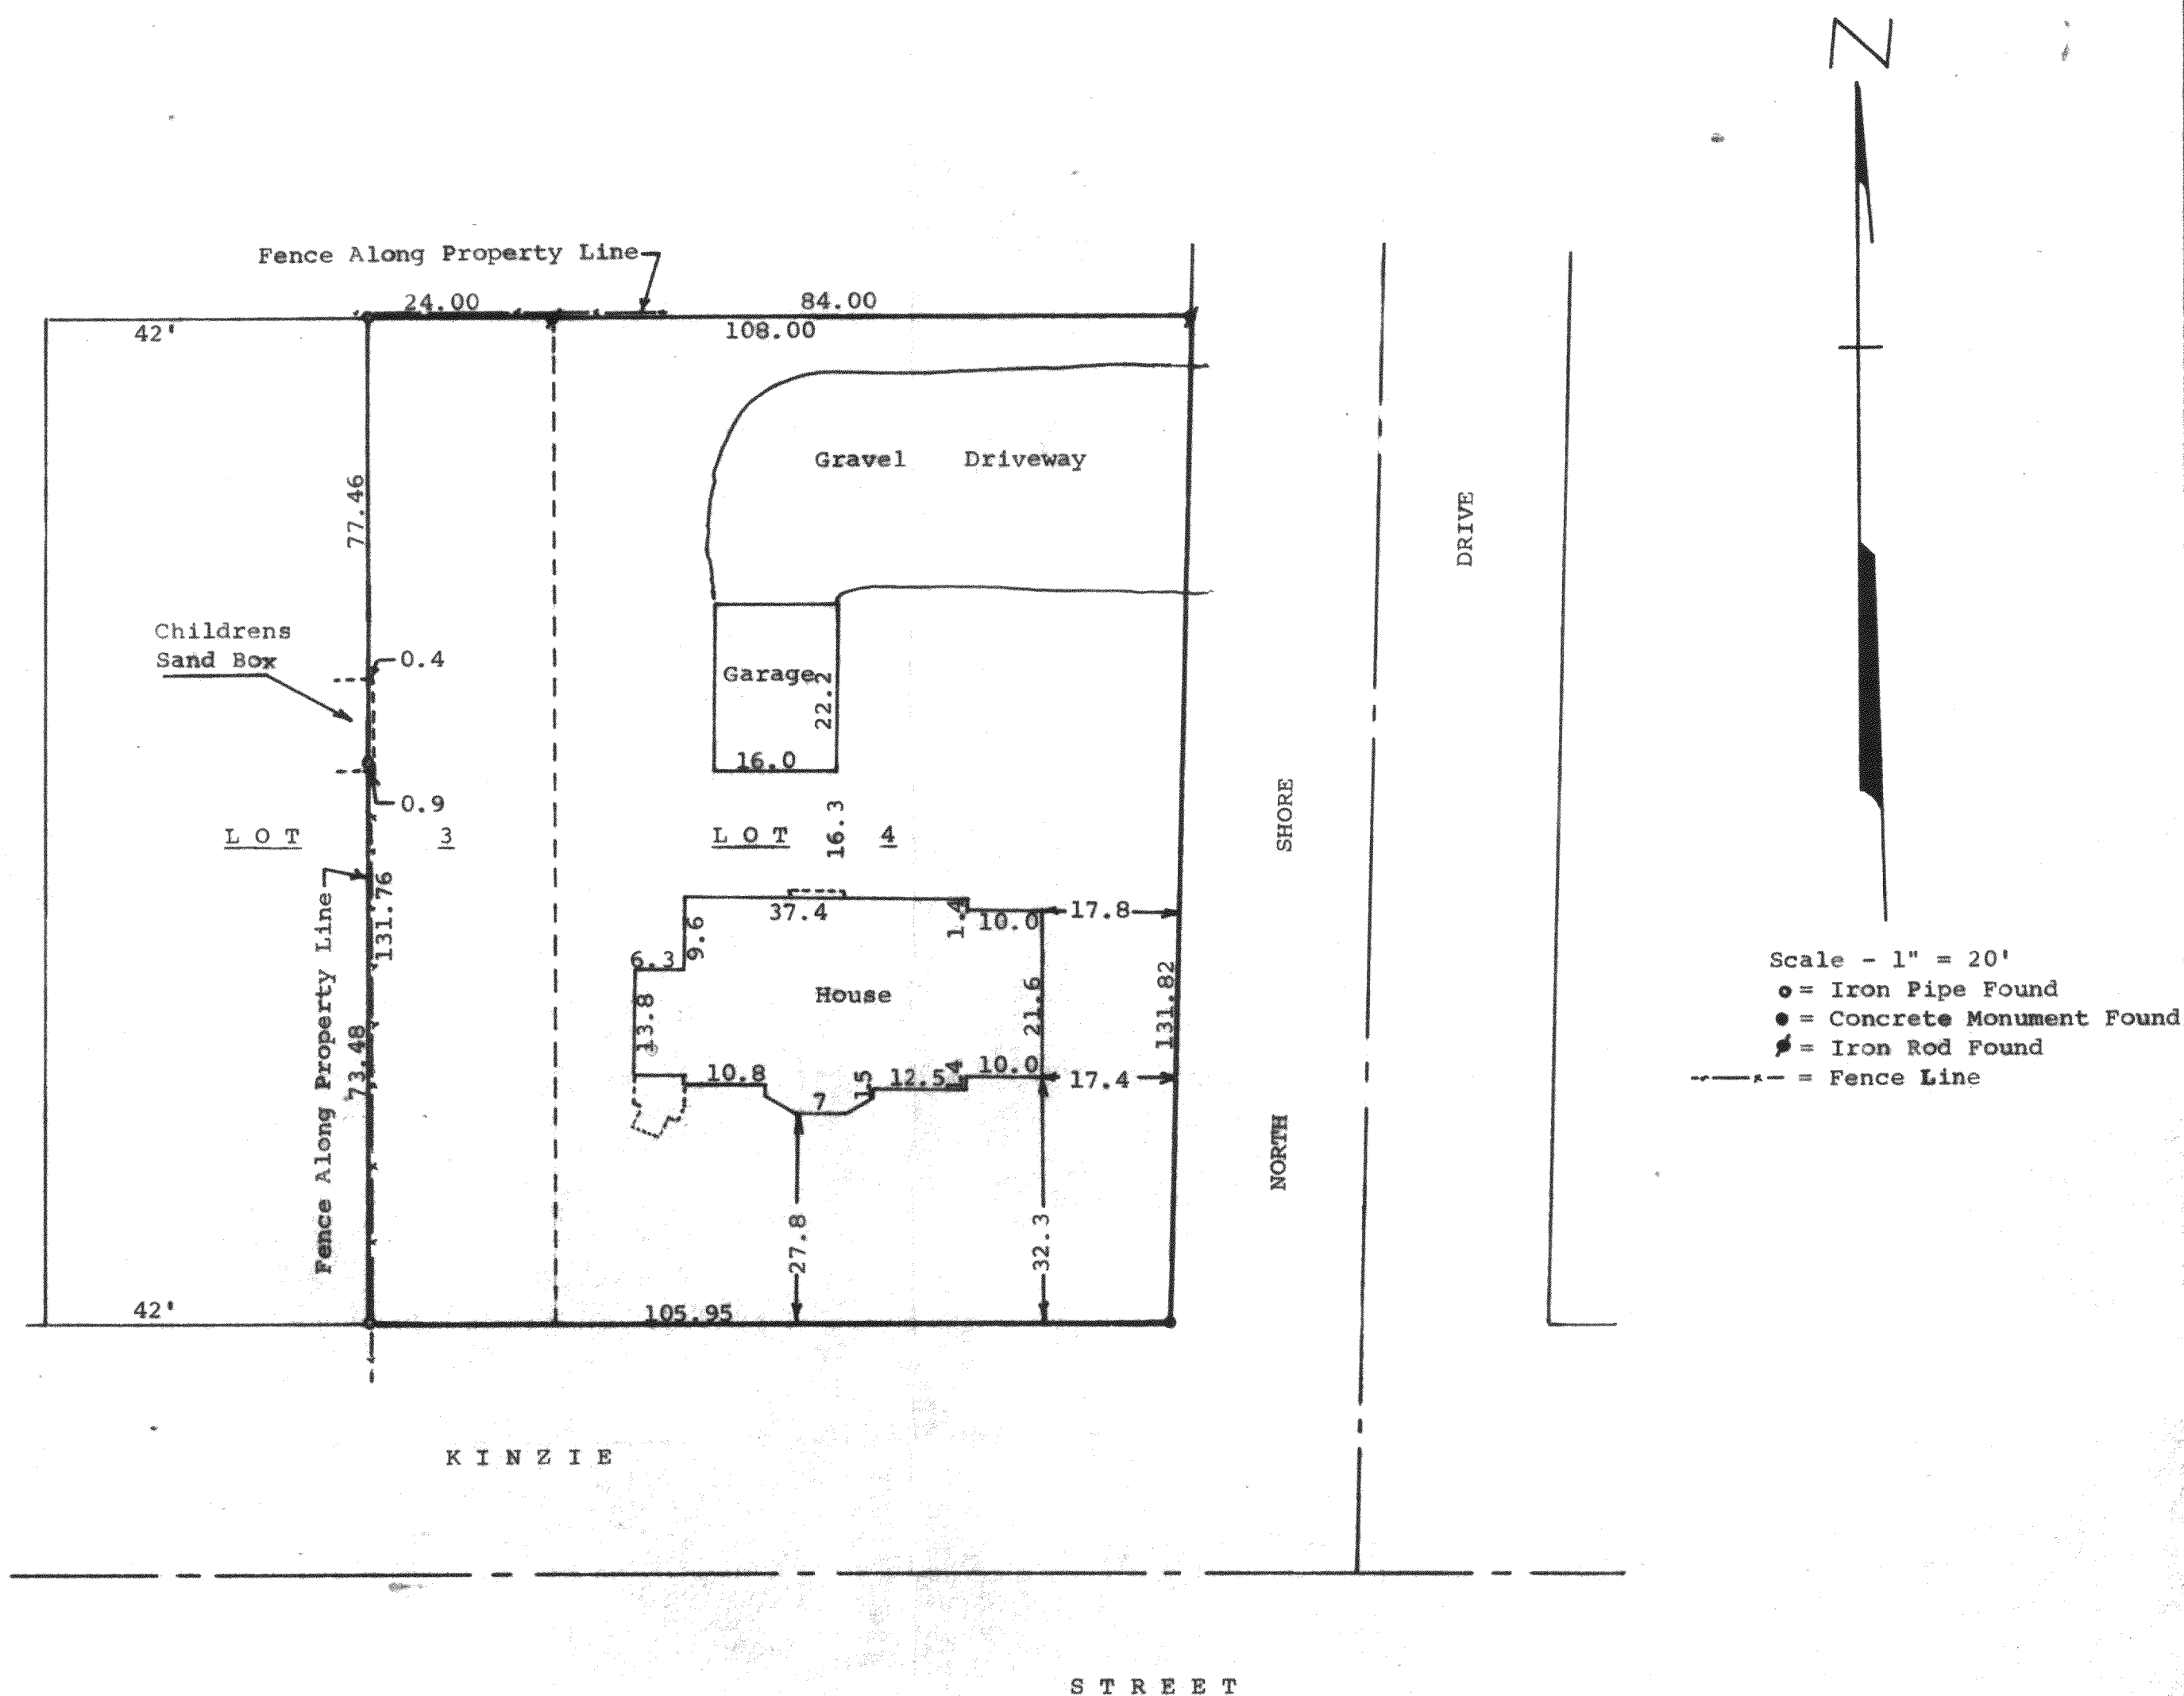

STATE OF WISCONSIN)
COUNTY OF WALWORTH) SS

I, George T. Dunham, Surveyor, certify that I have surveyed the property described as follows:

Lot 3 except the West 42 feet thereof and all of Lot 4, Block 12, Original Plat of the Village of Pontana-on-Geneva Lake, Walworth County, Wisconsin, recorded in the Office of the Register of Deeds in and for said County in Volume 5 of Plats on Page 258.

and that the above plat is a true representation thereof and shows the size and location of the property, its exterior boundaries, the location of all visible structures and dimensions of all principal buildings thereon, boundary fences, apparent easements, roadways and visible encroachments, if any.

This survey is made for the use of the present owners of the property, and also those who purchase, mortgage, or guarantee the title thereto within one (1) year from date hereof.

July 18, 1981

George T. Dunham
George T. Dunham, Surveyor

