


FARRIS, HANSEN & COOPER, INC.

ENGINEERING, SURVEYING AND LAND PLANNING
715 W. WALWORTH ST. - P.O. Box 487 - ELKHORN, WI 53121

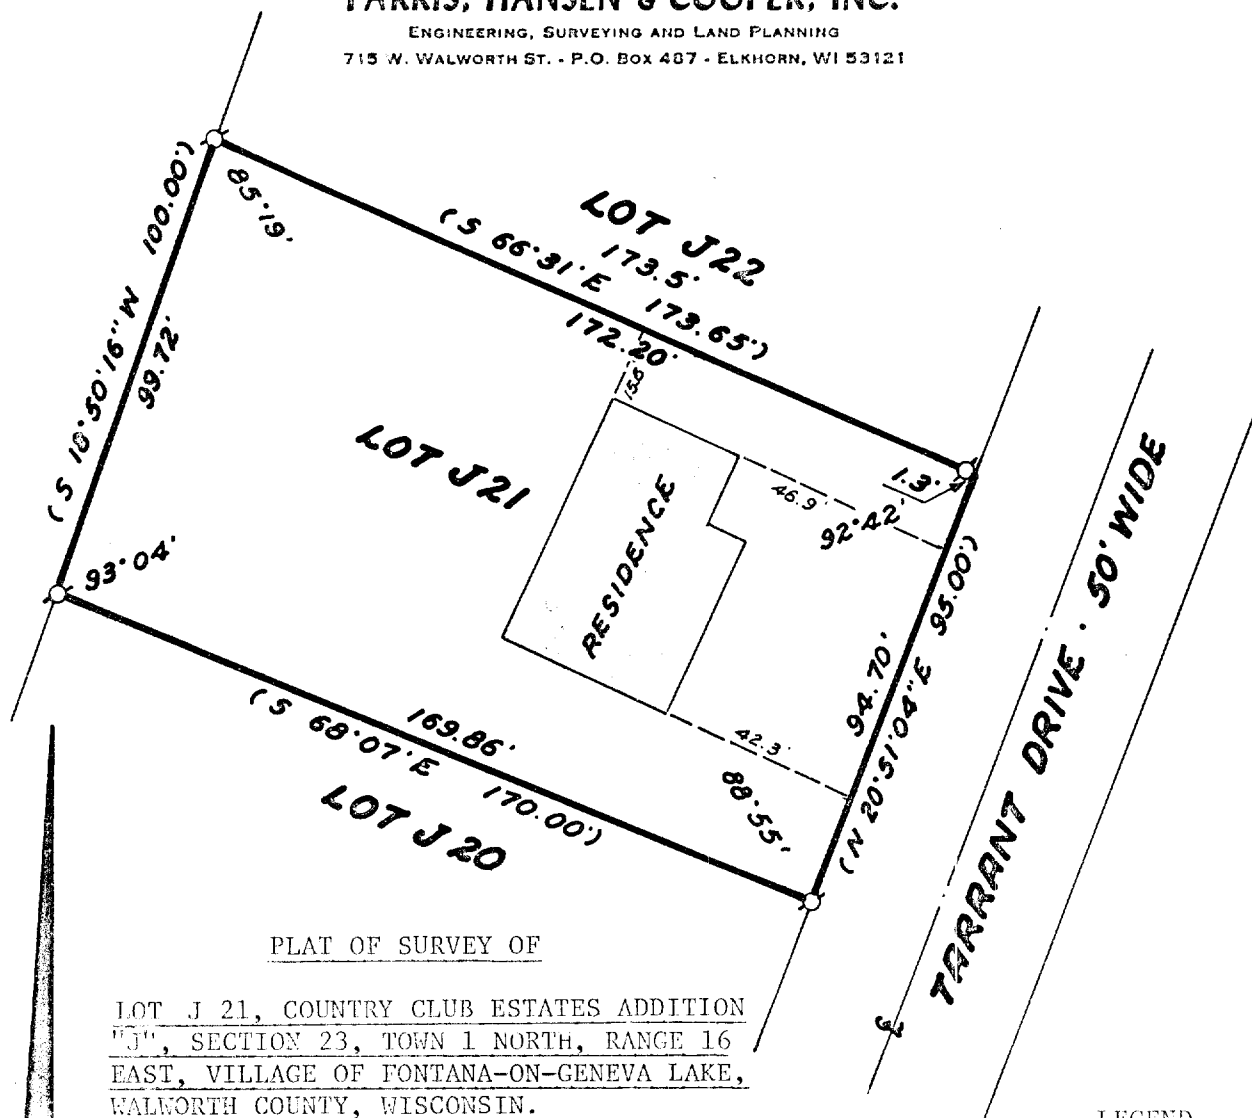

PLAT OF SURVEY OF

LOT J 21, COUNTRY CLUB ESTATES ADDITION
 "J", SECTION 23, TOWN 1 NORTH, RANGE 16
 EAST, VILLAGE OF FONTANA-ON-GENEVA LAKE,
 WALWORTH COUNTY, WISCONSIN.

LEGEND


Ø- Iron Pipe Found
 ()- Record Dimension

ORDERED BY: R & D Builders

0 10 20 40

SCALE IN FEET

1"=40'

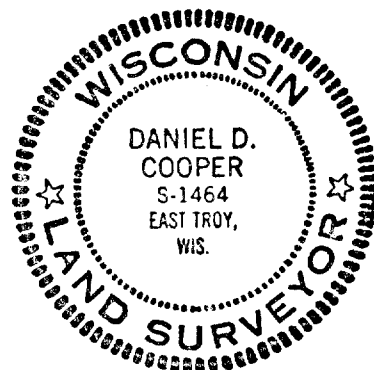

I HEREBY CERTIFY that I have surveyd the property described hereon and that this Plat of Survey is a true and accurate representation of the lot lines and building thereon to the best of my professional knowledge and belief.

Daniel D. Cooper
 Daniel D. Cooper, RLS No. S-1464

Dated this 12 day of Dec., 1979.

PROJECT NO. 1654

5-594 ✓