


FARRIS, HANSEN & COOPER, INC.

ENGINEERING, SURVEYING AND LAND PLANNING
715 W. WALWORTH ST. - P.O. Box 487 - ELKHORN, WI 53121

- ⊙ - Found Iron Pipe Survey Stake
- - Found Iron Rod Survey Stake
- - Set Iron Pipe Survey Stake

NOTE: The southerly line of Lot 10, Block 13, is assumed to bear "EAST".

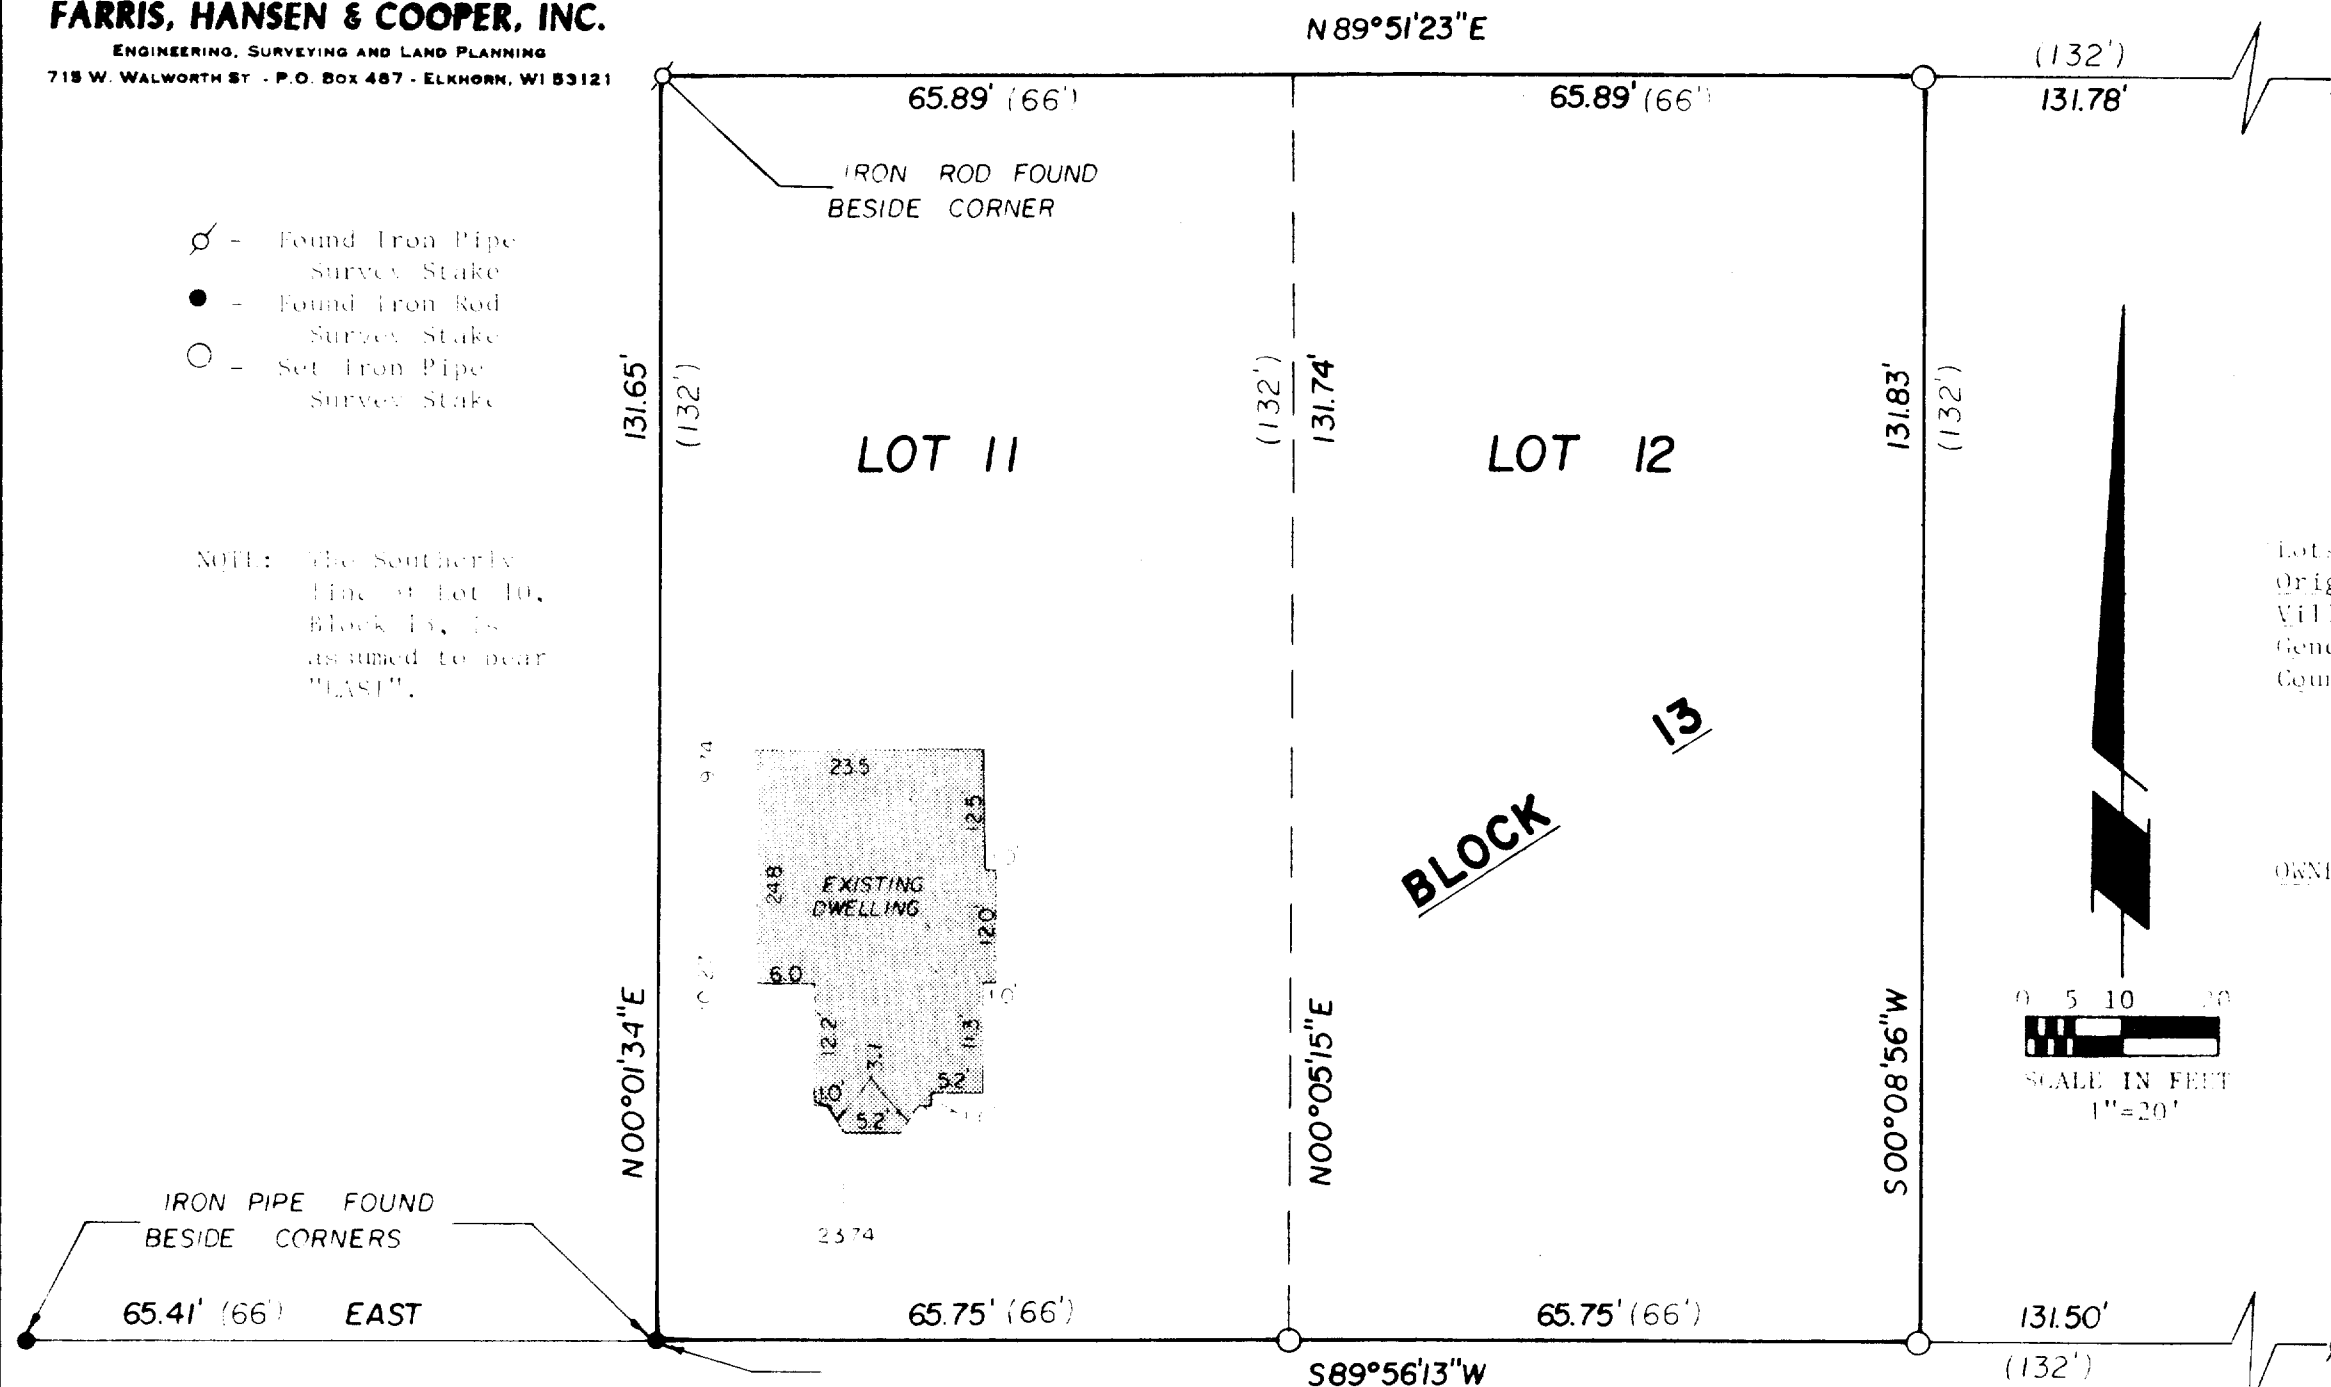


PLAT OF SURVEY OF
Lots 11 and 12, Block 13,
Original Plat of the
Village of Fontana-on-
Geneva Lake, Walworth
County, Wisconsin.

OWNER: Stewart Mathison
Lake Geneva, WI

0 5 10 20
SCALE IN FEET
1"=20'

KINZIE ST.
(1ST AVE)

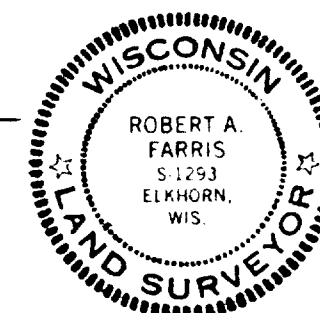

I HEREBY CERTIFY that I
have surveyed the pro-
perty described hereon
and that this Plat of
Survey is a true and
accurate representation
of the lot lines, and
building thereon, to the
best of my professional
knowledge and belief.

Robert A. Farris
Robert A. Farris, RLS-1293

Dated this 8th day of July, 1980