


DUNHAM SURVEYING, S. C.

SURVEYING & SUBDIVIDING
DELAVER, WISCONSIN 53115

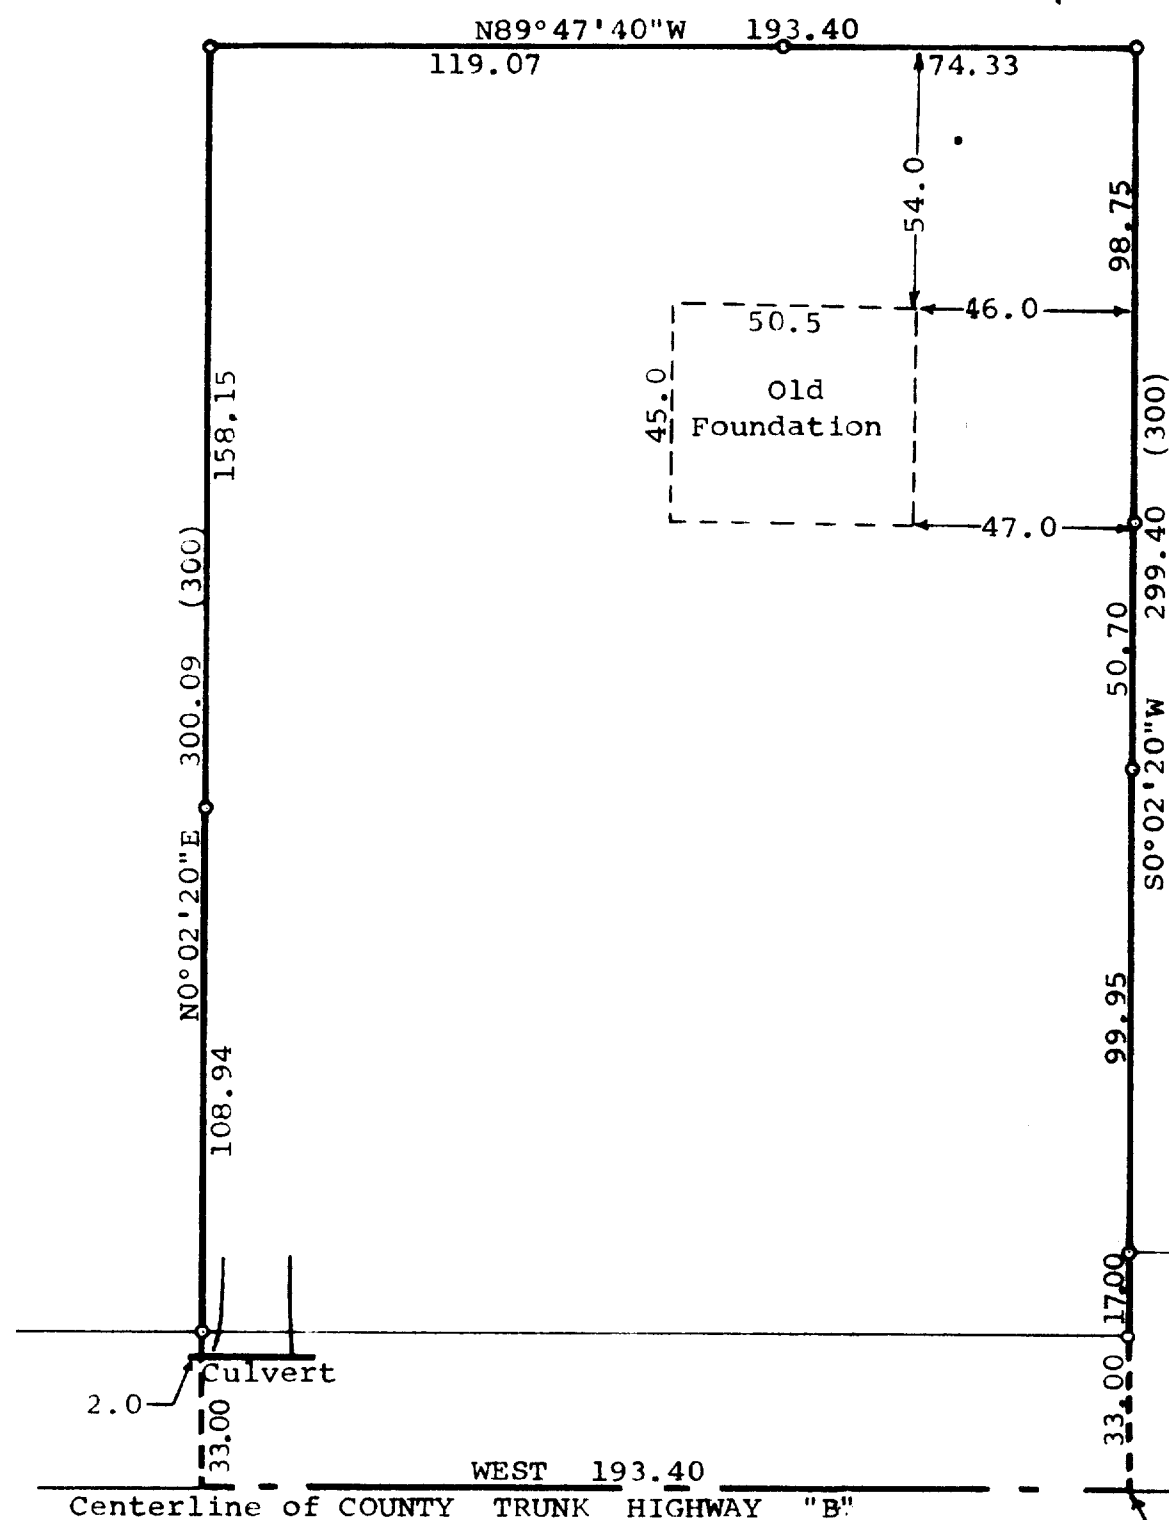

Scale - 1" = 40'
 o = Iron Pipe Found
 (0.00) = Recorded Distance
 Note: Bearings referenced to the
 centerline of County Trunk Highway "B"
 assumed East-West.
 Survey Ordered By: The Rauland Agency
 118 Kenosha Street
 Walworth, Wisconsin 53184

STATE OF WISCONSIN)
 COUNTY OF WALWORTH) SS

I, George T. Dunham, Surveyor, certify that I have surveyed the property described as follows,
 A parcel of land located in the southeast corner of the Southeast 1/4 of the Northwest 1/4 of Section 23, T 1 N, R 16 E, Village of Fontana, Walworth County, Wisconsin, described as follows: Beginning at the southeast corner of the Southeast 1/4 of the Northwest 1/4 of said Section 23; thence West along the 1/4 section line 193.40 feet to a point; thence North 300 feet to the property line of Country Club Estates Golf Course; thence East along said property line 193.40 feet to a point; thence South 300 feet to the place of beginning, and that the above map is a true representation thereof and shows the size and location of the property, its exterior boundaries, the location of all visible structures and dimensions of all principal buildings thereon, boundary fences, apparent easements, roadways and visible encroachments, if any.
 This survey is made for the use of the present owners of the property, and also those who purchase, mortgage, or guarantee the title thereto within one (1) year from date hereof.
 December 14, 1981

George T. Dunham
 George T. Dunham, Surveyor

